

**CHESTER
WILLCOX
&
SAXBE**

Chester Willcox & Saxbe, LLP
65 East State Street, Suite 1000
Columbus, OH 43215

MAIN: 614.221.4000
FAX: 614.221.4012

WWW.CWSLAW.COM

MARK S. YURICK
DIRECT: 614.334.7197
myurick@cwsllaw.com

RECEIVED-DOCKETING DIV

2011 SEP 23 PM 4:08

PUCO

September 23, 2011

Betty McCauley
Chief of Docketing
The Public Utilities Commission of Ohio
180 E. Broad Street, 11th Floor
Columbus, Ohio 43215

Re: In the Matter of the Application of Aqua Ohio, Inc. for Approval to Amend the Certificate of Convenience and Necessity for the Stark Regional Division (Number 32) to Expand the Territory to which Aqua Ohio, Inc.'s Stark Regional Division Provides Water Service.
PUCO Case No. 11-4674-WW-AAC

Dear Ms. McCauley:

Please remove the proposed and redline Section 5, Sheet 1 Territory Maps filed with the Application in the above referenced case on August 9, 2011 and replace with the attached revised proposed and redlined Section 5, Sheet 1 Territory Maps as requested by PUCO Commission Staff.

Do not hesitate to contact me with any questions or concerns. Thank you for your assistance.

Very truly yours,

Mark S. Yurick
Mark S. Yurick

MSY/cl

Attachment


This is to certify that the images appearing are an accurate and complete reproduction of a case file document delivered in the regular course of business.
Technician SW Date Processed SEP 26 2011

Aqua Ohio, Inc.
Stark Regional Division

Section 5
First Revised Sheet No. 2
Canceling Original Sheet No. 2

Deleted: Original

P.U.C.O. TARIFF NO. 1

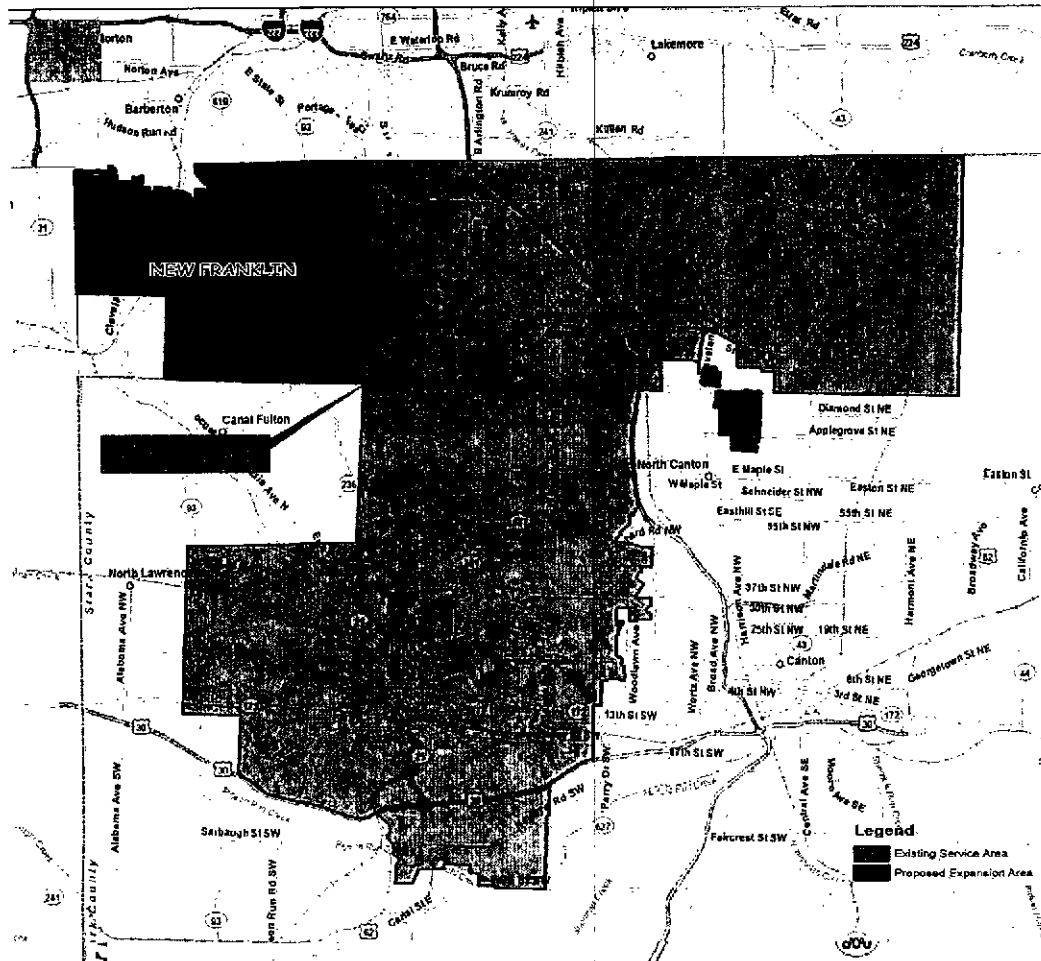

Deleted: September 24, 2003

Deleted: September 24, 2003

Deleted: Walter J. Pishkur

Deleted: Consumers Ohio Water Company

Deleted: D

Deleted: September 18, 2003

Deleted: 02

Deleted: 1082

Deleted: UNC

Issued: _____, 2011

Effective: _____, 2011


Issued by Edmund P. Kolodziej, Jr., President, Aqua Ohio, Inc.
In accordance with the Public Utilities Commission of Ohio
Order dated _____, 2011 for Case No. 11-____-WW-AAC

Aqua Ohio, Inc.
Stark Regional Division

Section 5
First Revised Sheet No. 2
Canceling Original Sheet No. 2

Deleted: Original

P.U.C.O. TARIFF NO. 1

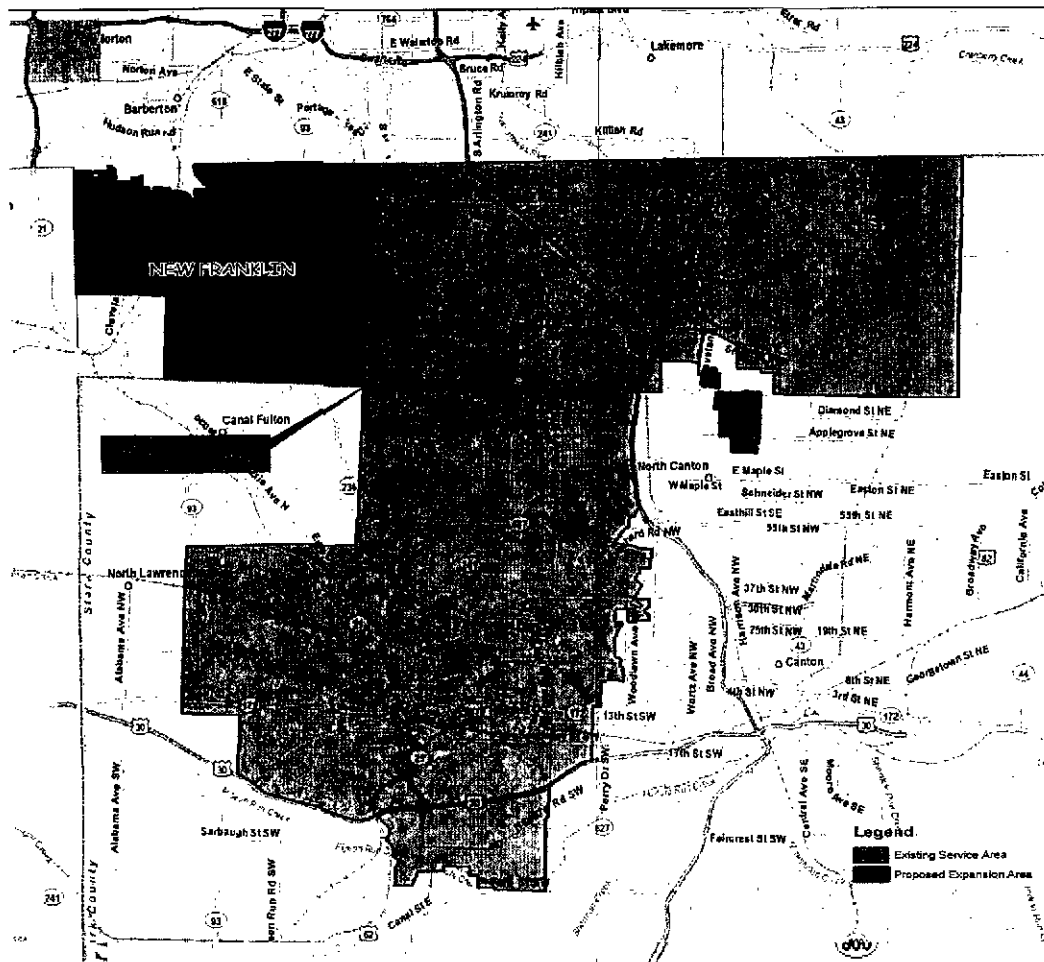

Deleted: September 24, 2003

Deleted: September 24, 2003

Deleted: Walter J. Pishkur

Deleted: Consumers Ohio Water Company

Deleted: D

Deleted: September 18, 2003

Deleted: 02

Deleted: 1082

Deleted: UNC

Issued: _____, 2011

Effective: _____, 2011

Issued by Edmund P. Kolodziej, Jr., President, Aqua Ohio, Inc.
In accordance with the Public Utilities Commission of Ohio
Order dated _____, 2011 for Case No. 11-____-WW-AAC