

June 23, 2023

WRITER'S DIRECT NUMBER: (614) 462-2319
DIRECT FAX: (614) 232-6883
EMAIL: Nicole.Woods@icemiller.com

Via Document Information System (DIS) Submission

Ms. Barcy F. McNeal
Director, Office of Administration
Public Utilities Commission of Ohio
180 East Broad Street, 11th Floor
Columbus, Ohio 43215

RE: *In the Matter of the Joint Application of Aqua Ohio, Inc. and Aqua Ohio
Wastewater, Inc. to Amend Tariff*
Case No. 23-0176-WS-ATA
Tariff Case No. 89-7028-WW-TRF

Dear Ms. McNeal:

Attached are redlined and clean tariff sheets for Aqua Ohio, Inc.'s P.U.C.O. Tariff No. 2 as ordered in the Commission's Finding and Order dated May 31, 2023.

- Section 2, Seventh Revised Sheet No. 2 replacing Sixth Revised Sheet No. 2
- Section 5, First Revised Sheet No. 10 replacing Original Sheet No. 10

This filing is being made electronically in the above-referenced proceeding through the Docketing Information System. Please update the Commission's copies of this Tariff with the attached sheets at your earliest convenience.

Respectfully,
ICE MILLER LLP



Nicole R Woods

P.U.C.O Tariff No. 2

(Redlined)

Aqua Ohio, Inc.
6650 South Avenue
Boardman, OH 44512

Section 2
~~Sixth~~ Seventh Revised Sheet No. 2
Replaces ~~Fifth~~ Sixth Sheet No. 2

P.U.C.O. Tariff No. 2

Customer Rights and Obligations Appx. B 6/17/20, 07/14/15

D

Damage due to Deficiency or Failure of Water Supply Deposits to Secure Payment of Bills	3-2	2	07/14/15
Discontinuance of Service	3-2	6-7, 8-10	07/14/15
	4	See Sch. of Rates	1/18/19, 3/7/18, 03/22/17, 07/14/15
Dishonored Payment Charge	4	See Sch. of Rates	1/18/19, 3/7/18, 03/22/17, 07/14/15

E

Explanation of Terms	3-1	1-5	6/17/20, 07/14/15
Employee Identification	3-2	9	07/14/15

F

Final Bill	3-3	2	6/17/20, 07/14/15
Fire Protection-Private	3-11	1-3	07/14/15
Fire Protection-Public	3-13	1-2	07/14/15
Flow Detecting Devices	3-11	2	07/14/15

H

Hose Connections	4	See Sch. of Rates	09/21/22, 03/22/17, 07/14/15
Hydrants, Public Fire-Installation of	3-13	1	07/14/15
Hydrants, Public Fire-Specifications of	3-13	2	07/14/15
Hydrants, Public Fire-Use of Water From	3-13	1	07/14/15
Hydrants, Rates	4	See Sch. of Rates	09/21/22, 03/22/17, 07/14/15

I

Installation-Meter	3-9	1-4	07/14/15
Installation-Service Dates	3-7	1	6/17/20, 07/14/15

M

Main Extension-Customer Finan. Plans	3-10	1-4	07/12/16, 07/14/15
Main Extension-General Maps	3-10 5	1 1-27	07/12/16, 07/14/15 <u>6/23/23</u> 1/18/19, 3/7/18, 07/14/15
Meter-Inability of Company to Read	3-3; 3-9	1; 2	07/14/15
Meter-Inaccurate or not registering	3-9	3-5	07/14/15

Issued: ~~September 21, 2022~~ June 23, 2023
June 23, 2023

Effective: September 21, 2022

Issued by Robert L. Davis, President, Aqua Ohio, Inc.

In accordance with the Public Utilities Commission of Ohio


Order Dated ~~September 21, 2022~~ May 31, 2023 for Case No. 21-0595-WW-AIR

23-176-WS-ATA

Aqua Ohio, Inc.
6650 South Avenue
Boardman, OH 44512

Section 5
Original-First Sheet No. 10
Replaces Original Sheet No. 10

P.U.C.O. Tariff No. 2

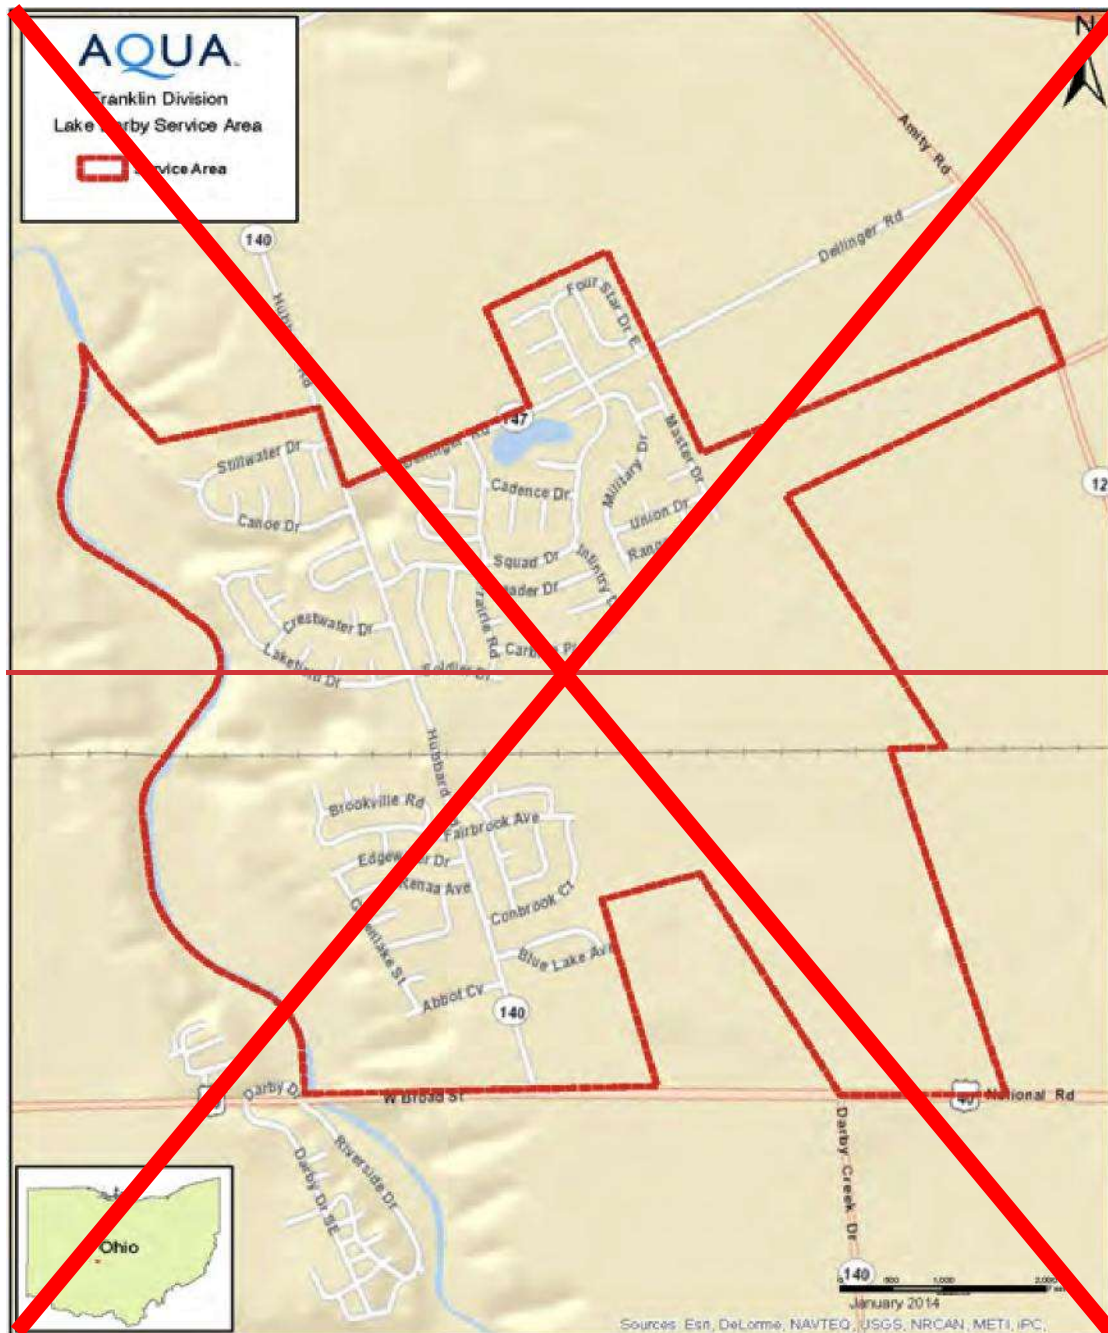


Issued: July 14, 2015 June 23, 2023 Effective: July 14, 2015 June 23, 2023

Issued by Edmund Kolodziej, Jr., Robert L. Davis President and COO, Aqua Ohio, Inc.

In accordance with the Public Utilities Commission of Ohio

Order Dated July 1, 2015 May 31, 2023 for Case No. 15-403-WW-ATA

23-176-WS-ATA

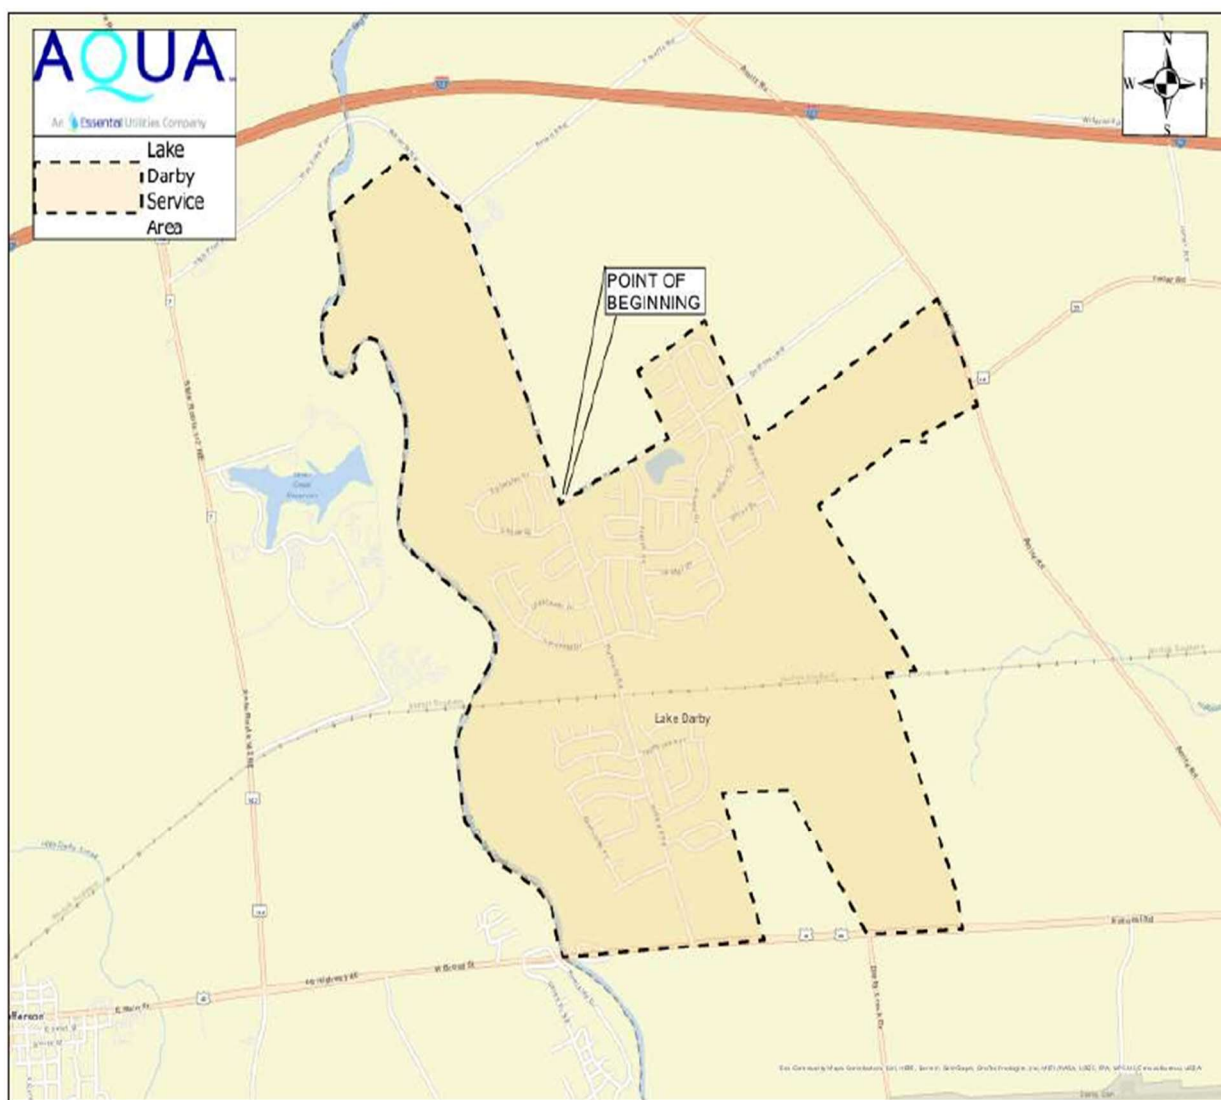

P.U.C.O Tariff No. 2

(Clean)

Aqua Ohio, Inc.
6650 South Avenue
Boardman, OH 44512

Section 2
Seventh Revised Sheet No. 2
Replaces Sixth Sheet No. 2

P.U.C.O. Tariff No. 2

Customer Rights and Obligations Appx. B 6/17/20, 07/14/15

D

Damage due to Deficiency or Failure of Water Supply Deposits to	3-2	2	07/14/15
Secure Payment of Bills	3-2	6-7, 8-10	07/14/15
Discontinuance of Service	4	See Sch. of Rates	1/18/19, 3/7/18, 03/22/17, 07/14/15
Dishonored Payment Charge	4	See Sch. of Rates	1/18/19, 3/7/18, 03/22/17, 07/14/15

E

Explanation of Terms	3-1	1-5	6/17/20, 07/14/15
Employee Identification	3-2	9	07/14/15

F

Final Bill	3-3	2	6/17/20, 07/14/15
Fire Protection-Private	3-11	1-3	07/14/15
Fire Protection-Public	3-13	1-2	07/14/15
Flow Detecting Devices	3-11	2	07/14/15

H

Hose Connections	4	See Sch. of Rates	09/21/22, 03/22/17, 07/14/15
Hydrants, Public Fire-Installation of	3-13	1	07/14/15
Hydrants, Public Fire-Specifications of	3-13	2	07/14/15
Hydrants, Public Fire-Use of Water From	3-13	1	07/14/15
Hydrants, Rates	4	See Sch. of Rates	09/21/22, 03/22/17, 07/14/15

I

Installation-Meter	3-9	1-4	07/14/15
Installation-Service Dates	3-7	1	6/17/20, 07/14/15

M

Main Extension-Customer Finan. Plans	3-10	1-4	07/12/16, 07/14/15
Main Extension-General	3-10	1	07/12/16, 07/14/15
Maps	5	1-27	6/23/23, 1/18/19, 3/7/18, 07/14/15
Meter-Inability of Company to Read	3-3; 3-9	1; 2	07/14/15
Meter-Inaccurate or not registering	3-9	3-5	07/14/15

Issued: June 23, 2023


Effective: June 23, 2023

Issued by Robert L. Davis, President, Aqua Ohio, Inc.
In accordance with the Public Utilities Commission of Ohio
Order Dated May 31, 2023 for Case No. 23-176-WS-ATA

Aqua Ohio, Inc.
6650 South Avenue
Boardman, OH 44512

Section 5
First Sheet No. 10
Replaces Original Sheet No. 10

P.U.C.O. Tariff No. 2

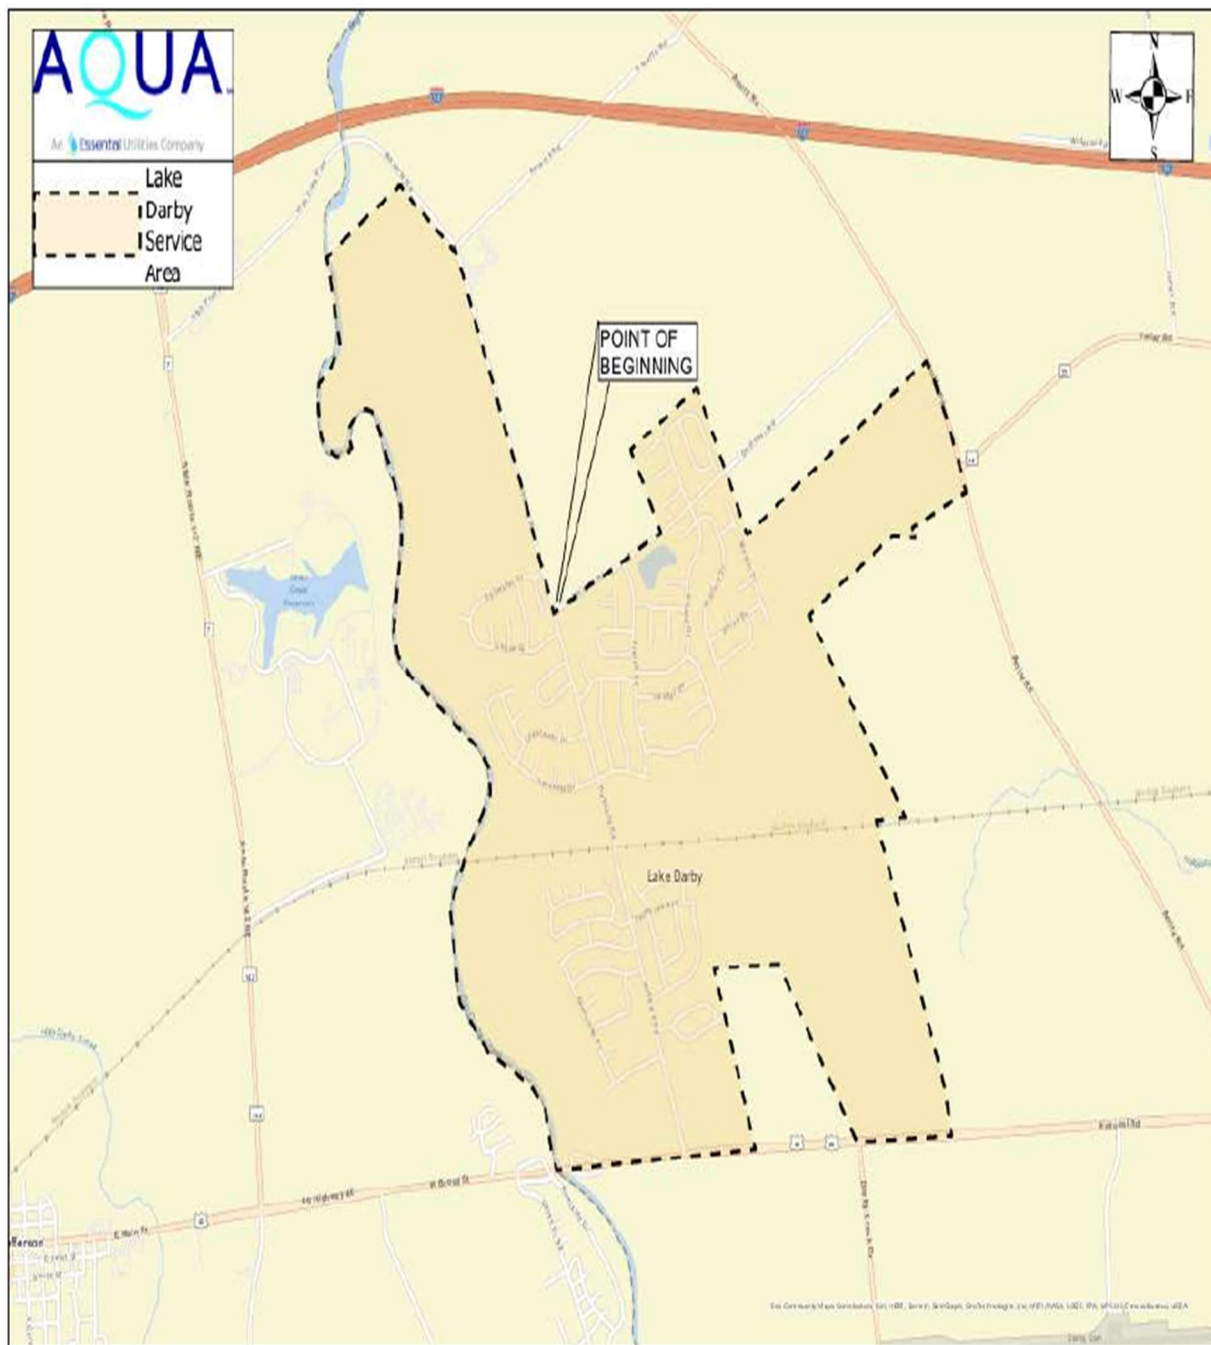

Issued: June 23, 2023

Effective: June 23, 2023

Issued by Robert L. Davis President, Aqua Ohio, Inc.
In accordance with the Public Utilities Commission of Ohio
Order Dated May 31, 2023 for Case No. 23-176-WS-ATA

**This foregoing document was electronically filed with the Public Utilities
Commission of Ohio Docketing Information System on**

6/23/2023 3:46:18 PM

in

Case No(s). 23-0176-WS-ATA, 89-7028-WW-TRF

Summary: Tariff Revised Tariff Pages, PUCO No. 2, Section 2, Seventh Revised Sheet No. 2; Section 5, First Revised Sheet No. 10 electronically filed by Ms. Nicole R. Woods on behalf of Aqua Ohio, Inc..