



150 E. GAY STREET, 24TH FLOOR
COLUMBUS, OH 43215-3192
TELEPHONE: (614) 744-2570
FACSIMILE: (844) 670-6009
<http://www.dickinsonwright.com>

WILLIAM V. VORYS
WVorys@dickinsonwright.com
(614) 744-2936

September 18, 2017

Ms. Barcy F. McNeal, Secretary
Ohio Power Siting Board
Docketing Division
180 East Broad Street, 11th Floor
Columbus, OH 43215

**Re: Case No. 13-197-EL-BGN, 16-1687-EL-BGA, and 17-1099-EL-BGA
Trishe Wind Ohio, LLC
Notification of Compliance with Condition 4 of the Supplement –
Vegetation Management Plan**

Dear Ms. McNeal:

Trishe Wind Ohio, LLC (“Applicant”) is certified to construct a wind-powered electric generation facility in Paulding County, Ohio (“Project”), in accordance with the December 16, 2013 Opinion, Order, and Certificate (“Certificate”) issued by the Ohio Power Siting Board (“OPSB”). The Certificate is subject to the 40 conditions set forth in the December 16, 2013 Order, as well as the 26 conditions set forth in the October 1, 2013 Supplement to the original application (“Supplement”).

Condition 4 of the Supplement requires the Applicant to submit to OPSB staff for review and acceptance a vegetation management plan. The Applicant is providing this letter to notify the OPSB that the Applicant has developed and completed the vegetation management plan, which is attached hereto. Accordingly, Condition 4 of the Supplement is satisfied.

We are available, at your convenience, to answer any questions you may have.

Respectfully submitted,

/s/ William V. Vorys

William V. Vorys (0093479)

Christine M.T. Pirik (0029759)

Terrence O'Donnell (0074213)

Dickinson Wright PLLC

150 East Gay Street, Suite 2400

Columbus, Ohio 43215

Phone: (614) 591-5461

Email: wvorys@dickinsonwright.com

cpirik@dickinsonwright.com

todonnell@dickinsonwright.com

Attorneys for Trishe Wind Ohio, LLC

Enclosure
COLUMBUS 73809-1 75992v1

Northwest Ohio Wind Farm
Trishe Wind Ohio, LLC



Vegetation Plan
09-15-2017

Proposed Vegetation Clearing

The project will strip approximately one hundred fifty (150) acres of topsoil across the project site for the construction of the private access roads, turbine foundations, collection system, temporary laydown yard, O&M Building, and substation. The project will impact less than one (1) acre of wooded areas and is developing plans to potentially impact no wooded areas on the project. The green shaded areas on the attached drawings show the potential areas of wooded clearing disturbance.

Clearing Method

The project will strip the topsoil using primarily dozers and blades. All topsoil will be stockpiled at the location it is stripped, eliminating potential soil contamination across the project. In wooded areas, the trees and stumps will be removed with excavators to minimize the impact to surrounding vegetation. The trees and stumps will be removed from the project site and disposed of at a permitted disposal site.

Vegetation Protection

In areas where the Work is in close proximity to vegetation that does not need to be disturbed, the project will take various measures to ensure no disturbance occurs. The project will utilize earthen berms, silt fence, or orange snow fence as a boundary between the work zone and protected area. Additionally, the crews working in the vicinity of protected vegetation will be informed at morning meetings to avoid the no disturbance areas.

Project Mobilization


The project is confined to defined corridors of allowable disturbance for the construction of the Work. Heavy equipment will either move from site to site along these corridors with defined disturbance or be transported from site to site via public roads. It is the project's intent to minimize any disturbance that is unnecessary. The project team will analyze various scenarios during construction to minimize disturbance and avoid clearing wooded areas. Options would include increasing the length of bores to eliminate disturbance, utilizing transport vehicles, and combining routing to eliminate unnecessary disturbance. Each opportunity is a case by case basis, and will be determined at the time of construction.

Vegetation Reclamation

The project will reclaim all areas of temporary disturbance. Of the approximately 150 acres of disturbed topsoil, 130 will be reclaimed to its original state. The remaining area will be stabilized as private access roads, the operations and maintenance building and yard, the turbine footprint, and the substation. All nonagricultural land will be reseeded per recommendations from the engineer of record. All agricultural land will be return to

productive farmland for the next growing season. All restabilized areas will be protected until germination and documented in the Storm Water Pollution Prevention Plan.

SEE SHEET 19

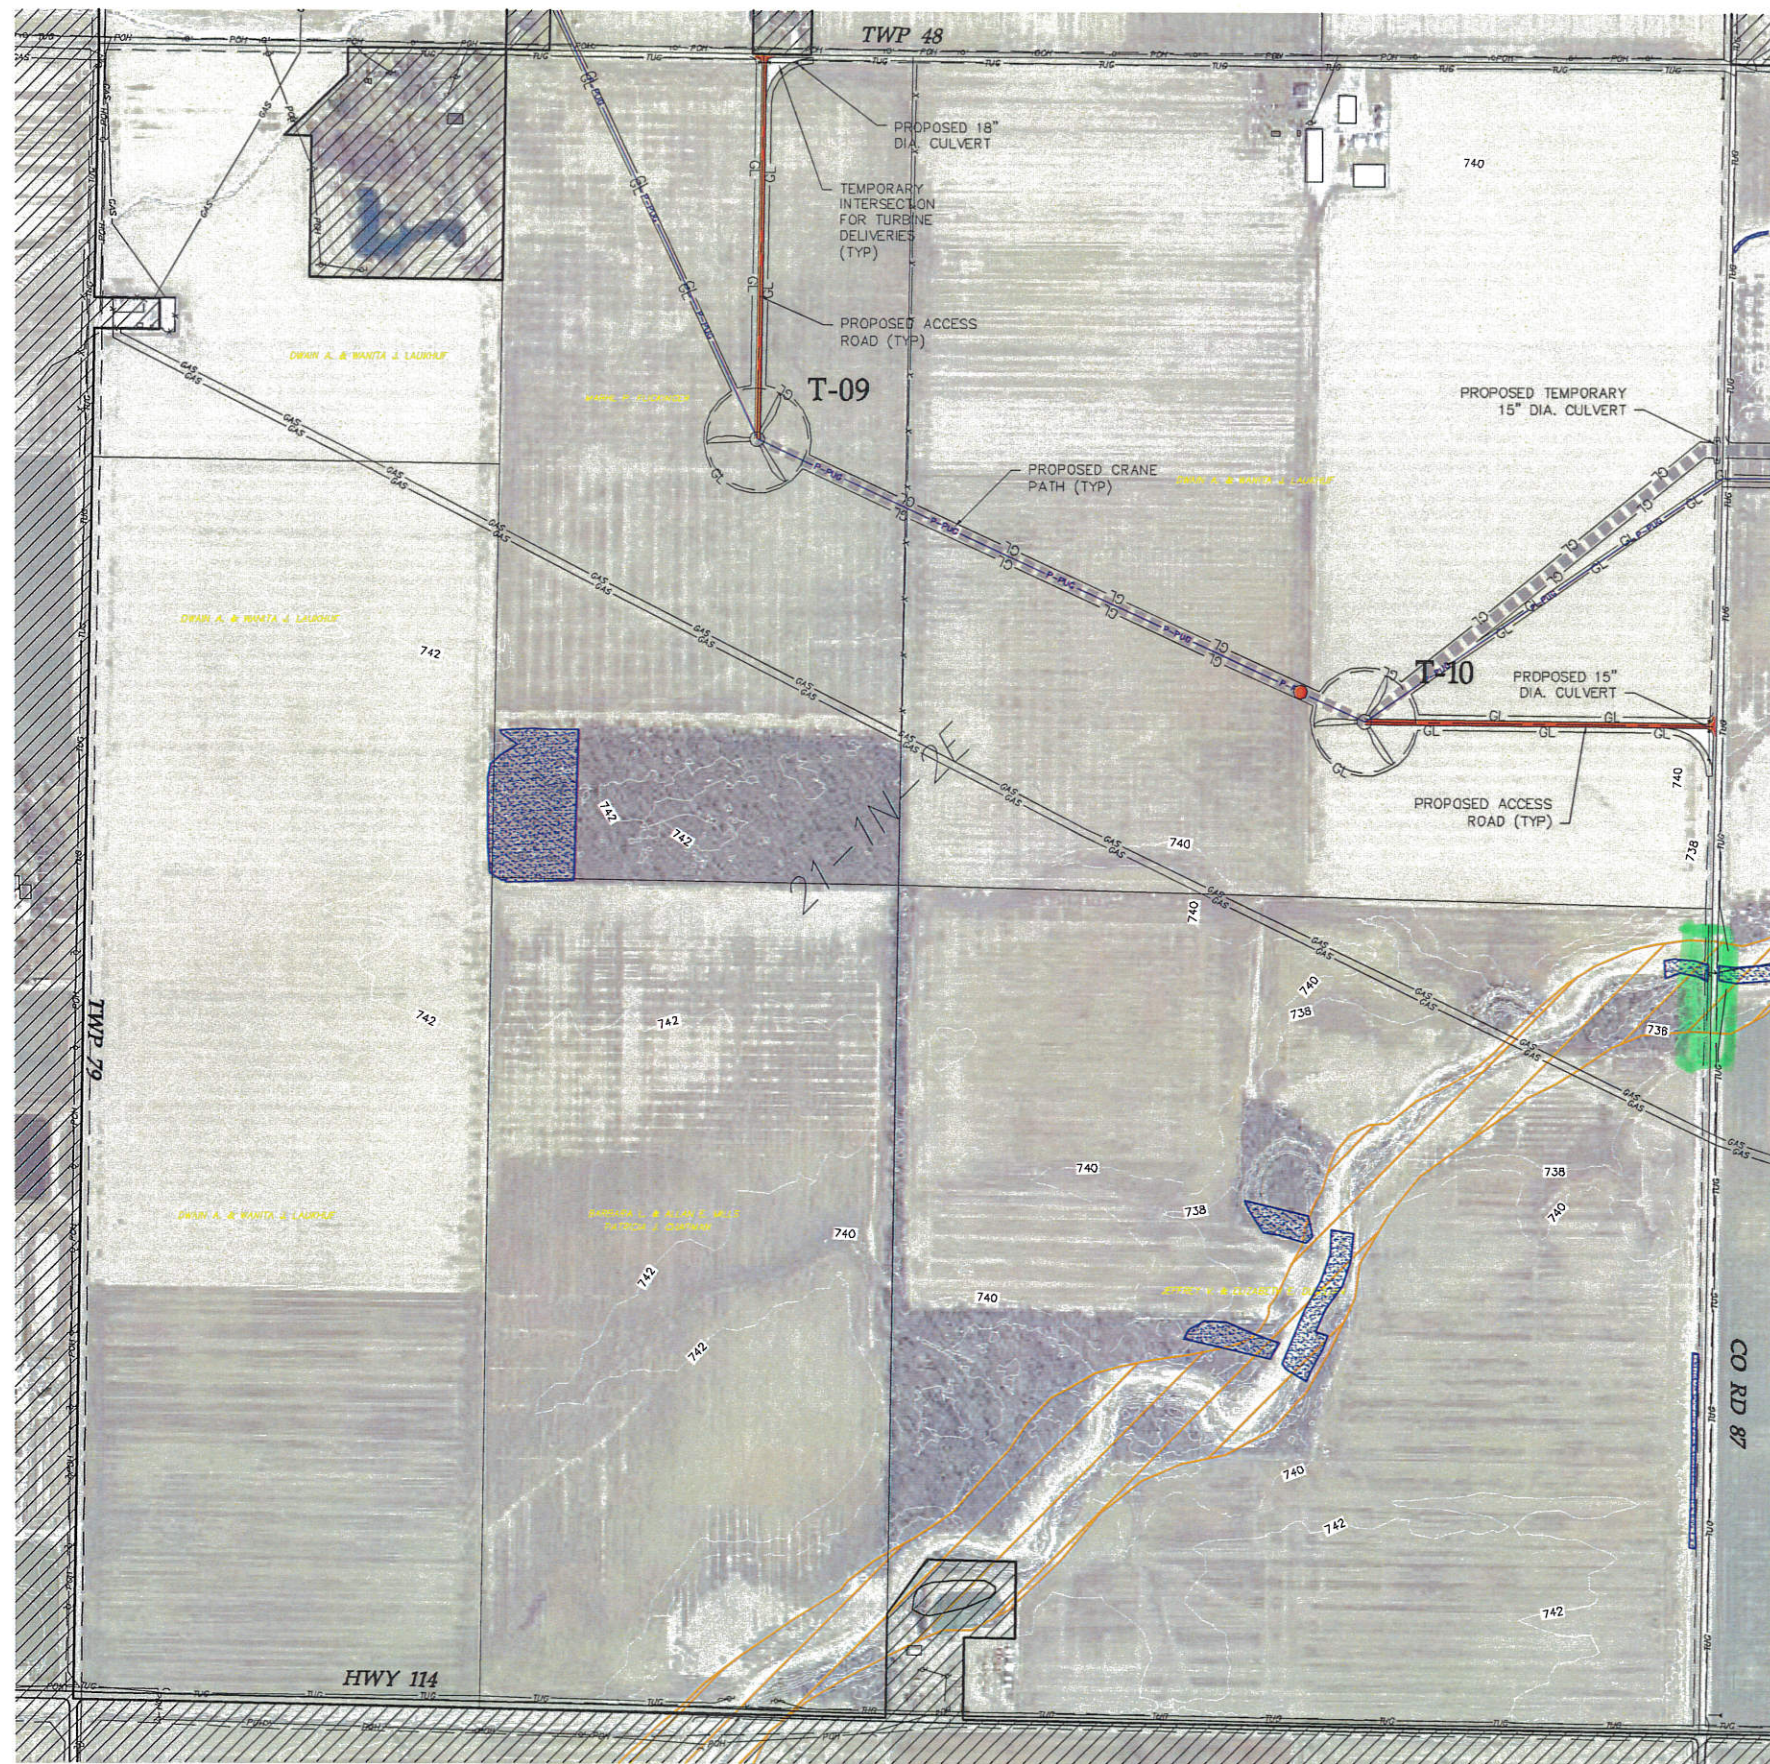

LEGEND:

- TURBINE LOCATION
- T-XX TURBINE NUMBER
- PROPOSED ACCESS ROAD
- PROPOSED CRANE PATH
- PROPOSED UNDERGROUND COLLECTION
- PROPOSED DISTURBANCE LIMITS
- PROPOSED EROSION/SEDIMENT CONTROL
- EXISTING OVERHEAD POWER
- EXISTING OIL/GAS PIPELINE
- EXISTING TELEPHONE LINE
- EXISTING CABLE LINE
- EXISTING RIGHT OF WAY
- EXISTING 10' CONTOURS
- EXISTING 2' CONTOURS
- DELINEATED WETLAND
- EXISTING ROAD
- OUT OF PROJECT BOUNDARY
- FEMA FLOODPLAIN BOUNDARY
- PROPOSED CULVERT
- POTENTIAL CRANE MAT LOCATIONS

NOTE: PLANS DO NOT DETAIL VARIOUS COUNTY/TOWNSHIP ROAD SECTION UPGRADES OR WIDENING REQUIRED FOR CONSTRUCTION DELIVERIES PER THE ROAD MAINTENANCE AGREEMENT BETWEEN PROJECT OWNER AND PAULDING COUNTY.

Westwood

Phone (852) 937-5150 7699 Anagram Drive
Fax (852) 937-5822 Eden Prairie, MN 55344
Toll Free (888) 937-5150 westwoodps.com
Westwood Professional Services, Inc.

Designed: KLG

Checked: SJW

Drawn: KLG

As-Built Drawing:

Revision #	DATE	DESCRIPTION
A	09/01/17	60% plans
B	09/07/17	90% plans

Prepared for:



3900 E. White Ave
Clinton, IN 47842

Trishe Wind Ohio, LLC
c/o Starwood Energy Group, LLC
5 Greenwich Office Park, 2nd Floor
Greenwich, CT 06831



**Northwest
Ohio Wind
Project**
Paulding, Ohio

Civil Site Plan T09 T10

Not For Construction


Array Date: 08/14/2017

Date: 09/07/2017

Sheet: 26 OF 38


0007185-00SPF01.dwg

SEE SHEET 27

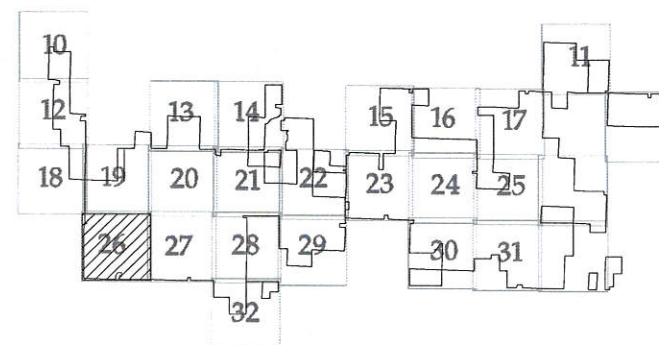

KEY MAP

SEE SHEET 20

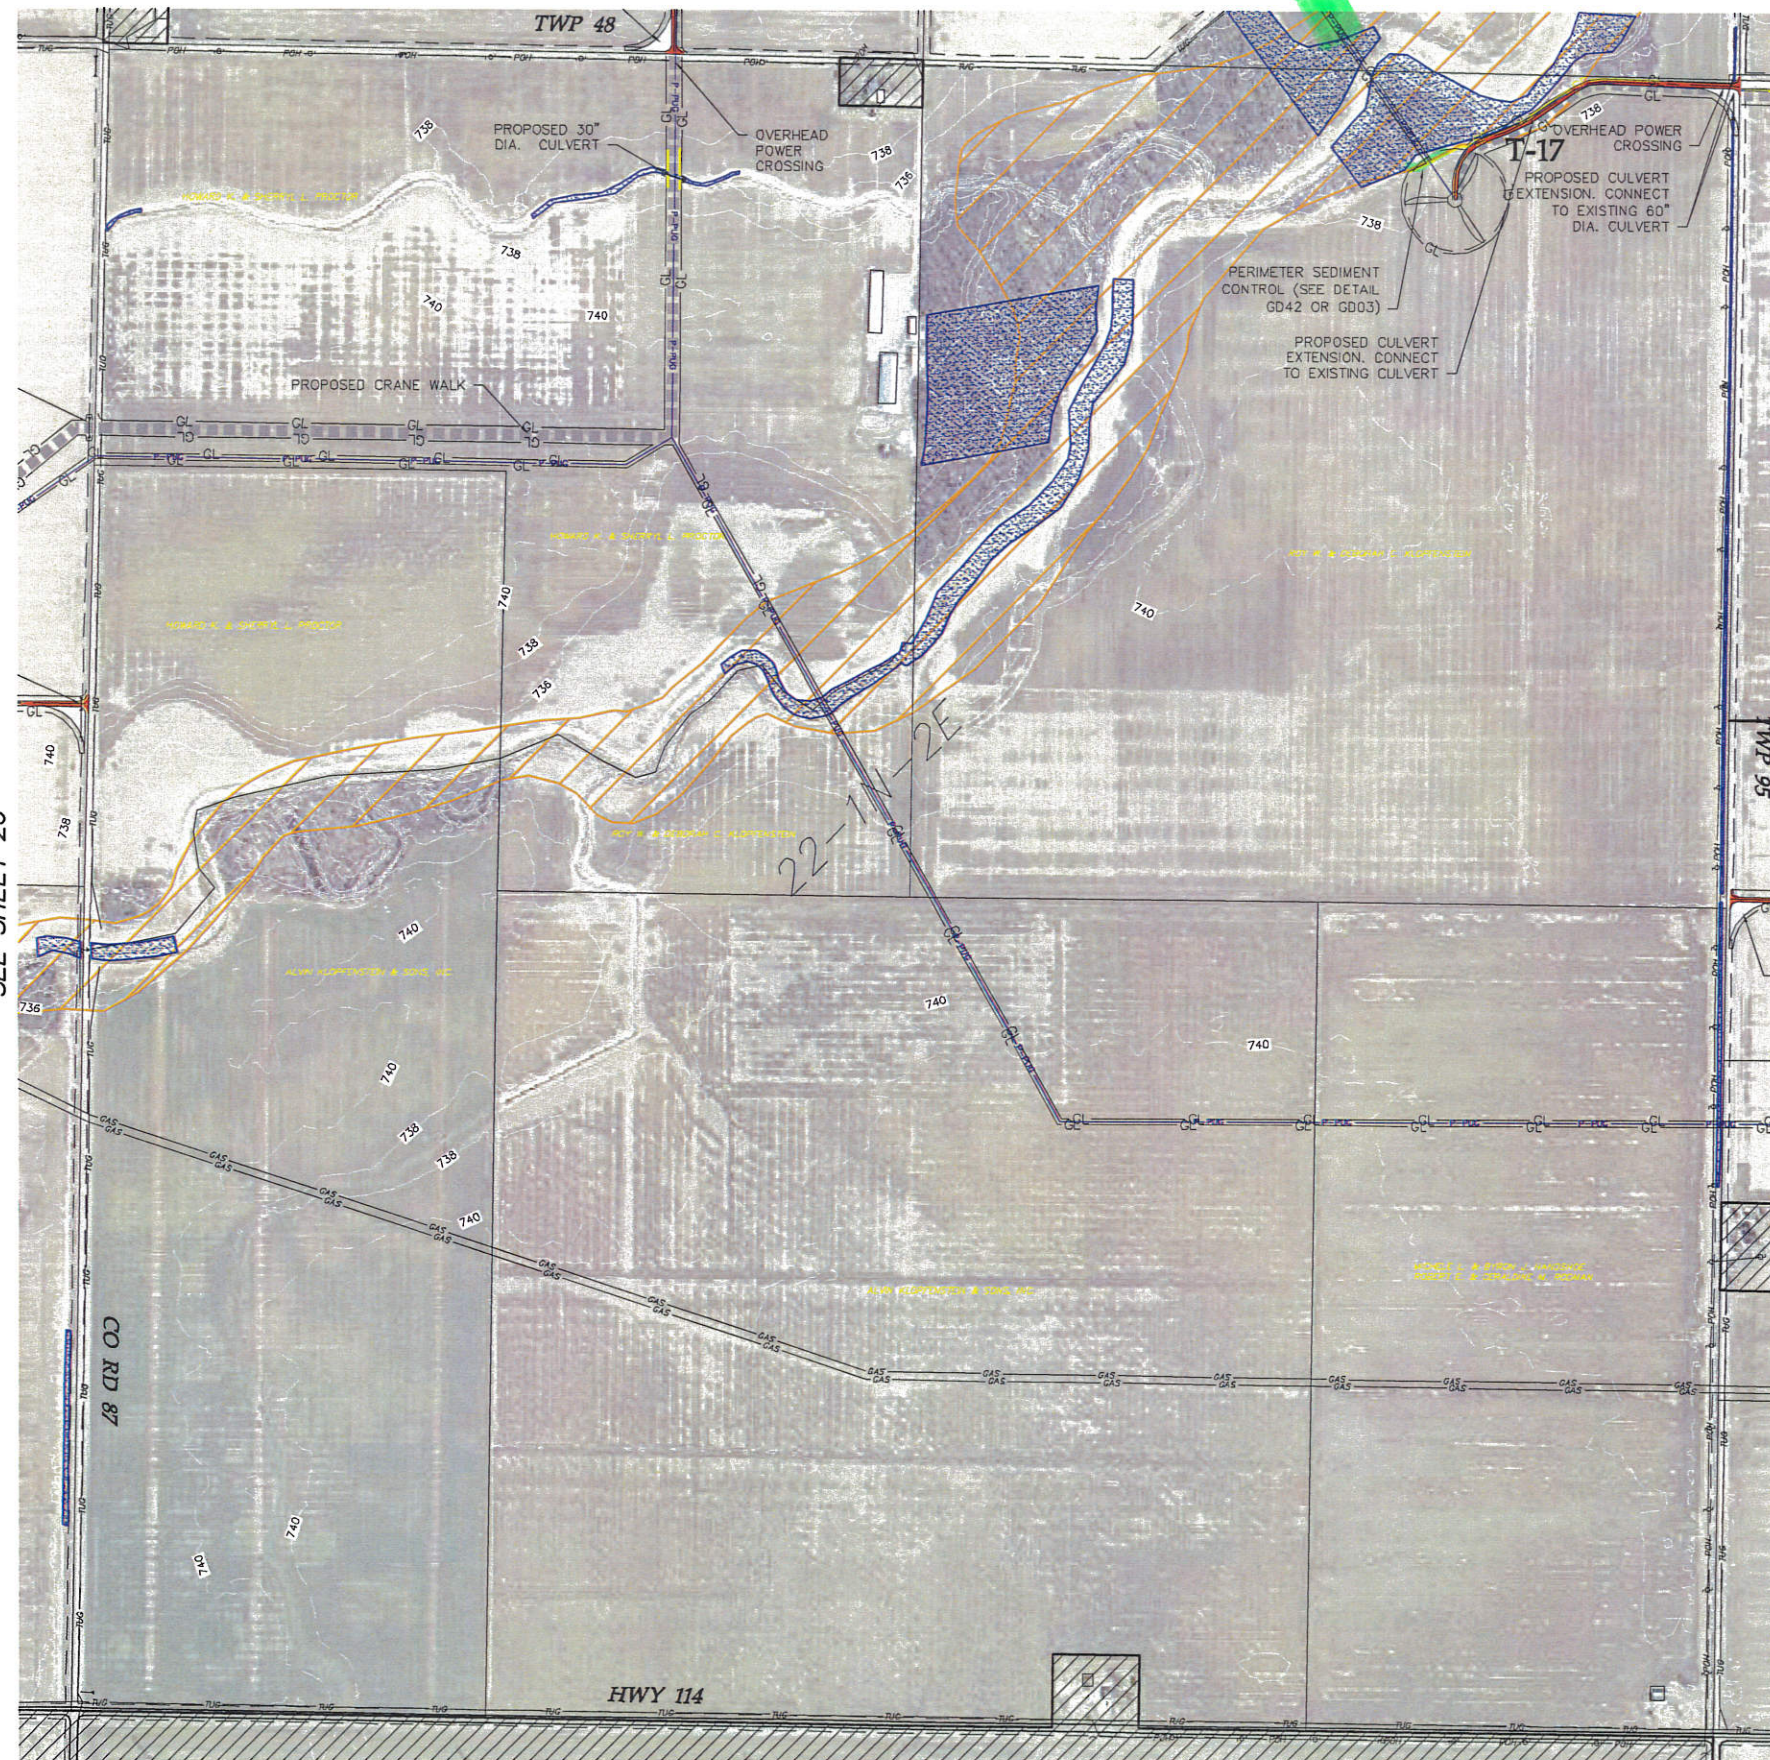

LEGEND:

- TURBINE LOCATION
- T-XX TURBINE NUMBER
- PROPOSED ACCESS ROAD
- PROPOSED CRANE PATH
- PROPOSED UNDERGROUND COLLECTION
- PROPOSED DISTURBANCE LIMITS
- PROPOSED EROSION/SEDIMENT CONTROL
- EXISTING OVERHEAD POWER
- EXISTING OIL/GAS PIPELINE
- EXISTING TELEPHONE LINE
- EXISTING CABLE LINE
- EXISTING RIGHT OF WAY
- EXISTING 10' CONTOURS
- EXISTING 2' CONTOURS
- DELINEATED WETLAND
- EXISTING ROAD
- OUT OF PROJECT BOUNDARY
- FEMA FLOODPLAIN BOUNDARY
- PROPOSED CULVERT
- POTENTIAL CRANE MAT LOCATIONS

NOTE: PLANS DO NOT DETAIL VARIOUS COUNTY/TOWNSHIP ROAD SECTION UPGRADES OR WIDENING REQUIRED FOR CONSTRUCTION DELIVERIES PER THE ROAD MAINTENANCE AGREEMENT BETWEEN PROJECT OWNER AND PAULDING COUNTY.

Westwood

Phone (852) 937-5150 7699 Anagram Drive
Fax (852) 937-5822 Eden Prairie, MN 55344
Toll Free (888) 937-5150 westwoodps.com
Westwood Professional Services, Inc.

Designed: KLG
Checked: SJU
Drawn: KLG

As-Built Drawing:


Revision #	DATE	DESCRIPTION
A	09/01/17	60% plans
B	09/07/17	90% plans

Prepared for:



3900 E. White Ave
Clinton, IN 47842

Trishe Wind Ohio, LLC
c/o Starwood Energy Group, LLC
5 Greenwich Office Park, 2nd Floor
Greenwich, CT 06831

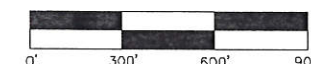

Northwest Ohio Wind Project

Paulding, Ohio


Civil Site Plan T17

Not For Construction

Array Date: 08/14/2017


Date: 09/07/2017

Sheet: 27 OF 38

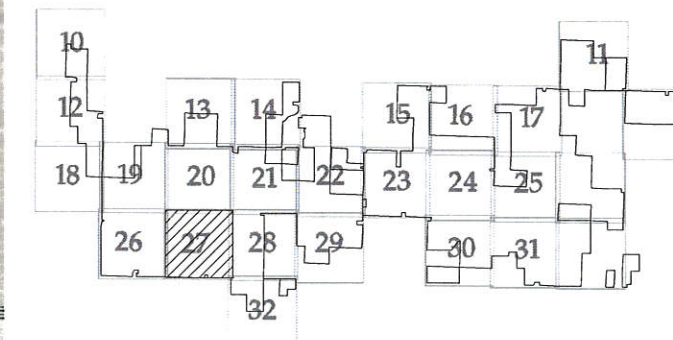

KEY MAP


SEE SHEET 28

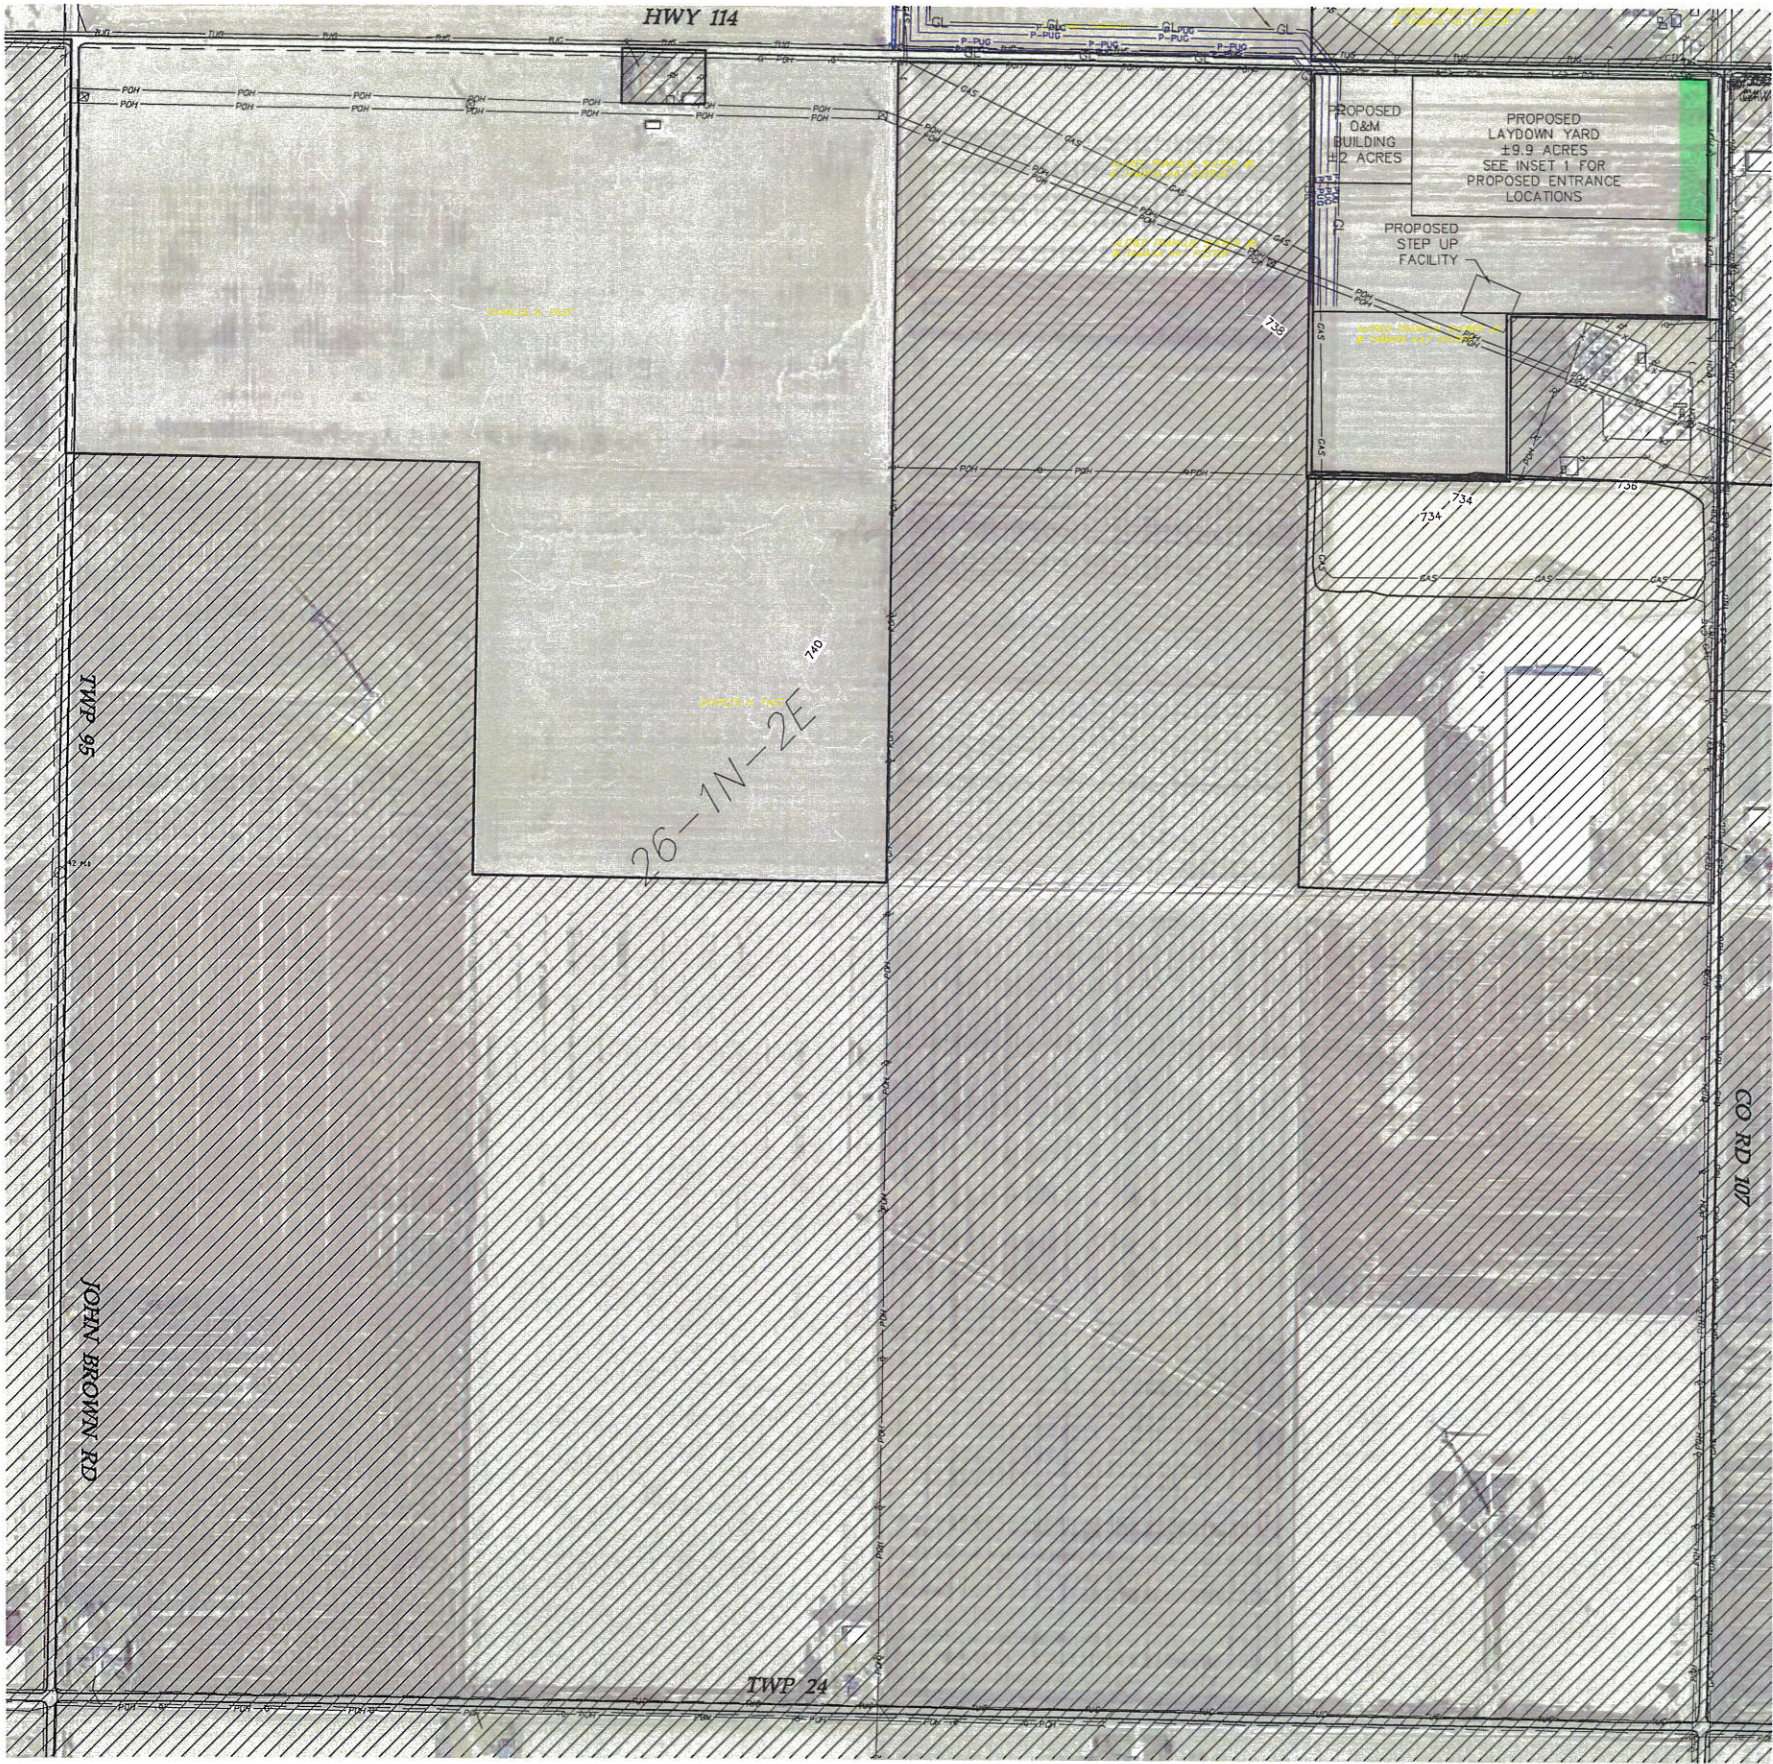


LEGEND:

- TURBINE LOCATION
- TURBINE NUMBER
- PROPOSED ACCESS ROAD
- PROPOSED CRANE PATH
- PROPOSED UNDERGROUND COLLECTION
- PROPOSED DISTURBANCE LIMITS
- PROPOSED EROSION/SEDIMENT CONTROL
- EXISTING OVERHEAD POWER
- EXISTING OIL/GAS PIPELINE
- EXISTING TELEPHONE LINE
- EXISTING CABLE LINE
- EXISTING RIGHT OF WAY
- EXISTING 10' CONTOURS
- EXISTING 2' CONTOURS
- DELINEATED WETLAND
- EXISTING ROAD
- OUT OF PROJECT BOUNDARY
- FEMA FLOODPLAIN BOUNDARY
- PROPOSED CULVERT
- POTENTIAL CRANE MAT LOCATIONS

NOTE: PLANS DO NOT DETAIL VARIOUS COUNTY/TOWNSHIP ROAD SECTION UPGRADES OR WIDENING REQUIRED FOR CONSTRUCTION DELIVERIES PER THE ROAD MAINTENANCE AGREEMENT BETWEEN PROJECT OWNER AND PAULDING COUNTY.

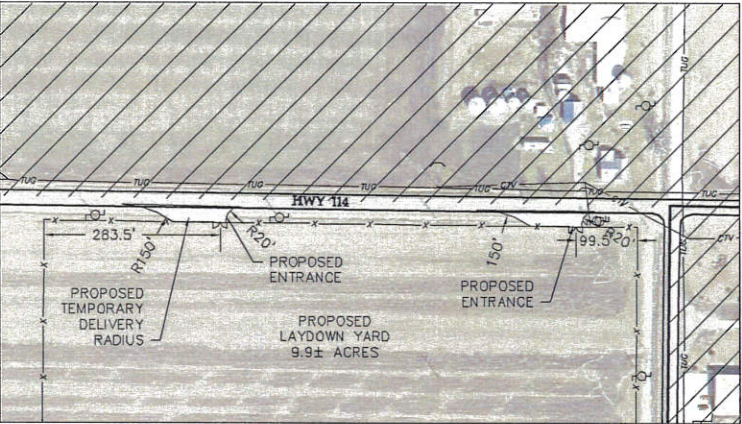

INSET 1
1"=150'

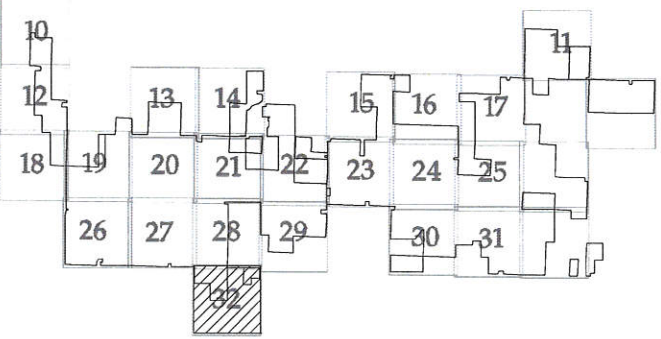

KEY MAP

Westwood

Phone (852) 937-5150 7609 Anagram Drive
Fax (852) 937-5822 Eden Prairie, MN 55344
Toll Free (888) 937-5150 westwoodps.com
Westwood Professional Services, Inc.

Designed: KLG
Checked: SJB
Drawn: KLG

As-Built Drawing:

Revision #	DATE	DESCRIPTION
A	09/01/17	60% plans
B	09/07/17	90% plans

Prepared for:



3900 R. White Ave
Clinton, IN 47842

Trishe Wind Ohio, LLC
c/o Starwood Energy Group, LLC
5 Greenwich Office Park, 2nd Floor
Greenwich, CT 06831



Northwest
Ohio Wind
Project

Paulding, Ohio

Civil Site Plan

Not For Construction

Array Date: 08/14/2017
Date: 09/07/2017
Sheet: 32 OF 38

This foregoing document was electronically filed with the Public Utilities

Commission of Ohio Docketing Information System on

9/18/2017 4:43:32 PM

in

Case No(s). 13-0197-EL-BGN, 16-1687-EL-BGA, 17-1099-EL-BGA

Summary: Notification of Compliance with Condition 4 of the Supplement – Vegetation Management Plan electronically filed by Mr. William V Vorys on behalf of Trishe Wind Ohio, LLC