

Memo

To: Docketing Division
From: Jill Henry, Rail Specialist, Rail Division
Cc: PUCO Legal Department
Date: 8/22/18

Re: PUCO Case No. 18-1310-RR-FED- In the Matter of a Request for the Installation of New Active Warning Devices at the Norfolk Southern Railway Crossing, CR 5 DOT# 472-496M, in Putnam County, Ohio.

On February 27, 2018, the Ohio Rail Development Commission (ORDC) authorized funding for Norfolk Southern Railway to install active warning devices at CR 5 DOT#472-496M, in Putnam County, Ohio. The crossing was surveyed, on August 10, 2017, and found to warrant the upgrades. The electric utility provider for this crossing is the Hancock Wood Electric Cooperative.

The project will be paid for with federal funds and is actual cost. The plans and estimates for the project in the amount of \$428,281.00 have been approved. Construction may commence at once. **Staff requests a Finding & Order with completion of the project in twelve months.** Staff requests that the following language be incorporated in the Finding & Order:

It is expected that all work necessary for FHWA acceptance of the warning devices will be completed by the in-service due date and that the railroad will be responsible for this work. This work includes, but is not limited to:

- Any ancillary work to make the warning devices function as designed and visible to the roadway user, and
- MUTCD compliance, including minor roadway work if necessary.

Please serve the following parties of record:

Norfolk Southern Railway Company
Kurt Young
Public Projects Engineer
1200 Peachtree Street NE
Box 123
Atlanta, GA 30309-3597

Norfolk Southern Railway Company
Cayela Wimberly
Director Grade Crossing Safety
1200 Peachtree Street NE
Atlanta, GA 30309-3597

Eastman & Smith LTD.
Mr. Casey Talbott
Attorney for Norfolk Southern
One SeaGate 24th Floor
P.O. Box 10032
Toledo, Ohio 43699-0032

Ohio Rail Development Commission
Cathy Stout
Safety Manager
1980 West Broad Street
Mail Stop #3140
Columbus, Ohio 43223

Putnam County Engineer
Michael L. Lenhart
245 E. Main Street, Suite 205
Ottawa, OH 45875

Hancock Wood Electric Cooperative
1399 Business Park Drive South
P.O. Box 190
North Baltimore, OH 45872-1090

**OHIO RAIL DEVELOPMENT COMMISSION
INTER-OFFICE COMMUNICATION**

TO: Randall Schumacher, Supervisor, Rail Division, PUCO

FROM: Cathy Stout, Manager, Safety Section, ORDC

BY: Don Damron, Project Manager

SUBJECT: Putnam County, CR 5
Norfolk Southern
DOT# 472496M
PID# 106851

DATE: 7/5/2018

The Ohio Rail Development Commission (ORDC) established a Diagnostic Review Team Survey at the subject location on August 10, 2017. The Public Utilities Commission of Ohio (PUCO) attended the review. The Diagnostic Team recommended upgrades to the automatic warning devices. Copies of the diagnostic review form and the plan and estimate are attached.

PE has already been provided by the railroad. ORDC accepts the site plans and estimates as provided. Please issue a 12-month construction-only order for the project outlined above. This authorization is made with the stipulation and understanding that an approved estimate may contain entries for items or activities that may be cited and found to be ineligible for federal participation during the project audit.

It is expected that all work necessary for FHWA acceptance of the warning devices will be completed by the in-service due date and that the railroad will be responsible for this work. This work includes, but is not limited to:

- any ancillary work to make warning devices function as designed and visible to the roadway user, and
- MUTCD compliance – including minor roadway work if necessary.

Thank you for your assistance with these matters.

Attachment: Diagnostic Review
Plan & Estimate

c: Jill Henry, Rail Specialist, PUCO
ORDC Project Manager (file)

July 5, 2018

Mr. Stephen Klinger
Norfolk Southern Corporation
Administrator Grade Crossing Program
1200 Peachtree St. NE, Box 123
Atlanta, GA 30309

RE: Construction Authorization for Grade Crossing Warning Device Modifications
CR 5 in Putnam County
DOT# 472496M; PID# 106851

Dear Mr. Klinger:

The plan and estimate dated June 12, 2018, for the referenced project is acceptable. Please note that the railroad must provide ORDC with a plan stamped by a professional engineer licensed in the State of Ohio prior to acceptance and close out of the project. Norfolk Southern may proceed with the construction of the proposed grade crossing warning system modifications in accordance with the abbreviated plan. This authorization is made with the stipulation and understanding that the approved estimate may contain entries for items or activities that may be cited and found to be ineligible for federal participation during the project audit. Reimbursement of eligible actual cost is limited to \$428,281.00. Additional costs must be approved in writing by the Ohio Rail Development Commission (ORDC) prior to being incurred. Emergency verbal authorizations by ORDC may be permitted and will be confirmed by ORDC in writing within ten (10) business days of the verbal approval.

This authorization is contingent upon Norfolk Southern Corporation accepting the following instructions:

1. The NS project foreman will furnish written notification five (5) working days prior to the date work will start at the project site to Don Damron, ORDC, at don.damron@dot.ohio.gov, cell 614-917-8466, office 614-466-2509, or mail to 1980 West Broad Street, 2nd Floor, Columbus Ohio 43223; and to the Public Utilities Commission of Ohio at Jill.Henry@puco.ohio.gov (phone 614-466-0435). The NS project foreman will also notify the same of any stops and re-starts of the work activity and of the date work was completed for the project.
2. NS will arrange for utilities to be located at the project site by the Ohio Utilities Protection Service (OUPS) prior to any construction activities at the site. Utilities that are not participating members of the service must be contacted directly by NS.
3. The NS project foremen will notify Don Damron at 614-917-8466 (cell) or don.damron@dot.state.oh.us (email) of any changes in the scope of work, cost overruns, material changes, etc. which are not included in the approved plan and estimate and secure approval of same before the work is performed.

4. Open cut of roadways is not permitted except in unusual circumstances and must be coordinated with the local highway authority and preapproved by ORDC.
5. Norfolk Southern will furnish two (2) copies of each partial bill to ORDC. Please find the enclosed ODOT Purchase Order to reference when billing.
6. Norfolk Southern will furnish two (2) copies of the final all-inclusive bill to ORDC stating the exact dates of starting and completing work, the initial and final dates of construction and location where the accounts may be audited.
7. The installation of the new warning device system will include any ancillary work needed to make the warning devices function as designed and to satisfy MUTCD requirements.

Thank you for your assistance with these matters.

Sincerely,

A handwritten signature in black ink, appearing to read "Donald J. Damron", written in a cursive style.

Donald J. Damron
Project Manager

C: Randall Schumacher, Chief, Rail Division, PUCO
Jill Henry, Rail Specialist, PUCO
ORDC (file)

TO FT. WAYNE
(R.R. WEST)
M.P. INCREASING

Ohio Utilities Protection Service

Call 811
before you dig



TO BELLEVUE
(R.R. EAST)
M.P. DECREASING


O.H. POWER LINES
(V.O.H.C. POWER 32',35',47')

IN SERVICE _____ SIGNED _____ DATE _____
☐ S&E ENGINEERING COPY
☐ CONSTRUCTION OFFICE COPY
RETURN TO S&E ENG. AFTER COMPLETION
☐ FIELD COPY
RETURN TO CASE AFTER COMPLETION
☐ PROJECT ENGINEER COPY

NOTES:

1. MAX. TRAIN SPEED BOTH TRACKS: 60 M.P.H.
2. LATITUDE N 41° 06' 19" LONGITUDE W 83° 57' 28" ELEVATION 757'
3. SIGNAL "A" TO HAVE BELL.
4. LOCATE U/G UTILITIES & CABLE BEFORE DIGGING.
5. CROSSING LOCATED IN PUTMAN COUNTY.
6. NEAREST STREET ADDRESS IS
5304 PROTEC PKWY.
7. NEAREST INTERSECTING STREET IS
SOUTH TO E. MATHIAS ST.
8. DISTANCE TO NEAREST INTERSECTING STREET IS 1204 FT.
9. 10 CUBIC YARDS OF FILL IS REQUIRED IN QUAD "A" FOR PROPER SIGNAL PLACEMENT.

(A) (B) (C) (D) = QUADRANT MARKERS

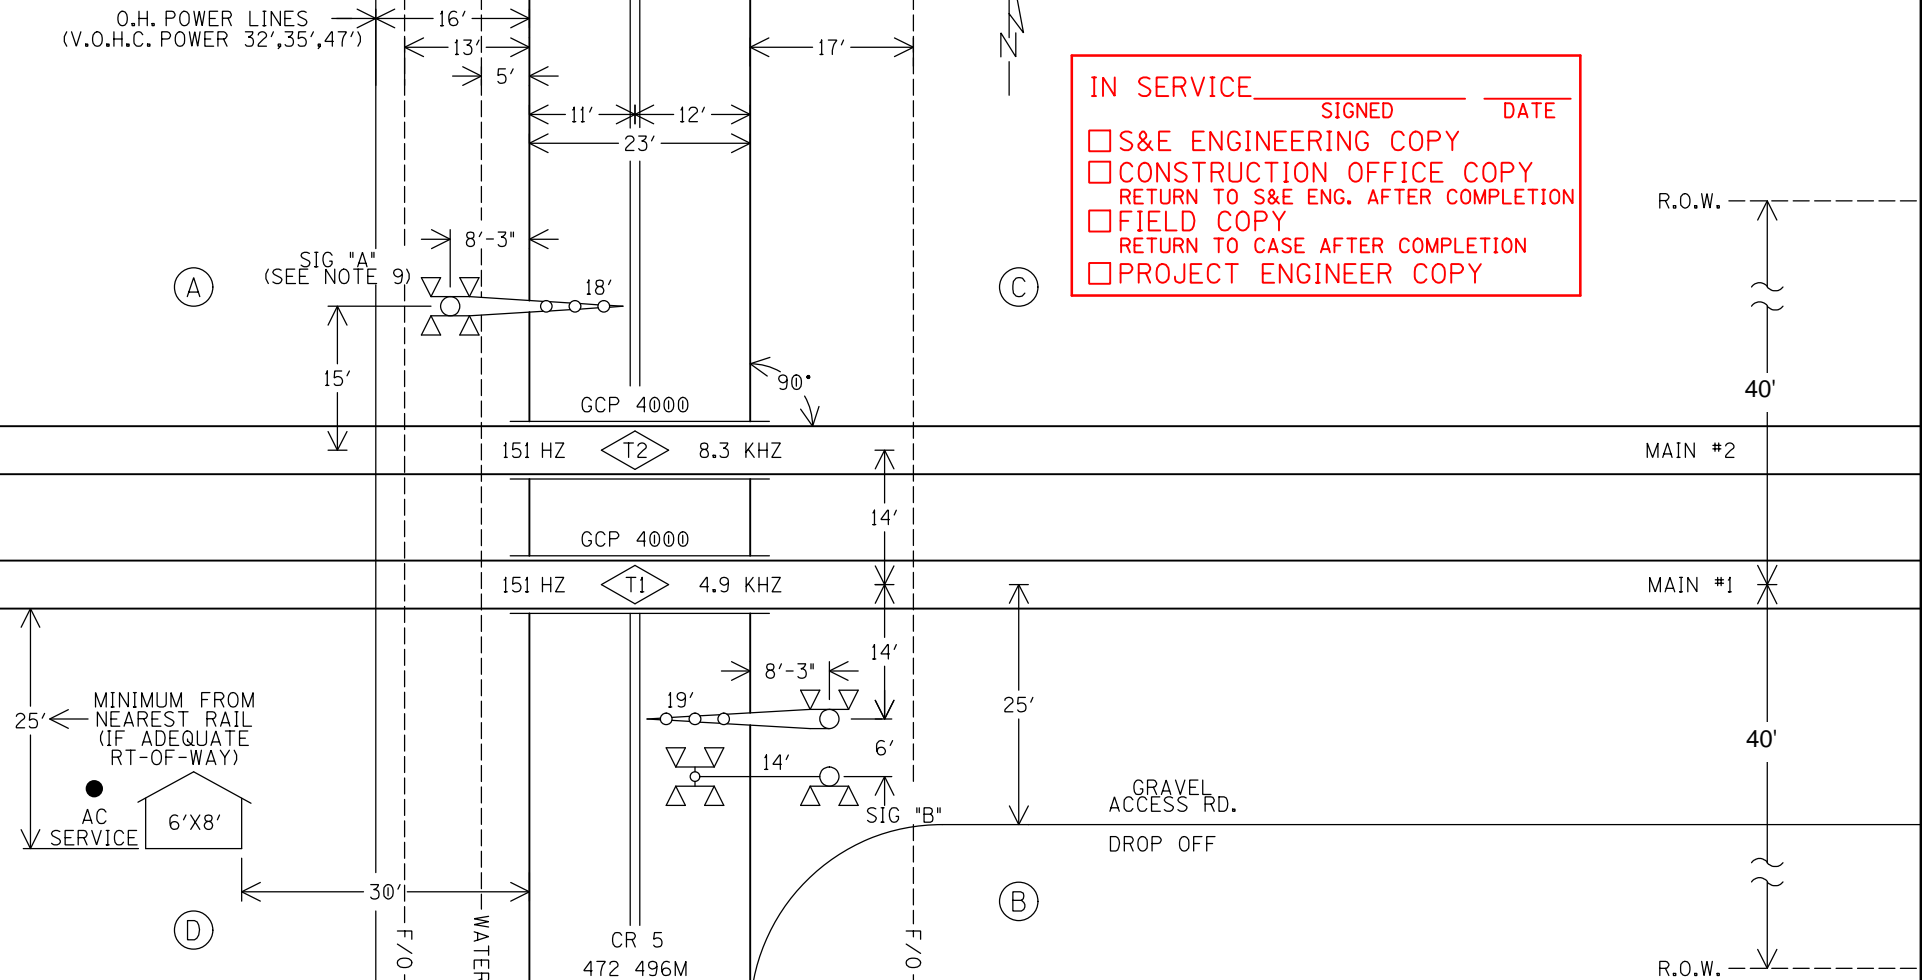

SCALE: 1" = 20'
PROJECT #10.3208

LAYOUT

FILE TBA
NO.

DESIGNED BY:	JWB 05-09-18	NS NORFOLK SOUTHERN	
DRAWN BY:	IRE 05-09-18	OFFICE OF ASS'T. VICE PRESIDENT COMM. & SIGNAL, ATLANTA, GA.	M.P.: B-309.48
CHECKED BY:	DBS 05-10-18	LEIPSIC, OH CFLGS AT CR 5	
IN SERVICE:	- -	FOSTORIA DISTRICT	FILE NO. R-
		CADD or DWG. No. FSBT30948.01	SHEET No. 1 of 23

REVISION
INITIALS

PROPERTY
NORFOLK SOUTHERN RAILWAY CO.

**Round Figure Estimate for Grade Crossing Warning Devices**

City/State: LEIPSIC, OH

MilePost: B-309.48

State Proj. No.: PID 106851

S&E Proj. No.: 10.3208

Man Days: 228

Road: CR 5

DOT/AAR: 472496M

County: PUTMAN

File Number: 061-10.0232

Purchases - Others		
Meals and Lodging:	\$31,187.12	
Rental of Equipment:	\$42,632.67	
(2 Trucks, 1 Backhoe w/ Trailer and 1 Pipe-Pusher for 38 Days)		
Construction Supervision Vehicle:	\$6,521.37	
Purchases - Other Total:		\$80,341.16
Material And Additives		
Material Cost:	\$142,238.00	
Sales and Use Tax:	\$11,379.00	
Material Handling Freight:	\$14,223.82	
Material Total:		\$167,840.82
Labor And Additives		
Labor Cost:	\$73,416.00	
(6 man crew at \$1,932.00 a day for: 38 days)		
Payroll Tax & Overheads:	\$62,594.48	
Preliminary Engineering:	\$22,643.70	
Construction Supervision:	\$21,444.81	
Labor Total:		\$180,098.99
Project Cost:		\$428,280.97
Scrap / Salvage Credit:		\$0.00
Project Total:		\$428,281.00

Estimated on: 12-Jun-18

Estimated by: ndney

Estimate valid for 1 year from date of estimate



Highway Crossing Signalization Program - Material List

Do not substitute items without permission from S & E Engineering

City:	LEIPSIC
Road:	CR 5
Mile Post:	B-309.48
Drawing Number:	FSBT30948
State ProjectNumber:	PID 106851
County:	PUTMAN
A A R Number:	472496M
Project Number:	10.3208
File Number:	061-10.0232
New File Number:	
WBS:	F-05074
Store Number:	
Supervisor:	UNKNOWN
Tax Code:	
Vendor to supply the following copies after pricing: 1 Set - Material Management with original Invoice 2 Sets - with plans shipped in car with material 1 Set - S&E Gen. Supt. Construction w/copy of invoice	

Qty.	Class-Item-CD	UI	Price per Item	Total Price	Item Description	Quantity Shipped	Quantity Date Quan.	Quantity Date Quan.	Quantity Date Quan.	Quantity Returned (Credit)	Special Instructions
3	670-360693-4	EA	\$5.55	\$16.65	AAR/DOT NUMBER PLATE/DECAL, ORDER 3 PER PROJECT. 60 DAY LEAD TIME. SUPPLIED BY S'TRAN.						
1	165-006505-4	EA	\$1,075.23	\$1,075.23	AC SERVICE, COMPLETE LESS METER BASE, ASSEMBLED ON 30' POLE						
4	670-119241-4	EA	\$25.01	\$100.04	ARRESTOR, LIGHTNING HEAVY DUTY CLEAR VIEW SAFETRAN 022585-1X						
20	105-002620-4	EA	\$248.79	\$4,975.80	BATTERY, NICAD 340AH, MODEL SPL340						
1	670-503047-4	EA	\$183.15	\$183.15	BELL, CROSSING ELECTRONIC GENERL SIGNAL, EB-3-360-5 CR 02-044350						
2	670-980689-4	EA	\$75.48	\$150.96	BRACKET HIGH WIND, (RIGID 3'), WIG- 191036, WALRUS TUSK TYPE						
2	670-561375-4	EA	\$1,197.90	\$2,395.80	BRACKET, GATE SAVER, NEG385102GS, SPRING LOADED SWING AWAY ADAPTER FOR FIBERGLASS/ALUMINUM GATES, USE WITH GATE 38' AND LESS						
1	670-356949-4	EA	\$94.05	\$94.05	CABLE, 10' GENERATOR HOOK UP, SERRMI P/N 40524. FEMALE CONNECTOR						
500	465-939422-4	LF	\$2.92	\$1,460.00	CABLE, UG 12 CONDUCTOR NO 14 AWG SOLID EACH CONDUCTOR WITH 5/64 IN INSULATION 10 MIL						
600	465-292862-4	LF	\$1.49	\$894.00	CABLE, UG 2-6 TWISTED, S-23 OKONITE 113-12-3933 SOLID TINNED CONDUCTOR						
500	465-292929-4	LF	\$4.12	\$2,060.00	CABLE, UG 5 COND. NO. 6 AWG SOLID COPPER CABLE TO MEET NS CORP. SPEC. FOR SIGNAL						
2200	465-954727-4	LF	\$1.83	\$4,026.00	CABLE, UG 7 CONDUCTOR NO 14 AWG SOLID EACH CONDUCTOR WITH 5/64 IN INSULATION 10 MIL FLAT						
2400	465-791835-4	FT	\$3.54	\$8,496.00	CABLE, UG AC ENTRANCE 3C#6-7X OKONITE FMPF-L 094-078 TR W/G 1 X 8 7X W010 BRZ TAPE 600V PRODUCT CODE 206-11-6070						
1	670-692686-4	EA	\$2,562.44	\$2,562.44	CANTILEVER, WT/F ARM 14' W/WALKWAY KIT SAFTRAN #071294-14NS1						
1	670-010671-4	EA	\$738.15	\$738.15	CHARGER, BATTERY CRAGG MODEL 40 DTC-12V, 40 AMP, P/N 520940						
1	670-010672-4	EA	\$960.15	\$960.15	CHARGER, BATTERY CRAGG MODEL 60 DTC-12V, 60 AMP, P/N 520960						

APPROVED BY STATE	APPROVED BY RAILROAD	CAR NUMBER	SEAL NUMBER
-------------------	----------------------	------------	-------------

Qty.	Class-Item-CD	UI	Price per Item	Total Price	Item Description	Quantity Shipped	Quantity Installed			Quantity Returned (Credit)	Special Instructions
4	670-664917-4	EA	\$87.64	\$350.56	CONNECTOR KIT, WELDED FAR RAIL, CONSISTING OF RUBBER HOSE PROPERLY DRILLED, BONDSTRAND, 1 SPLICING SLEEVE, 1 REDUCING SLEEVE, 3 CLAMPS, 1 TRACK CLIP, 1 WEB WELDED TRACK CONNECTOR, 1 WELD METAL, SAFETRAN 111359-2X		Date Quan.	Date Quan.	Date Quan.		
4	670-632520-4	EA	\$79.69	\$318.76	CONNECTOR KIT, WELDED NEAR RAIL, CONSISTING OF, RUBBER HOSE PROPERLY DRILLED, BONDSTRAND, SPLICING SLEEVE, 1 REDUCING SLEEVE, 5 CLAMPS, 1 TRACK CLIP, 1 WEB WELDED TRACK CONNECTOR, 1 WELD METAL, SAFETRAN 111359-1X						
2	670-793404-4	EA	\$1,159.00	\$2,318.00	COUNTERWEIGHT PKAGE, 17-24'GATE S'TRAN S- MECH ONLY, STAINLESS, TO INCLUDE HUB, SUPPORT ARMS						
6	670-760012-4	EA	\$44.32	\$265.92	COVER, FOR 1 WAY FLASHING LIGHT ASSY. 18 OZ. BLACK VINYL COATED NYLON. =====TO COVER 2 LAMPS=====						
1	670-986650-4	EA	\$370.21	\$370.21	DISPOSAL, CONSTRUCTION DEBRIS AND CLEANING X'ING EQUIPMENT CONTAINER						
1	670-000004-4	EA	\$700.00	\$700.00	FCC LICENSE FOR MONITOR/RADIO						
12	670-000003-4	EA	\$255.85	\$3,070.20	FILL/STONE #57, QUANTITY IS BASED ON TRUCK LOAD PLUS DELIVERY COST						
1	670-744631-4	EA	\$3,154.39	\$3,154.39	FOUNDATION, CFLS FOR SAFETRAN MODEL "WT/F" ARMS 12' TO 30' SINGLE MAST, DIXIE# DP4B-SM12-26-4, 5'10" CR 02-205902						
2	670-015231-4	EA	\$599.40	\$1,198.80	FOUNDATION, DIXIE,S-2 GATE 2'6"X2'6"X5'6" ASSEMBLED						
2	670-005377-4	EA	\$338.00	\$676.00	GATE ARM, ALUMINUM, 17-24 FT, ARM ASSEMBLY, INCLUDES GATE GUARD FOR GATE LIGHT CABLE. HIGH INTENSITY VERTICAL STRIPES.						
1	670-698491-4	EA	\$35,113.24	\$35,113.24	GCP4000 - 2 TRK (2TC) - REDUNDANT - 40/60 AMP WIRED RACK EQUIP. FOR 6X8 XING SHELTER, (INCL. 2 TRK CHASSIS A80465, 4 TRK MODS. A80418, 2-SSCC A80405, 2 CPU A80403, 1 SEAR A80410, 1 DISPLAY A80407, 1 TRANS MOD. A80468, 1-40 & 1-60 AMP CHARGER) IPN: 003131-						
1	670-245212-4	EA	\$10,865.86	\$10,865.86	GCP4000 - 2 TRK (5TC) - NON-REDUNDANT (INCL. 5 TRK CHASSIS A80440, 2 TRK MODS. A80418, 0 SSCC, 1 CPU A80403, NO SEAR, 1 DISPLAY A80407)						
1	670-477991-4	EA	\$410.00	\$410.00	KIT, GROUNDING ASSY FOR AL I/S INCLUDES 8 GRD RDS,200'#4WIRE,12 4 WIRE ONE-SHOTS. ERICO SBK206						

APPROVED BY STATE	APPROVED BY RAILROAD	CAR NUMBER	SEAL NUMBER
-------------------	----------------------	------------	-------------

Qty.	Class-Item-CD	UI	Price per Item	Total Price	Item Description	Quantity Shipped	Quantity Installed			Quantity Returned (Credit)	Special Instructions
Date	Quan.	Date	Quan.	Date	Quan.						
1	670-123298-4	EA	\$345.97	\$345.97	KIT, HARDWARE SUPPLIES REQUIRED X'ING P'CKAGES. WEB CONNECTORS FOR SHUNT(8EA) TAPE, AMPS,P'GUM PAINT,SLEEVES,TAGS,GLUE, 100 EA WHITE TAGS,)NE CAN BLUE MARKING PAINT ETC...						
2	670-092155-4	EA	\$160.00	\$320.00	LAMP ASSY, LED GATE ARM KIT (INCLUDES 3 LAMPS COMPLETE WITH CABLES AND MTG. HARDWARE) REC #: 9298-1120						
1	670-005054-4	EA	\$921.25	\$921.25	LAMP ASSY, LED, 12" MAST 1 WAY FRONT LIGHTS (IPN: 042003-L489XNS)						
2	670-005057-4	EA	\$952.05	\$1,904.10	LAMP ASSY, LED, 4" CANT JURY ARM MAST (FRONT OR BACK) (IPN: 042003-L001534)						
1	670-005066-4	EA	\$959.37	\$959.37	LAMP ASSY, LED, 5" MAST 1 WAY BACK LIGHTS (IPN: 042003-L001493)						
1	670-005058-4	EA	\$1,786.08	\$1,786.08	LAMP ASSY, LED, 5" MAST BACK TO BACK LIGHTS (IPN: 042003-L487XNS)						
4	670-440826-4	EA	\$2.22	\$8.88	LINK, SAFETLAN 024620-1X INSL TESTING COMP 1 IN CENTER SIGNAL CIRCUITS CR 02-286662						
5	255-590880-4	EA	\$16.72	\$83.60	LOCK, AMERICAN LOCK MODEL H-10KA KEYED ALIKE TO PRIVATE KEYWAY D456 AND STAMPED "NS SIG"						
1	670-179911-4	EA	\$4,436.00	\$4,436.00	MAST, 12" CANTILEVER, FOR 12'-20' WT/F ARMS, INCL. LADDER KIT (IPN: 071271-20NS)						
2	670-637778-4	EA	\$1,325.00	\$2,650.00	MAST, 5" ALUMINUM 13'10" WITH DOUBLE JCT. BOX BASE. S'TLAN P# 070519-11AX.						
2	670-521147-4	EA	\$3,715.27	\$7,430.54	MECHANISM, GATE MODEL S-40, WITH CONTACT HEATER, COMPLETE W/RELAY S'TLAN # 074000-W00090						
2	000-000000-4	EA	\$7,000.00	\$14,000.00	MISC. EXPENSE, UNDERGROUND BORING						
2	670-001355-4	EA	\$74.00	\$148.00	PACKAGE, HARDWARE SIGN 12 IN. (USE WITHWT/F MAST) MOUNTING, SERRMI A1250-8, HARMON @180004/0007,						
2	670-001347-4	EA	\$59.67	\$119.34	PACKAGE, HARDWARE SIGN 5 IN. MOUNTING, SERRMI A1250-5, HARMON @200965-000, OR						
1	255-646807-4	EA	\$32.59	\$32.59	PADLOCK, SAFETLAN PART NO. 030399-29X SCREW TYPE FOR CIR CONTROLLER AND BTY. BOX						
1	670-514605-4	EA	\$11.11	\$11.11	PINNACLE, W-C SECT 1-11, 4"& 5" REF K1 110-8 OR SAFETLAN NO. @035045-503X						

APPROVED BY STATE	APPROVED BY RAILROAD	CAR NUMBER	SEAL NUMBER
-------------------	----------------------	------------	-------------

Qty.	Class-Item-CD	UI	Price per Item	Total Price	Item Description	Quantity Shipped	Quantity Installed			Quantity Returned (Credit)	Special Instructions
2	670-259211-4	EA	\$47.25	\$94.50	PLUG BOARD KIT, TYPE B-1 & VOLTAGE TEST TERMINAL, SAFETRAN 420000-75X		Date Quan.	Date Quan.	Date Quan.		
1	165-902002-4	EA	\$303.43	\$303.43	PROTECTOR, SURGE 120/240VAC, ERICO P/N EPD120/240TDFL						
6	465-002899-4	EA	\$22.24	\$133.44	REEL, CABLE DISPOSABLE FOR CROSSING SIGNAL PACKAGES						
2	670-456936-4	EA	\$145.69	\$291.38	RELAY RACK, SWING, FARADAY SHELTER FOR ONE RELAY, SSFETRAN P/N T15331						
2	670-707995-4	EA	\$510.12	\$1,020.24	RELAY, TYPE B1, NEV LINE, 900 OHMS,.008 AMPERES GRS A62- 308 OR SAFETRAN @400003						
2	435-805560-4	EA	\$2.78	\$5.56	SAND, 25LB BAG FOR CABLE ENTRANCE INTO THE SHELTER						
1	670-113448-4	EA	\$910.23	\$910.23	SEARIII, (VHFC w/ANTENNA) - VHF COMMUNICATOR, SAFETRAN P/N A80276, 1/ PER CROSSING						
1	670-749325-4	EA	\$237.18	\$237.18	SHELF, FOLDING, FOR LAPTOP USE IN FARADAY 6X8 SHELTER, SAFETRAN 052852-128X						
1	670-755523-4	EA	\$9,333.50	\$9,333.50	SHELTER, 6'X8' ALUMN FARADAY W/1EA EQUIPMENT RACK, W/CABLE CHUTES BEHIND TERMINAL BOARD, W/GEN RECEPTICAL, BREAKER BOX GFI OUTLET FOR LAPTOP SHELF SAFETRAN 058400-68-85						
6	670-586967-4	EA	\$42.98	\$257.88	SHUNT COVER W/LAG SCREWS, 19"X19", SERRMI #40271, ORDER 1 PER SHUNT						
4	670-868658-4	EA	\$899.80	\$3,599.20	SHUNT, MULTI-FREQ. #250849-000 FSS-1A ALSTOM NARROW BAND (86, 114, 151, 210, 267)						
2	670-688850-4	EA	\$369.89	\$739.78	SHUNT, MULTI-FREQ. #62775-3497 SAFETRAN NARROW BAND						
2	670-016346-4	EA	\$143.23	\$286.46	SIGN, X-BUCK, HI-INTENSIVE REFLECTIVE FRT. & BACK FOR ALL STATES, SAFETRAN# 035200-91X						
1	670-397239-4	EA	\$40.23	\$40.23	SIGN, CROSSING ENS MALFUNCTION ASSEMBLY FOR 12" MAST, SAFETRAN #T17216						
2	670-330382-4	RL	\$18.06	\$36.12	TAPE, THOR 3" DURATEC, ORANGE 1000' LENGTHS. "WARNING STOP DIGGING"						
9	670-478560-4	EA	\$20.56	\$185.04	TERMINAL BLOCK, ERICO 4 POST P/N B2700A2C1WH W/HARDWARE LESS LIGHTNING ARRESTOR						
1	670-007238-4	EA	\$118.65	\$118.65	UNIT, THE INSTALLATION AND WIRING OF A DEVICE WHICH REQUIRE A MINIMUM OF FOUR WIRE CONNECT-						

APPROVED BY STATE	APPROVED BY RAILROAD	CAR NUMBER	SEAL NUMBER
-------------------	----------------------	------------	-------------

Qty.	Class-Item-CD	UI	Price per Item	Total Price	Item Description	Quantity Shipped	Quantity Installed			Quantity Returned (Credit)	Special Instructions
							Date Quan.	Date Quan.	Date Quan.		
140	165-544477-4	FT	\$3.22	\$450.80	Z-DNO-CONDUIT, 4"x10' PVC, SCHEDULE 80 BELL CONNECTOR AT ONE END, 1/2 PT. GLUE IN KIT 670-123298-4						
1	670-393331-0	EA	\$37.43	\$37.43	Z-DNO-SIGN CROSSING MALFUNCTION ASSEMBLY FOR 4" AND 5" MAST						

Total Material: \$142,238.24

SH. NO.	CONTENTS
NX1	INDEX SHEET
NX2	OUT OF SERVICE (OOS) INSTRUCTIONS
1	LAYOUT
2	PROFILE
3	CABLE PLAN
4	LOAD CENTER
5	B12 & B16 CHARGERS & BATTERIES
6	4000 GCP 2-TK CHASSIS & MODULE LAYOUT
7	4000 GCP PROGRAMMING SETUP
8	4000 GCP PROGRAMMING SETUP
9	CONNECTORS FOR TRACK MODULES
10	CPU MODULE, SEAR IIi & VHF HOOK-UPS
11	SEAR IIi PROGRAMMING SETUP
12	SSCC#1 MODULE HOOK-UP
13	SSCC#2 MODULE HOOK-UP
14	CANTILEVER FLASHER LIGHTS
15	SIGNAL "A" S40 GATE & FLASHER CIRCUITS
16	SIGNAL "B" S40 GATE & FLASHER CIRCUITS
17	BACKBOARD 1A & 1B
18	REAR BACKBOARD 1A & 1B
19	FARADAY SHIELD 1A & 1B
20	FARADAY SHIELD 1C
21	HOUSE SIDE C LAYOUT & RACK PLACEMENT
22	HOUSE SIDE A LAYOUT
23	HOUSE SIDE B LAYOUT & TOP VIEW

IN SERVICE_____SIGNED_____DATE_____

☐ S&E ENGINEERING COPY

☐ CONSTRUCTION OFFICE COPY
RETURN TO S&E ENG. AFTER COMPLETION

☐ FIELD COPY
RETURN TO CASE AFTER COMPLETION

☐ PROJECT ENGINEER COPY

INDEX SHEET

REVISION INITIALS											PROPERTY NORFOLK SOUTHERN RAILWAY CO.	IN SERVICE:	FOSTORIA DISTRICT		No. R-
													- -	CADD or DWG. No. FSBT30948.NX1	SHEET 1 of 2

TAKING TRACK(S) OUT OF SERVICE (OOS):

SP-1001 MUST BE COMPLIED WITH

THE OUT OF SERVICE MENU IS ACCESSED ON THE DISPLAY BY TOUCHING THE DESIRED TRACK IN THE TRACK STATUS WINDOW ON THE DISPLAY. SELECT OUT OF SERVICE FROM THE DROP DOWN MENU.

PLACE A JUMPER ACROSS THE OOS TERMINALS SHOWN IN THE PLANS.

SP-1001 MUST BE COMPLIED WITH

SELECT "TAKE GCP OUT OF SERVICE."

ONCE THE GCP APPROACH IS TAKEN OUT OF SERVICE, IF AN ISLAND EXISTS, THE OPTION TO "TAKE ISL OUT OF SERVICE" IS PRESENTED. IF THE ISLAND IS LEFT IN SERVICE, THE CROSSING WILL ACTIVATE IF THE ISLAND IS OCCUPIED.

IF DESIRED, SELECT "TAKE ISL OUT OF SERVICE."

THE TRACK IS NOW OUT OF SERVICE. WHEN THE OUT OF SERVICE SCREEN IS CLOSED, THE DISPLAY RETURNS TO THE TRACK STATUS SCREEN. NOTE THAT THE OUT OF SERVICE TRACK IS ALTERNATELY FLASHING DARK GRAY AND LIGHT BLUE.

REPEAT FOR ADDITIONAL TRACKS IF NEEDED.

PUTTING TRACK(S) BACK IN SERVICE:

SP-1001 MUST BE COMPLIED WITH


REMOVE THE JUMPER ACROSS THE OOS TERMINALS SHOWN IN THE PLANS.

SP-1001 MUST BE COMPLIED WITH

OUT OF SERVICE (OOS) INSTRUCTIONS

REVISION
INITIALS

PROPERTY
NORFOLK SOUTHERN RAILWAY CO.

DESIGNED BY:	 NORFOLK SOUTHERN		
JWB 05-09-18			
DRAWN BY:	OFFICE OF ASS'T. VICE PRESIDENT COMM. & SIGNAL, ATLANTA, GA.		M.P.: B-309.48
IRE 05-09-18			
CHECKED BY:	LEIPSIC, OH CFLGS AT CR 5		
DBS 05-10-18			
IN SERVICE:	FOSTORIA DISTRICT		FILE No. R-
- -	CADD or DWG. No. FSBT30948.NX2		SHEET No. 2 of 2

TO FT. WAYNE
(R.R. WEST)
M.P. INCREASING

TO BELLEVUE
(R.R. EAST)
M.P. DECREASING

Ohio Utilities Protection Service

Call 811
before you dig



O.H. POWER LINES
(V.O.H.C. POWER 32',35',47')

IN SERVICE _____ SIGNED _____ DATE _____
☐ S&E ENGINEERING COPY
☐ CONSTRUCTION OFFICE COPY
RETURN TO S&E ENG. AFTER COMPLETION
☐ FIELD COPY
RETURN TO CASE AFTER COMPLETION
☐ PROJECT ENGINEER COPY

NOTES:

1. MAX. TRAIN SPEED BOTH TRACKS: 60 M.P.H.
2. LATITUDE N 41° 06' 19" LONGITUDE W 83° 57' 28" ELEVATION 757'
3. SIGNAL "A" TO HAVE BELL.
4. LOCATE U/G UTILITIES & CABLE BEFORE DIGGING.
5. CROSSING LOCATED IN PUTMAN COUNTY.
6. NEAREST STREET ADDRESS IS
5304 PROTEC PKWY.
7. NEAREST INTERSECTING STREET IS
SOUTH TO E. MATHIAS ST.
8. DISTANCE TO NEAREST INTERSECTING STREET IS 1204 FT.
9. 10 CUBIC YARDS OF FILL IS REQUIRED IN QUAD "A" FOR PROPER SIGNAL PLACEMENT.

(A) (B) (C) (D) = QUADRANT MARKERS


REVISION
INITIALS


PROPERTY
NORFOLK SOUTHERN RAILWAY CO.


SCALE: 1" = 20'
PROJECT #10.3208

LAYOUT



FILE NO. TBA

DESIGNED BY: JWB 05-09-18	 NORFOLK SOUTHERN	
DRAWN BY: IRE 05-09-18	OFFICE OF ASS'T. VICE PRESIDENT COMM. & SIGNAL, ATLANTA, GA.	M.P.: B-309.48
CHECKED BY: DBS 05-10-18	LEIPSIC, OH CFLGS AT CR 5	
IN SERVICE: - -	FOSTORIA DISTRICT	FILE NO. R-
	CADD or DWG. No. FSBT30948.01	SHEET No. 1 of 23

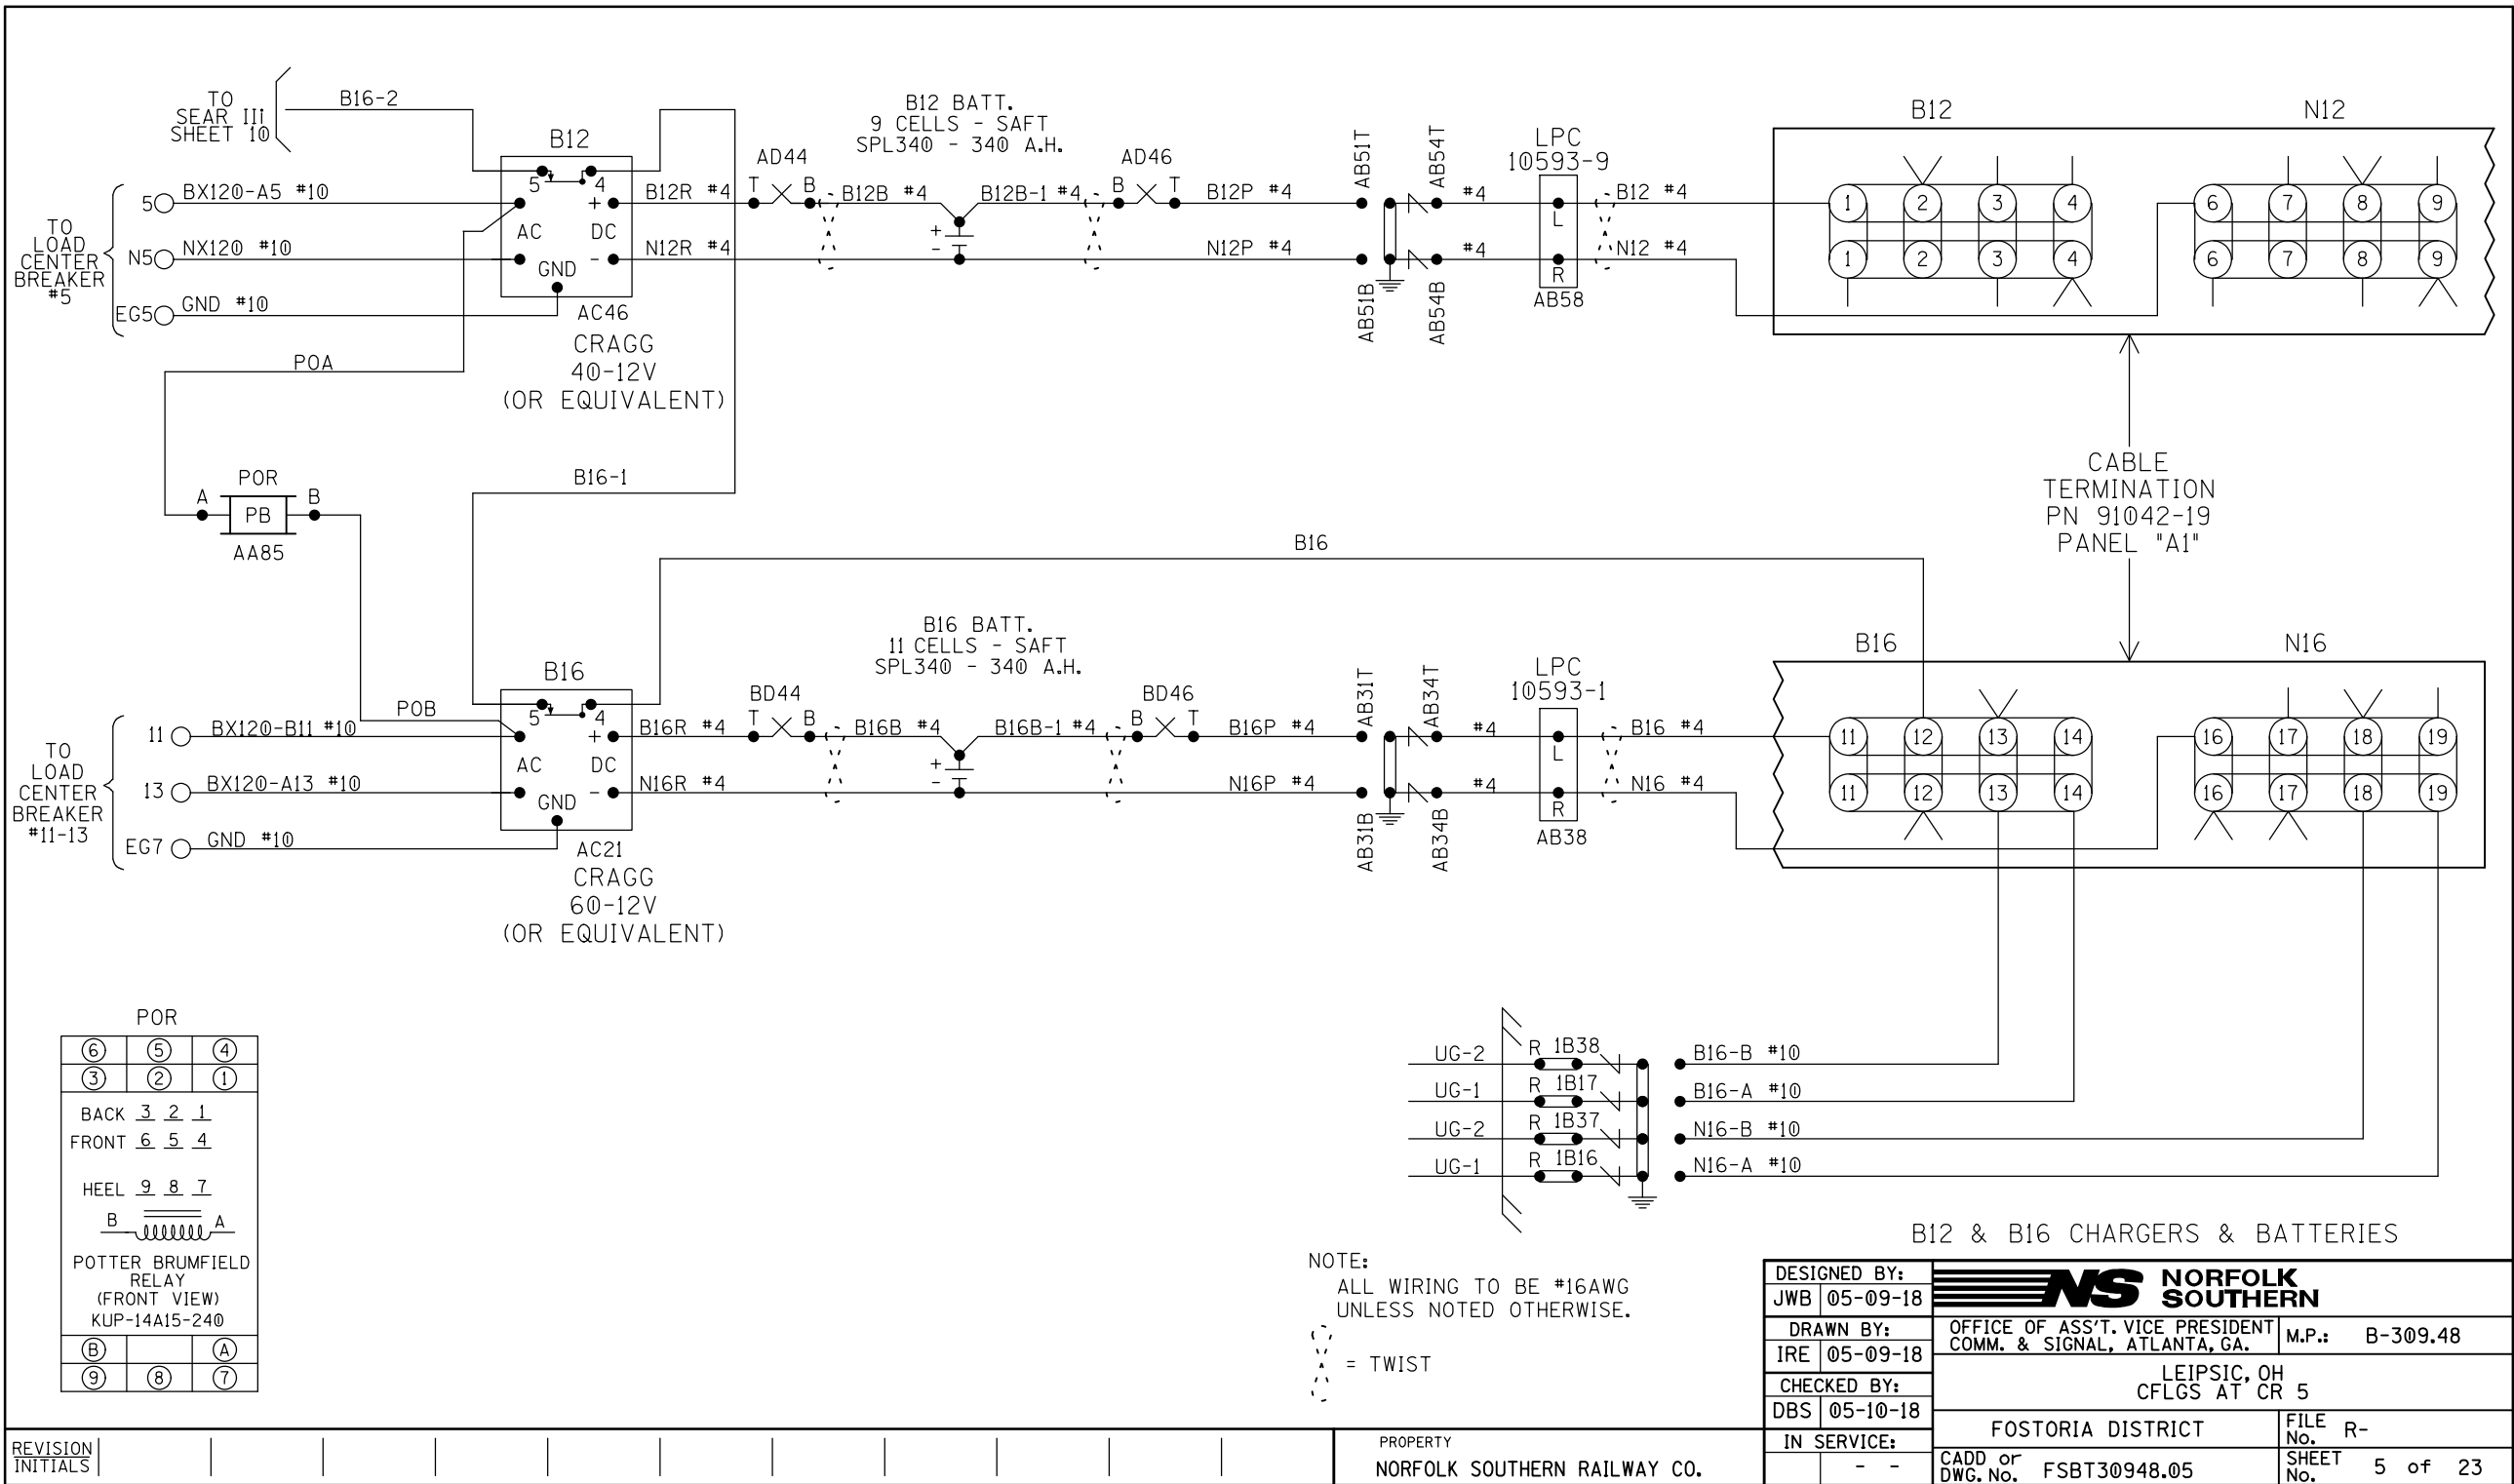

DESIGNED BY:		 NORFOLK SOUTHERN	
JWB	05-09-18		
DRAWN BY:		OFFICE OF ASST. VICE PRESIDENT COMM. & SIGNAL, ATLANTA, GA.	M.P.: B-309.48
IRE	05-09-18	LEIPSIC, OH CFLGS AT CR 5	
CHECKED BY:			
DBS	05-10-18		
IN SERVICE:		FOSTORIA DISTRICT	FILE No. R-
	- -	CADD or DWG. No. FSBT30948.07	SHEET No. 7 of 23


[illegible]

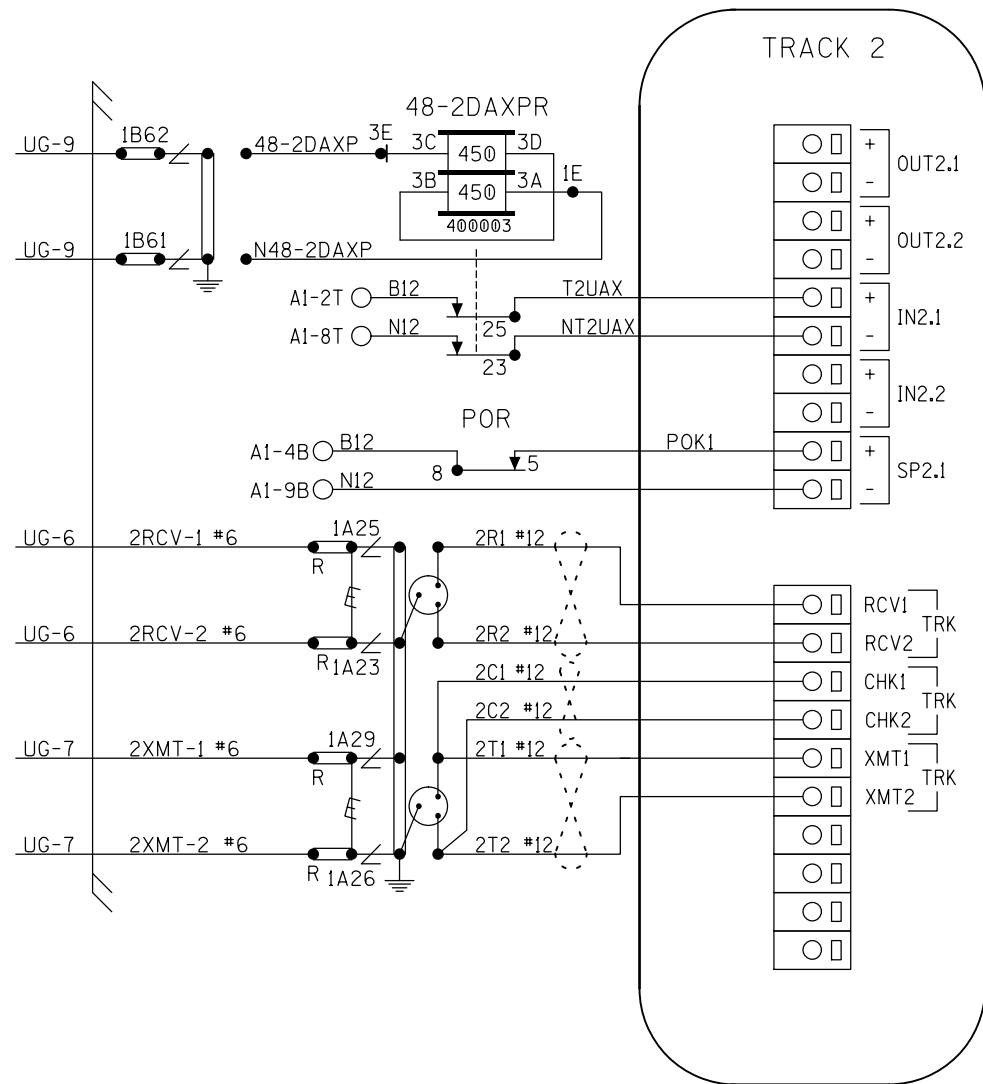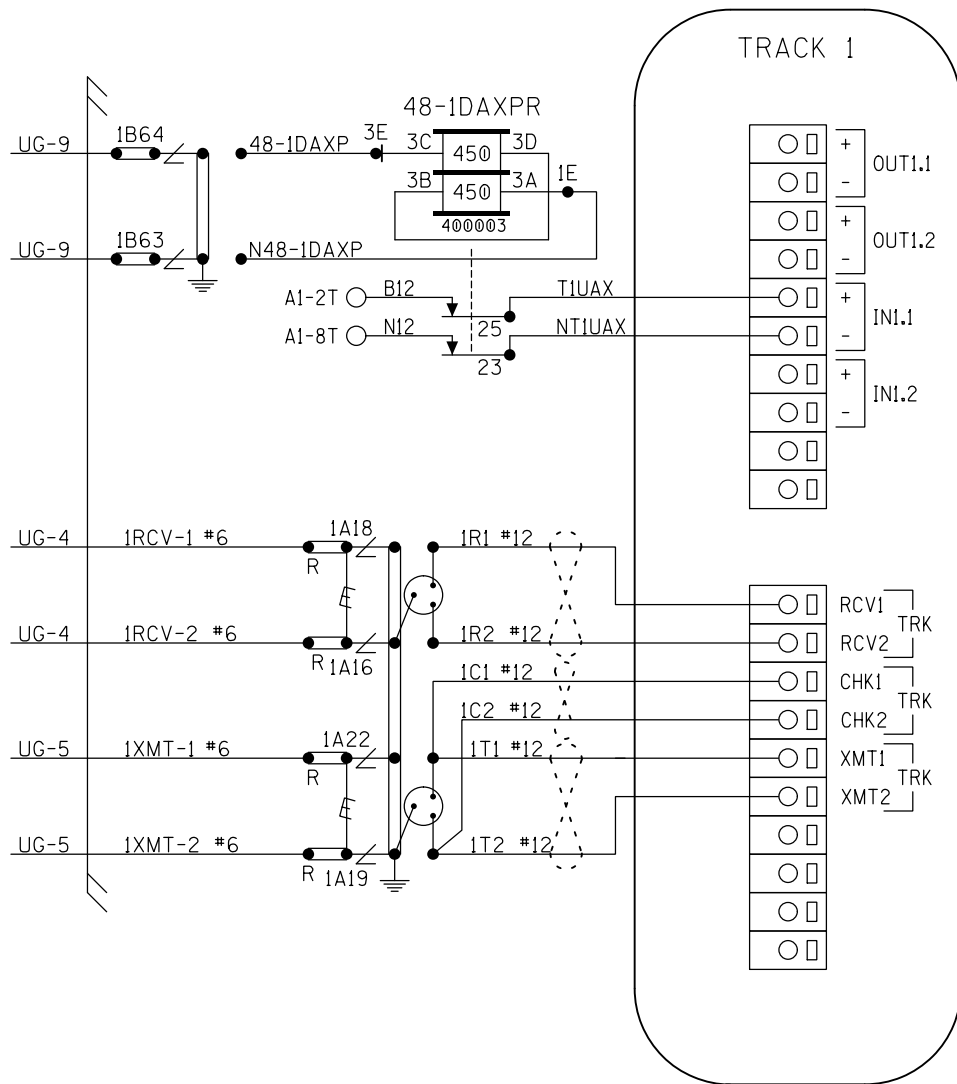

CONNECTORS FOR TRACK MODULES


NOTES:
ALL WIRING TO BE #16AWG
UNLESS NOTED OTHERWISE.

⋈ = TWIST

DESIGNED BY:		 NORFOLK SOUTHERN	
JWB	05-09-18		
DRAWN BY:		OFFICE OF ASS'T. VICE PRESIDENT	M.P.: B-309.48
IRE	05-09-18	COMM. & SIGNAL, ATLANTA, GA.	
CHECKED BY:		LEIPSIC, OH	
DBS	05-10-18	CFLGS AT CR 5	
IN SERVICE:		FOSTORIA DISTRICT	FILE No. R-
	- -	CADD or FSBT30948.09	SHEET 9 of 23
		DWG. No.	No.

REVISION
INITIALS

PROPERTY
NORFOLK SOUTHERN RAILWAY CO.

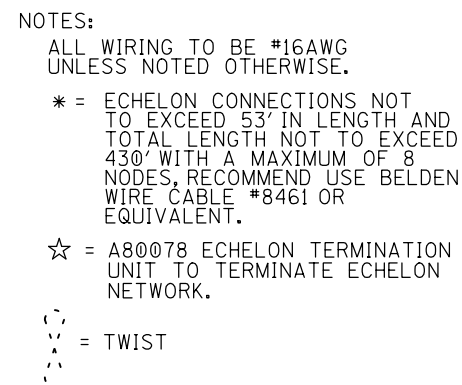

BLR

⑥	⑤	④
③	②	①

BACK 3 2 1


FRONT 6 5 4

HEEL 9 8 7

POTTER BRUMFIELD
RELAY
(FRONT VIEW)
KUMP-14D18-12

⑥		④
⑨	⑧	⑦

CPU MODULE, SEAR III
& VHF HOOK-UPS

DESIGNED BY:		 NORFOLK SOUTHERN	
JWB	05-09-18		
DRAWN BY:		OFFICE OF ASST. VICE PRESIDENT COMM. & SIGNAL, ATLANTA, GA.	M.P.: B-309.48
IRE	05-09-18	LEIPSIC, OH CFLGS AT CR 5	
CHECKED BY:			
DBS	05-10-18		
IN SERVICE:		FOSTORIA DISTRICT	FILE No. R-
	- -	CADD or DWG. No. FSBT30948.10	SHEET No. 10 of 23

SITE SET UP PROCEDURE	
FUNCTION	LED DISPLAY
DATE/TIME	
AUTOMATIC DST ADJUSTMENT	YES
TIME ZONE	EST
SITE NAME	CR 5
MILEPOST	B-309.48
DOT #	472496M
TESTER TYPE	CROSSING
DATE FORMAT	MM-DD-YYYY
TEMP FORMAT	FAHRENHEIT
INDICATE HOLD (SEC)	0
INDICATE REFRESH (SEC)	60
SITE ATCS	7.550.240.196.03.01
SITE TYPE	NO COMMUNICATION
** OFFICE ATCS ADDRESS	2.550.00.0000
** PRIMARY HOP ADDR	7.RRR.LLL.GGG.XX.XX
** BACKUP HOP ADDR 1	7.RRR.LLL.GGG.XX.XX
** BACKUP HOP ADDR 2	7.RRR.LLL.GGG.XX.XX
** POLL ID	1
** MODE	GEN/ATCS
** WAMS XID	DISABLED
** OFFICE COMM DEVICE	MCM (ECHELON)
** RADIO ATCS ADDR	7.RRR.LLL.GGG.01.01
** PHONE #	(OFFICE NUMBER)
** INIT STRING	
** FIELD COMM DEVICE	NONE
*** USER PORT BAUD	57600
*** USER PORT DATA BITS	8
*** USER PORT PARITY	NONE
*** USER PORT STOP BITS	1
*** USER PORT FLOW CONTROL	NONE
*** AUX PORT BAUD	9600
*** AUX PORT DATA BITS	8
*** AUX PORT PARITY	NONE
*** AUX PORT STOP BITS	1
*** AUX PORT FLOW CONTROL	NONE

CONTROL SYSTEM CONFIGURATION MENU QUESTIONS	
THE QUESTION	SELECT FROM MENU OPTION
RESET NAMES AND MODULES?	YES
RAILROAD NUMBER	550
CROSSING CONFIGURATION	NORMAL
AND 1 USED AS XR?	YES
AND 2 USED AS XR?	NO
AND 3 USED AS XR?	NO
AND 4 USED AS XR?	NO
AND 5 USED AS XR?	NO
AND 6 USED AS XR?	NO
AND 7 USED AS XR?	NO
AND 8 USED AS XR?	NO
* XR CONTROLLED BY FOREIGN RR	
ENTRANCE GATES	2
85% VOLTAGE RELAY OUT	YES
* GATES CONTROLLED BY FOREIGN RR	
BATTERY BANKS	2
BATTERY MON USED	NO
PREEMPTION	NO
INTERNAL CROSSING CONTROLLERS	2
EXTERNAL CROSSING CONTROLLERS	0
VHF COMMUNICATOR	YES
DTMF ACTIVATION	YES
**** ACTIVATION CODE	496
ACTIVATION TIMEOUT (SECONDS)	60
ILOD MODULES	0
***** ANY LED BULBS USED	
VHF VOICE CHANNEL	2
VHF DATA CHANNEL	2
USE CELL MODEM NON-CRITICAL FEATURE	NO

PROGRAM MENU QUESTIONS	PROGRAM
EDIT DIGITAL INPUTS	NO
EDIT BATTERIES	NO
EDIT RELAYS	NO
EDIT INDICATOR LEDS	NO
EDIT TEST LEDS	NO
EDIT ILOD SENSORS	NO
EDIT VHF SETTINGS	NO
GCP4K ATCS SUBNODE	16

NOTES:

* = DISPLAYED IF CROSSING CONFIGURATION IS SPLIT GATE.

** = IF SITE TYPE = NO COMMUNICATION, THEN THESE OPTIONS ARE NOT DISPLAYED.

*** = THESE SETTINGS SHOULD BE LEFT AT THE DEFAULT SETTING.


**** = USE LAST 3 NUMBERS FROM DOT NUMBER.

***** = IF ILOD MODULE >0.

TO CONFIGURE SEARIII PRESS SITE SETUP KEY.
USE ARROW KEYS TO MAKE SELECTION.
PRESS ENTER AFTER SELECTION HAS BEEN MADE.

PROPERTY
NORFOLK SOUTHERN RAILWAY CO.

DESIGNED BY:		NORFOLK SOUTHERN	
JWB	05-09-18	OFFICE OF ASS'T. VICE PRESIDENT COMM. & SIGNAL, ATLANTA, GA.	M.P.: B-309.48
DRAWN BY:		LEIPSIC, OH	
IRE	05-09-18	CFLGS AT CR 5	
CHECKED BY:		FOSTORIA DISTRICT	
DBS	05-10-18	FILE NO. R-	
IN SERVICE:		SHEET 11 of 23	
		CADD or DWG. No. FSBT30948.11	

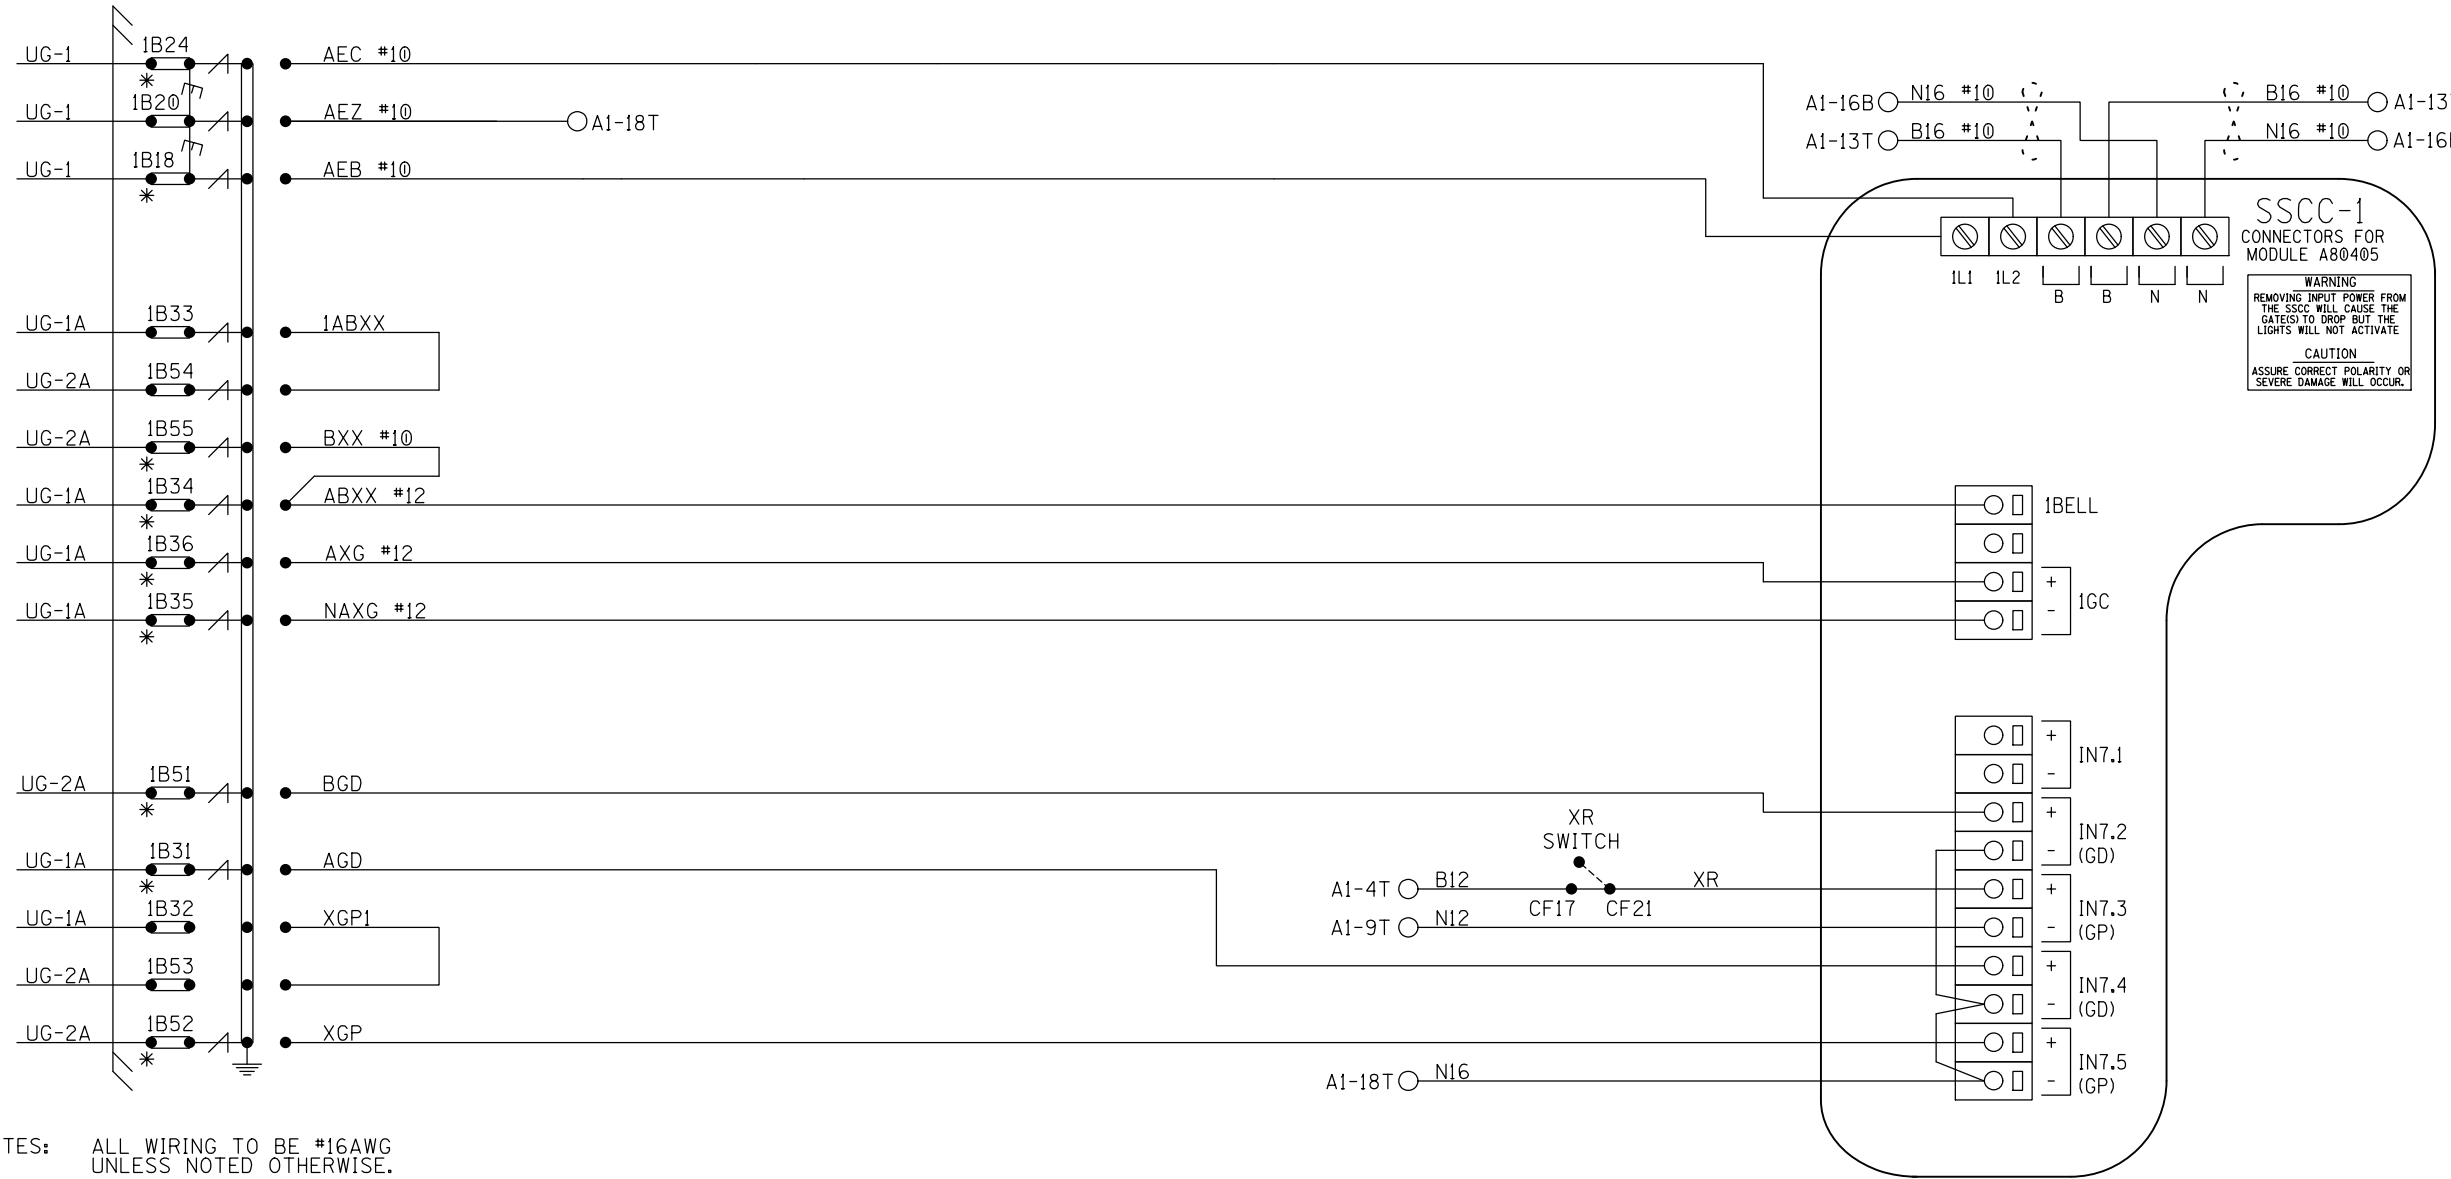


NOTES: ALL WIRING TO BE #16AWG
UNLESS NOTED OTHERWISE.


* = TEST LINKS MUST BE OPENED TEMPORARILY FOR NEW
COLD START OF NEW OR REPLACEMENT SSCC MODULE
AND CAN ONLY BE CLOSED IN SEQUENCE WITH MFR.
INSTRUCTIONS: SECTION 8 OF THE GCP 4000 REFERENCE MANUAL.

()
/ \
/ \
/ \
= TWIST



SSCC#1 MODULE HOOK-UP

REVISION INITIALS												PROPERTY NORFOLK SOUTHERN RAILWAY CO.	DESIGNED BY: JWB 05-09-18		NORFOLK SOUTHERN		FOSTORIA DISTRICT		FILE R-	
													IN SERVICE:				CADD or DWG. No. FSBT30948.12		SHEET	
																			12 of 23	

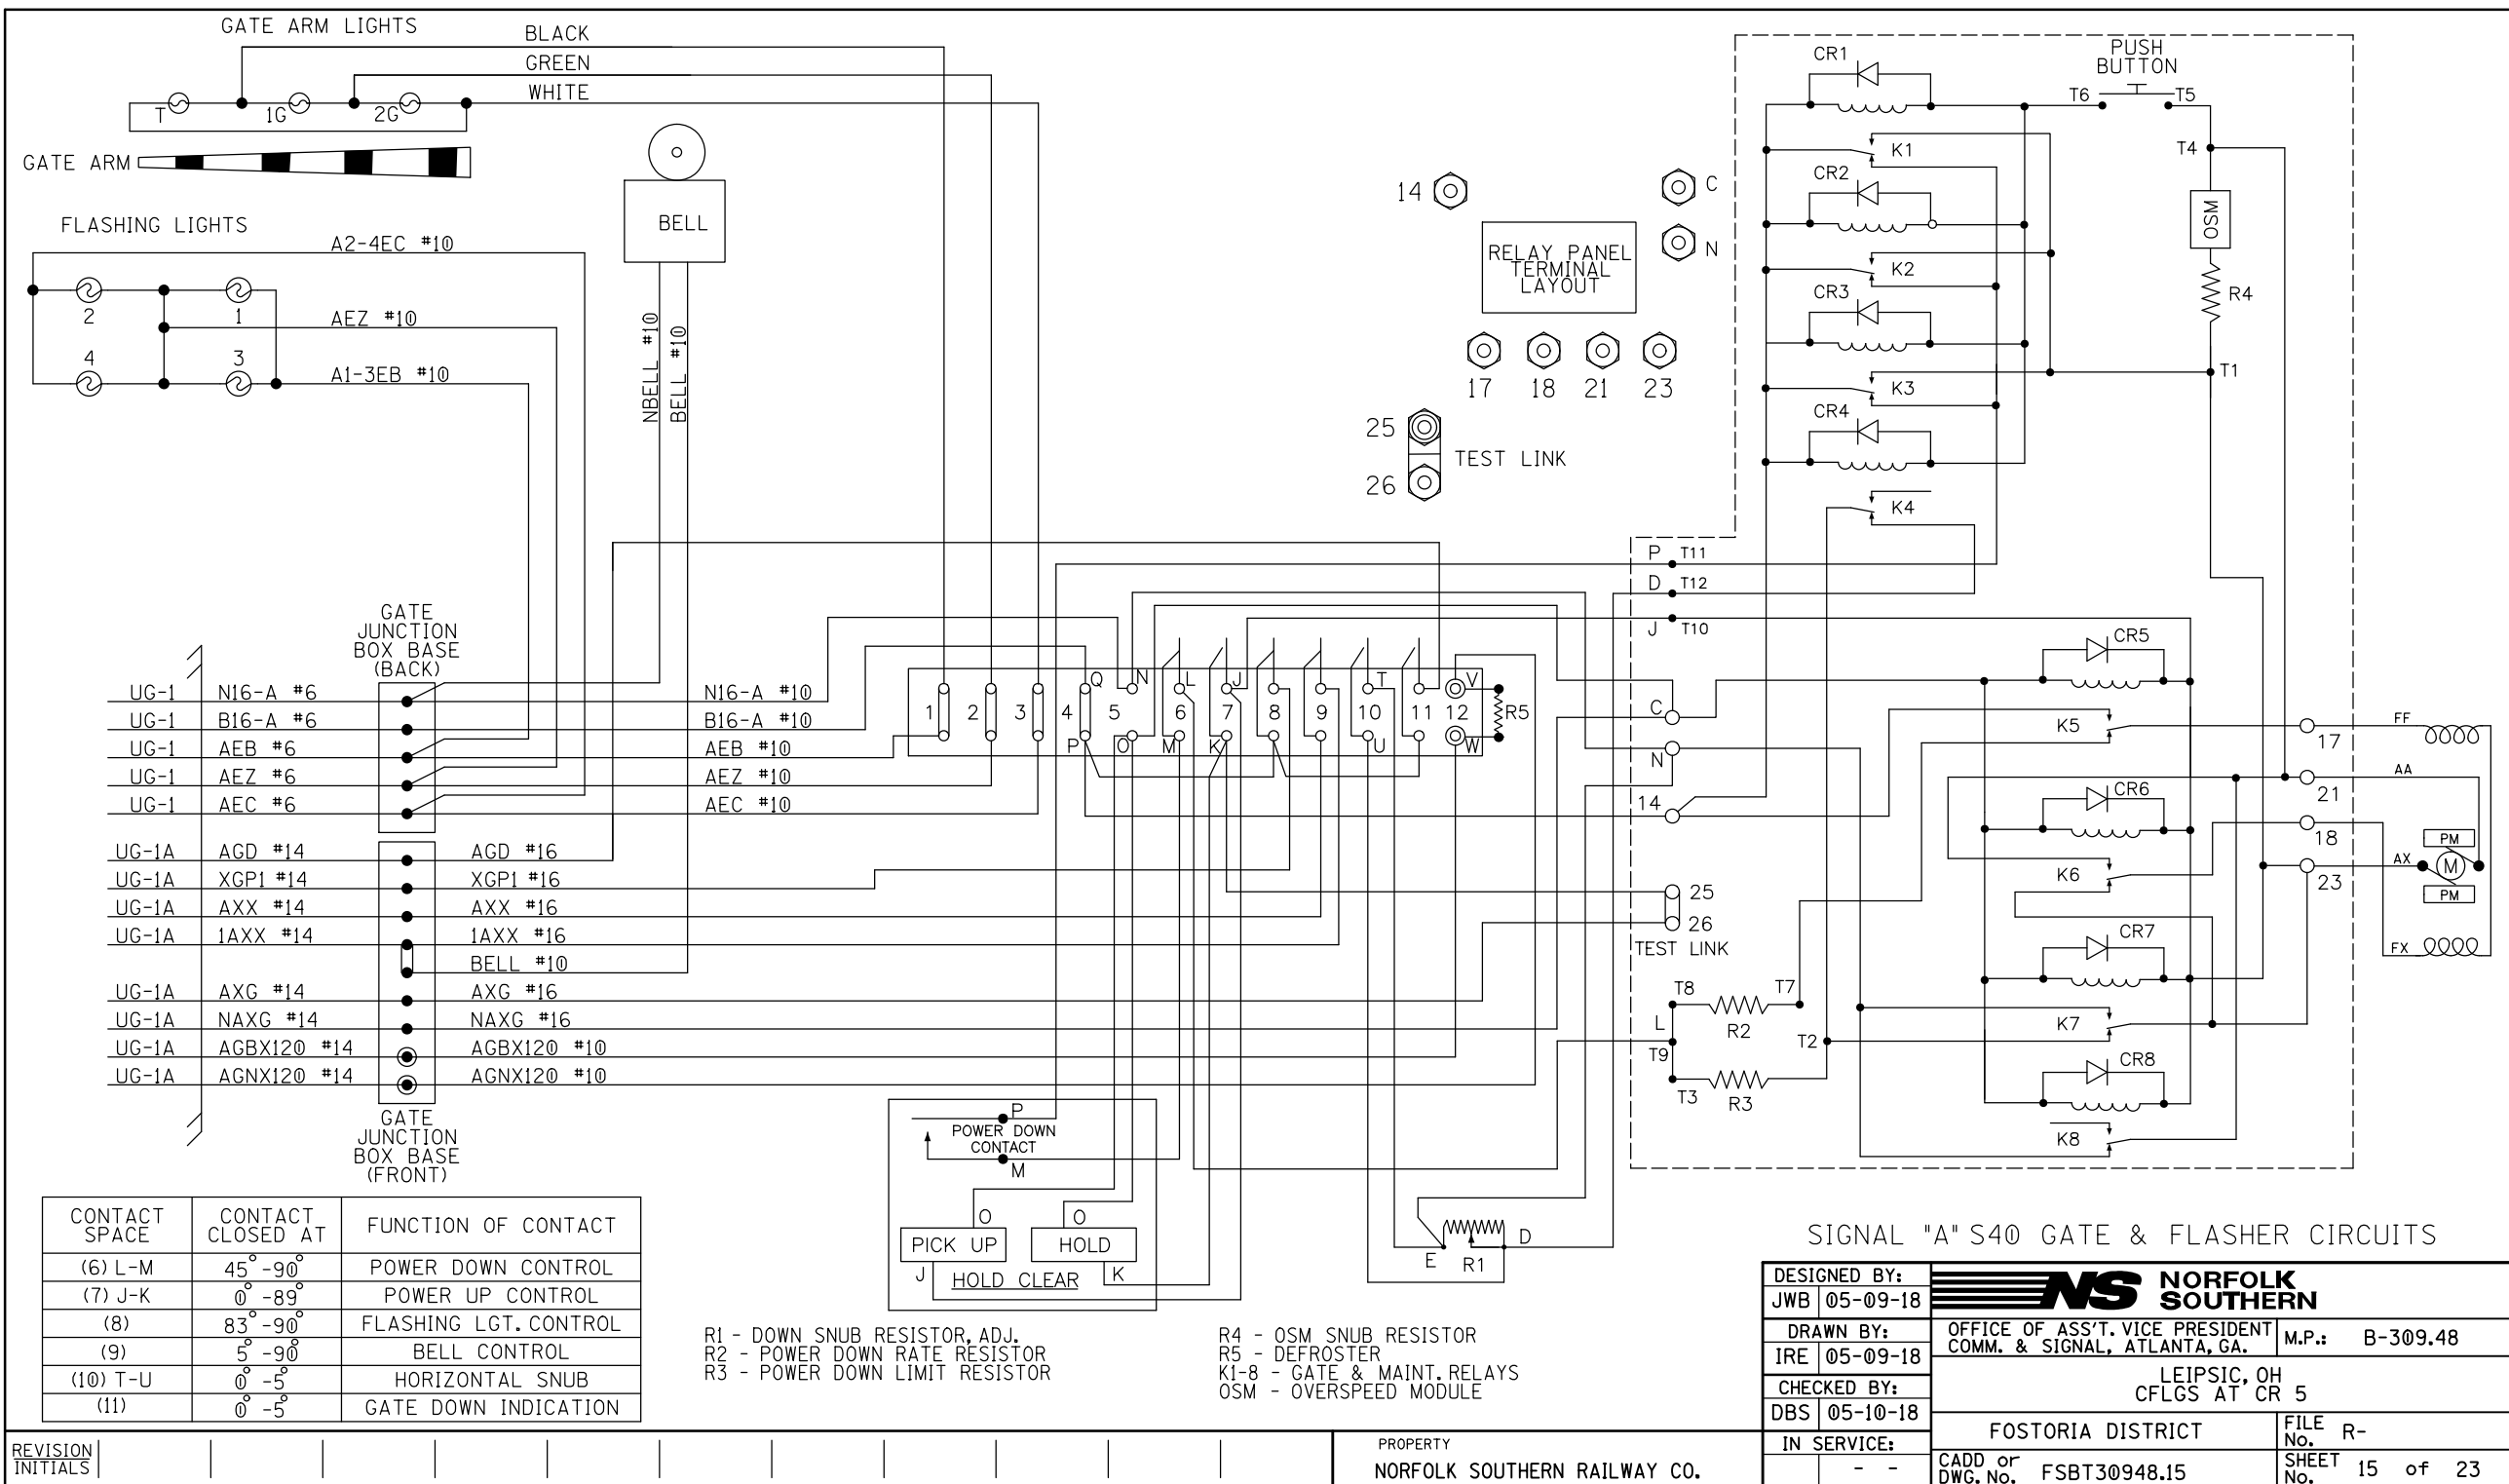

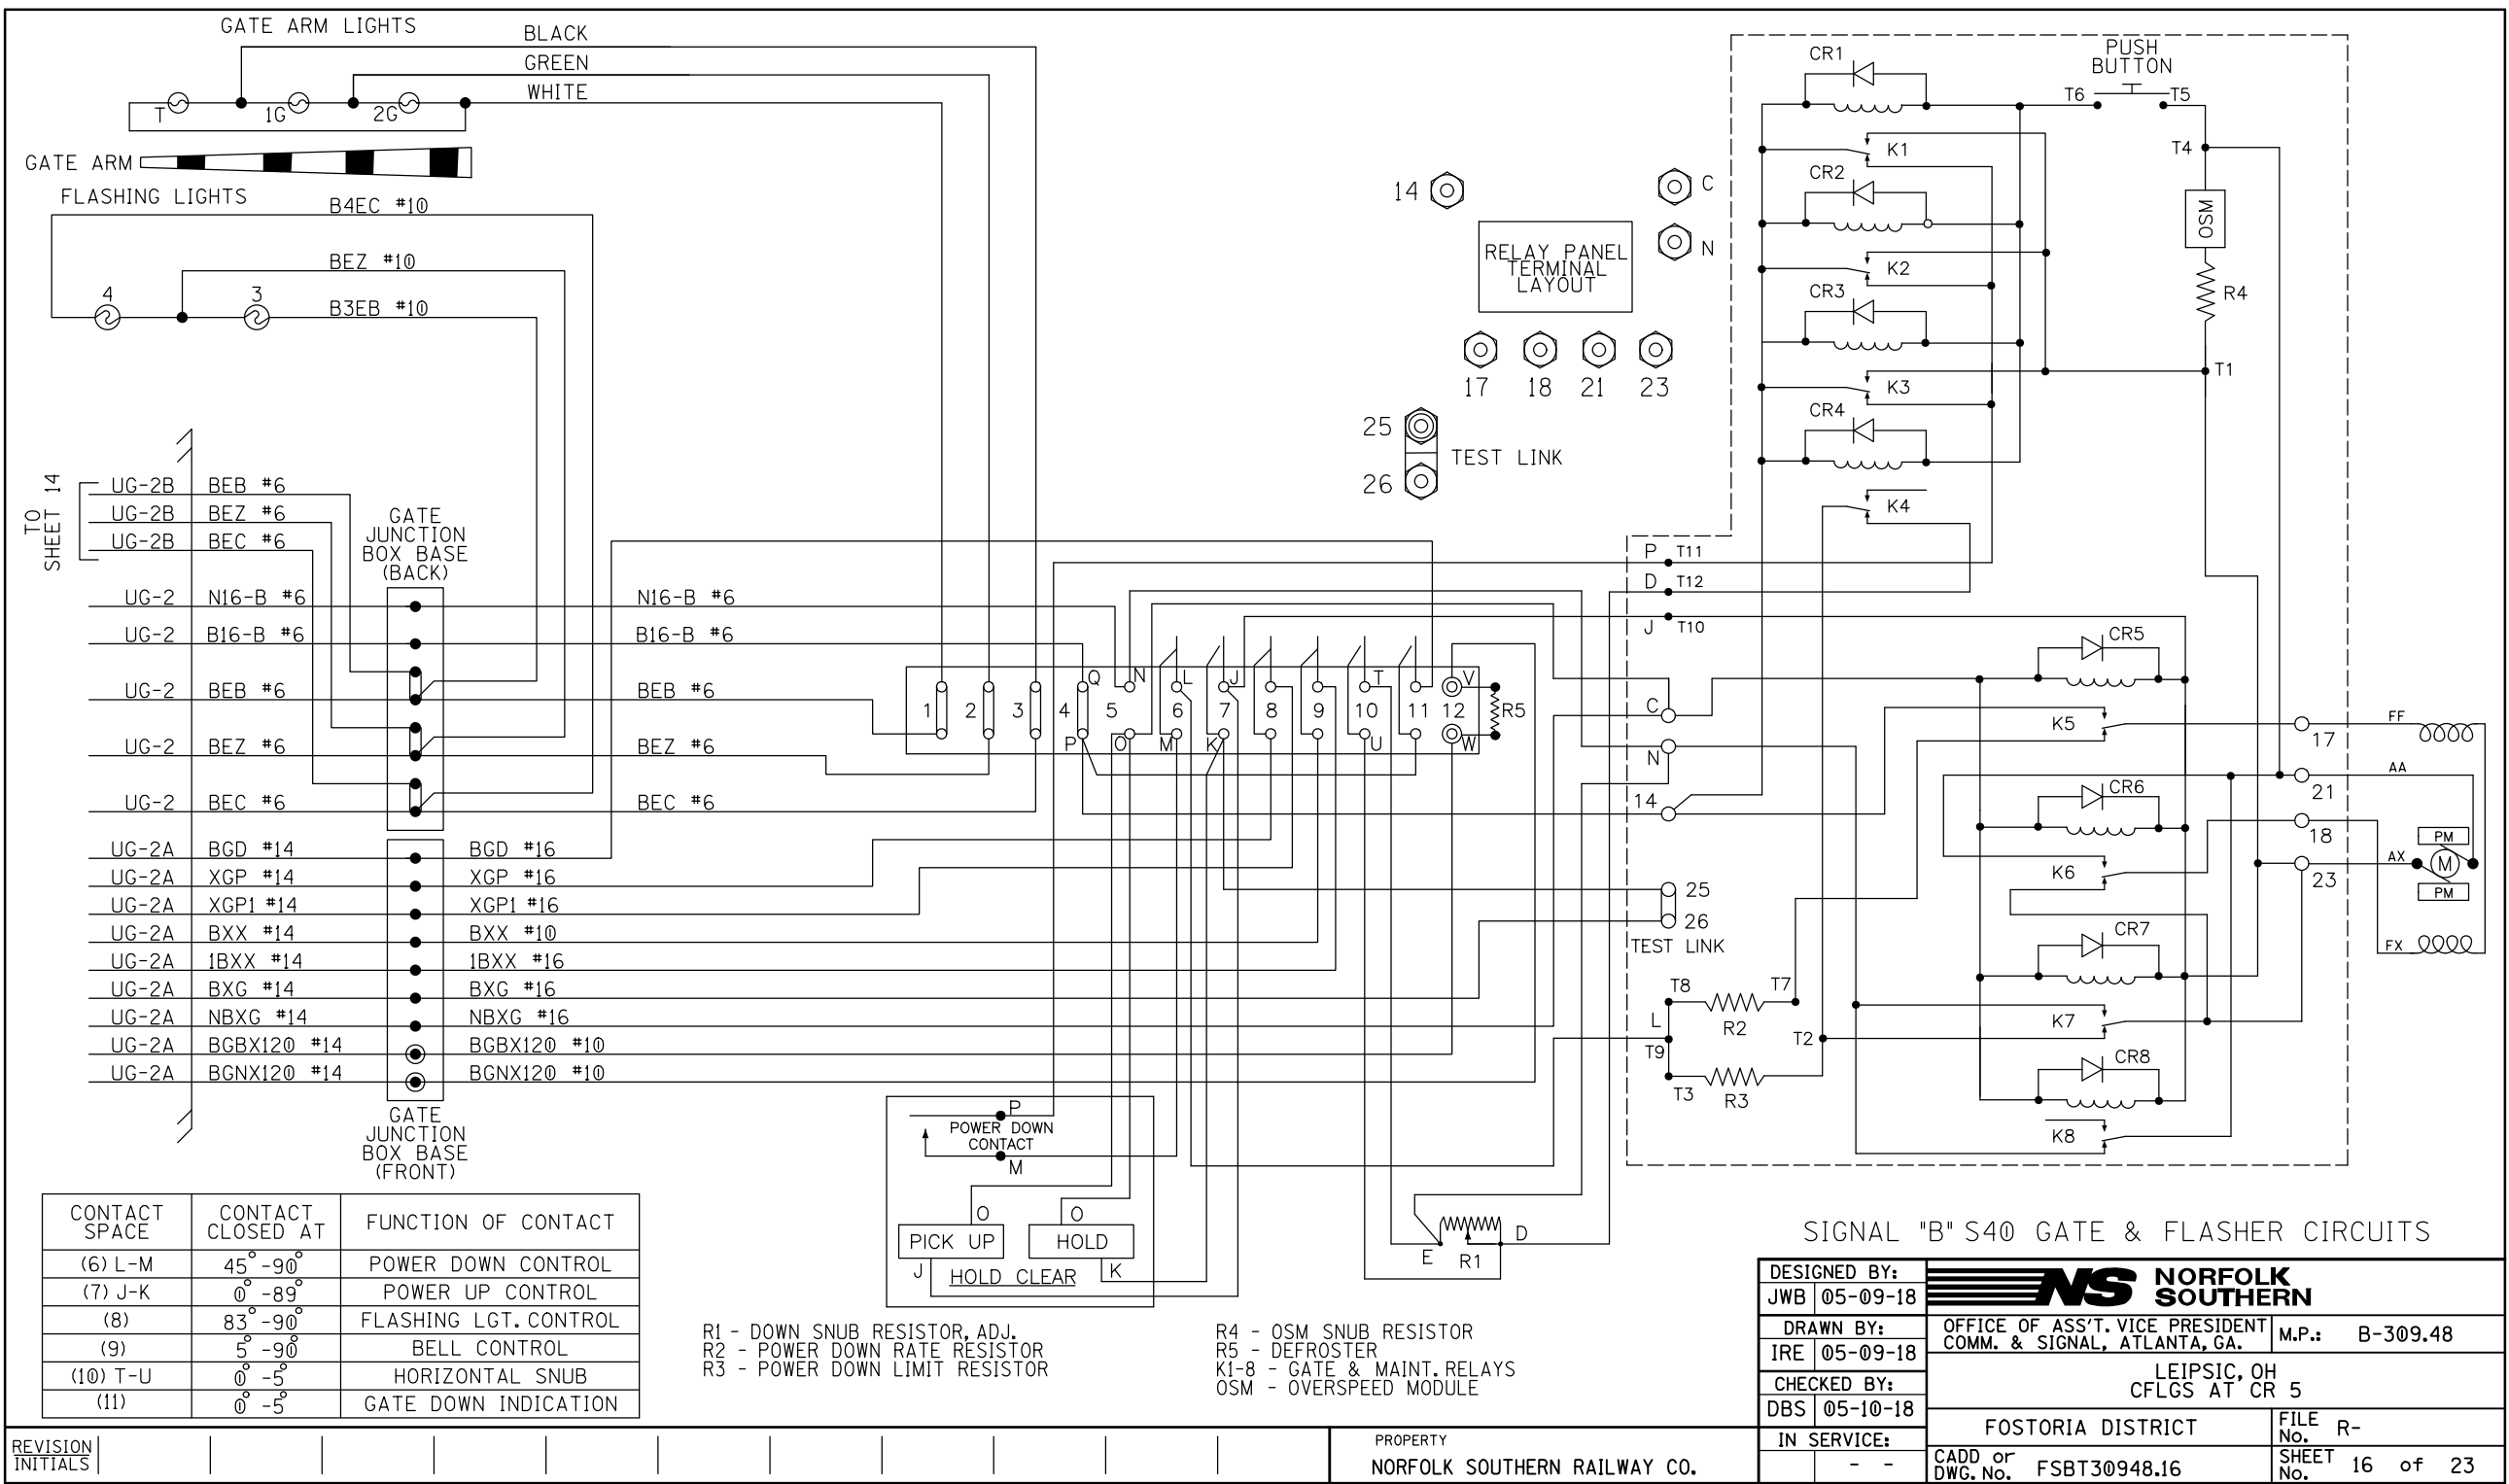

LEFT TWO ROWS TERMINAL BOARD 1

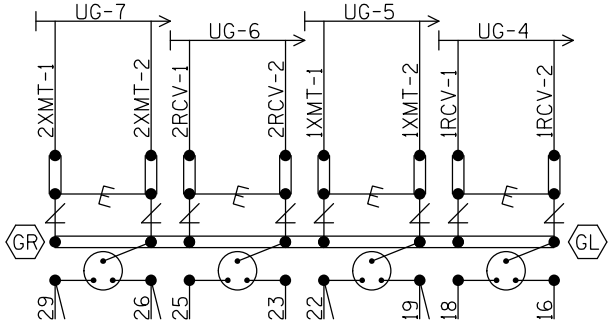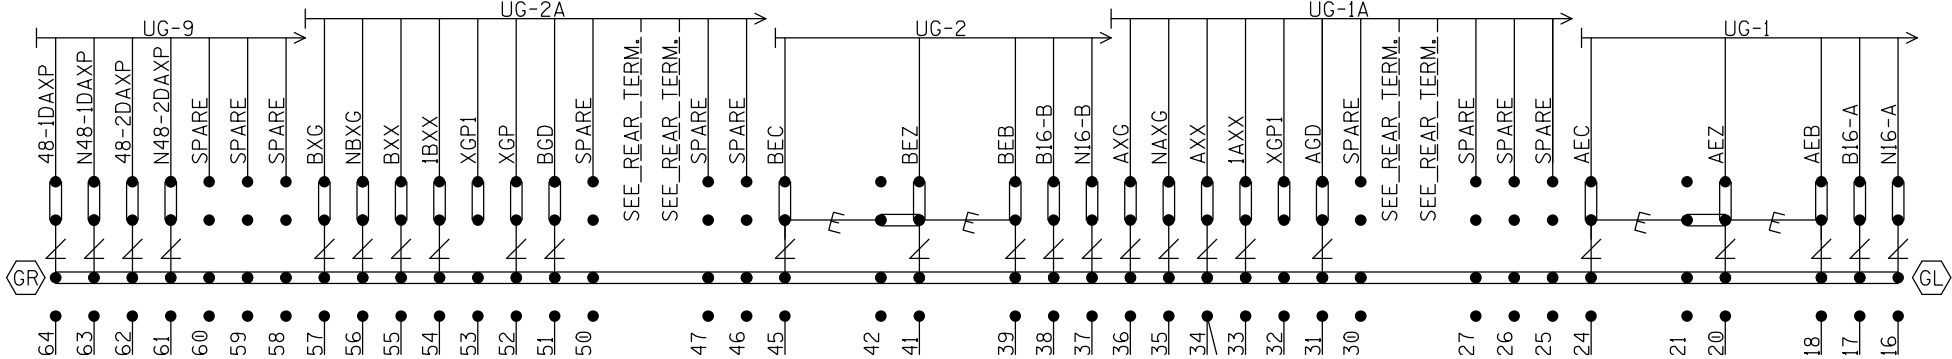




NOTE: INSTALL TEST LINKS ON ALL TRACK WIRES AND ON ALL LOW VOLTAGE UNDERGROUND CABLE TERMINATIONS.

SEE FARADAY SHIELD DETAILS - 1A & 1B
FOR HOW THIS PORTION OF THE FARADAY
SHIELD IS PREDRILLED. ONLY INSTALL AND
USE THE TERMINALS NEEDED.


~~E~~ = Heavy Duty Equalizer
(022700-1X)

Clearview
 ∠ = Lightning Arrester
 (022585-1X)

 = LPC-10560-51



 = TERMINALS GROUNDED TO SHIELD.
 4 POST BLOCKS USE EITHER -
 GR - SERMMI PART NO. 61278
 GL - SERMMI PART NO. 61278-1.

BACKBOARD 1A & 1B

DESIGNED BY:		 NORFOLK SOUTHERN	
JWB	05-09-18		
DRAWN BY:		OFFICE OF ASS'T. VICE PRESIDENT COMM. & SIGNAL, ATLANTA, GA.	M.P.: B-309.48
IRE	05-09-18	LEIPSIC, OH CFLGS AT CR 5	
CHECKED BY:			
DBS	05-10-18		
IN SERVICE:		FOSTORIA DISTRICT	FILE No. R-
	- -	CADD or DWG. No. FSBT30948.17	SHEET No. 17 of 23


[illegible]

REAR VIEW OF LEFT TWO ROWS TERMINAL BOARD 1



* = CLOSED DURING WINTER MONTHS

REAR BACKBOARD 1A & 1B

DESIGNED BY:		 NORFOLK SOUTHERN	
JWB	05-09-18		
DRAWN BY:		OFFICE OF ASS'T. VICE PRESIDENT	
IRE	05-09-18	COMM. & SIGNAL, ATLANTA, GA.	M.P.: B-309.48
CHECKED BY:		LEIPSIC, OH	
DBS	05-10-18	CFLGS AT CR 5	
IN SERVICE:		FOSTORIA DISTRICT	FILE NO. R-
	- -	CADD or DWG. No. FSBT30948.18	SHEET 18 of 23

REVISION INITIALS											PROPERTY NORFOLK SOUTHERN RAILWAY CO.
----------------------	--	--	--	--	--	--	--	--	--	--	--


NOTE: IF THE FARADAY SHIELD WOULD EVER NEED TO BE DRILLED IN THE FIELD, PROPER PRECAUTIONS MUST BE TAKEN TO INSURE METAL SHAVINGS DO NOT GET INTO EXISTING TERMINALS/WIRES.

AREA BELOW IS SCALED WITH AS=.75

TERMINAL BOARD 1
LEFT HALF

"1A"

"1B"

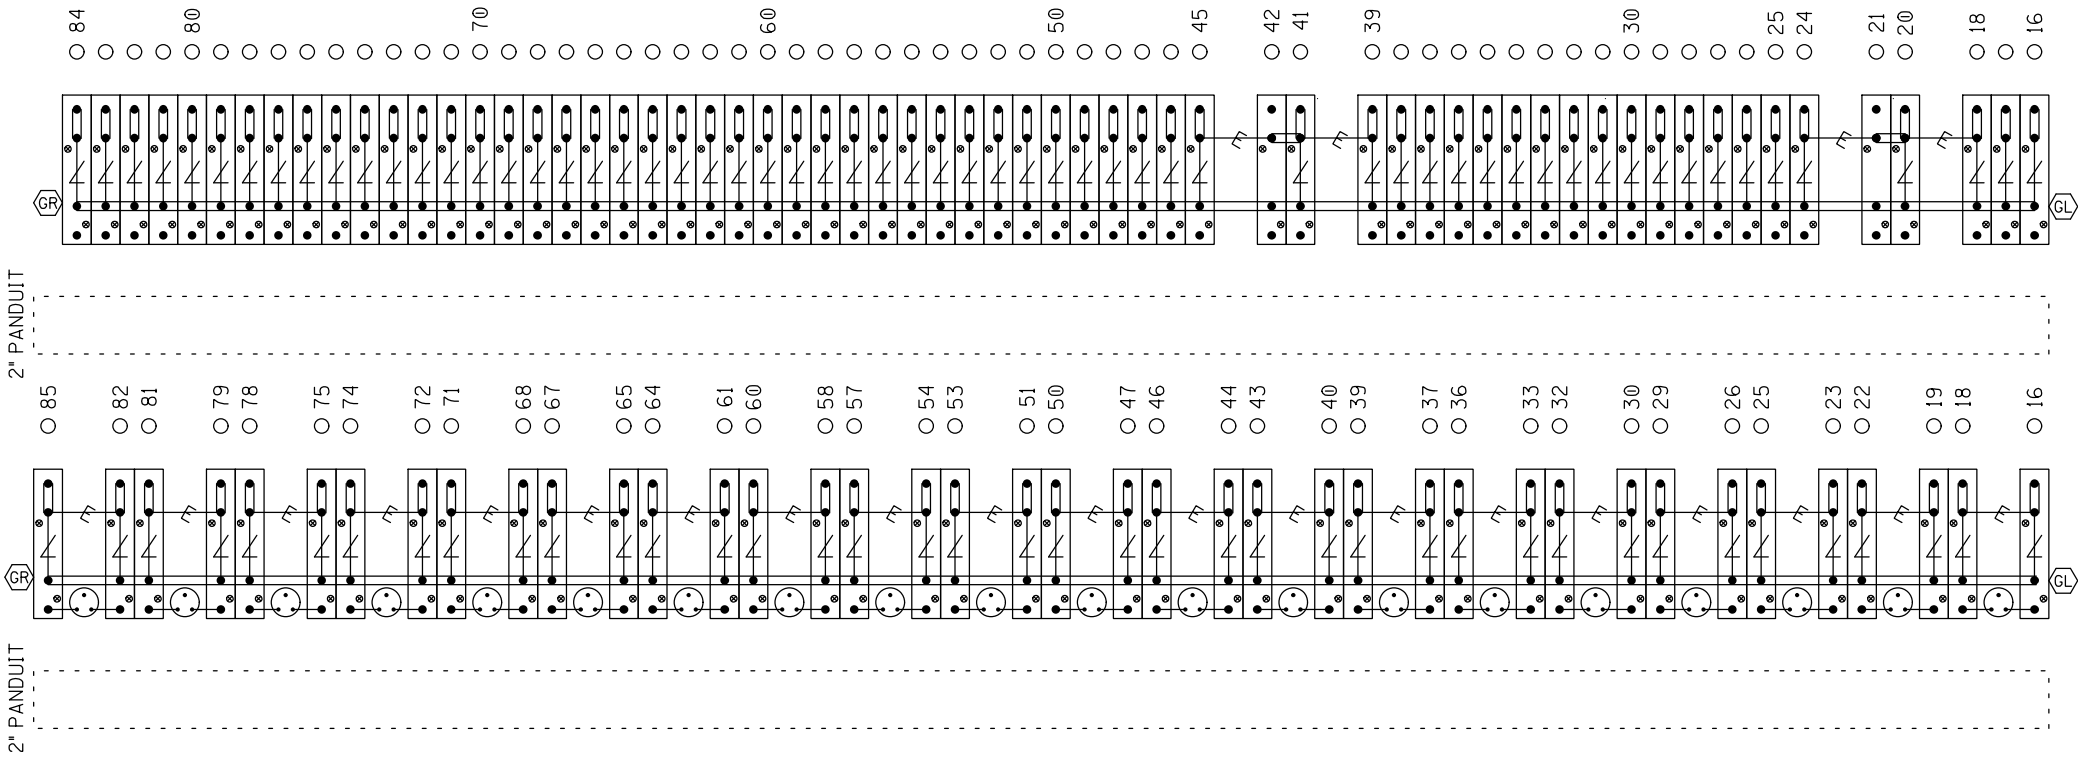

⚡ = Heavy Duty Equalizer
(022700-1X)

Clearview
⚡ = Lightning Arrester
(022585-1X)

⊙ = LPC-10560-51

⊙ = TERMINALS GROUNDED TO SHIELD.
4 POST BLOCKS USE EITHER -
GR - SERMMI PART NO. 61278
GL - SERMMI PART NO. 61278-1.


FARADAY SHIELD 1A & 1B

= INDICATES PLACEMENT
OF PANDUIT

THIS SHEET IS FOR REFERENCE ONLY,
TO REFLECT HOW THE FARADAY SHIELD
IS PREDRILLED. ONLY INSTALL AND USE
THE TERMINALS NEEDED.


REVISION
INITIALS

PROPERTY
NORFOLK SOUTHERN RAILWAY CO.

DESIGNED BY: JWB 05-09-18	 NORFOLK SOUTHERN	
DRAWN BY: IRE 05-09-18	OFFICE OF ASS'T. VICE PRESIDENT COMM. & SIGNAL, ATLANTA, GA.	M.P.: B-309.48
CHECKED BY: DBS 05-10-18	LEIPSIC, OH CFLGS AT CR 5	
IN SERVICE: - -	FOSTORIA DISTRICT	FILE No. R-
	CADD or DWG. No. FSBT30948.19	SHEET 19 of 23


NOTE: IF THE FARADAY SHIELD WOULD EVER NEED TO BE DRILLED IN THE FIELD, PROPER PRECAUTIONS MUST BE TAKEN TO INSURE METAL SHAVINGS DO NOT GET INTO EXISTING TERMINALS/WIRES.

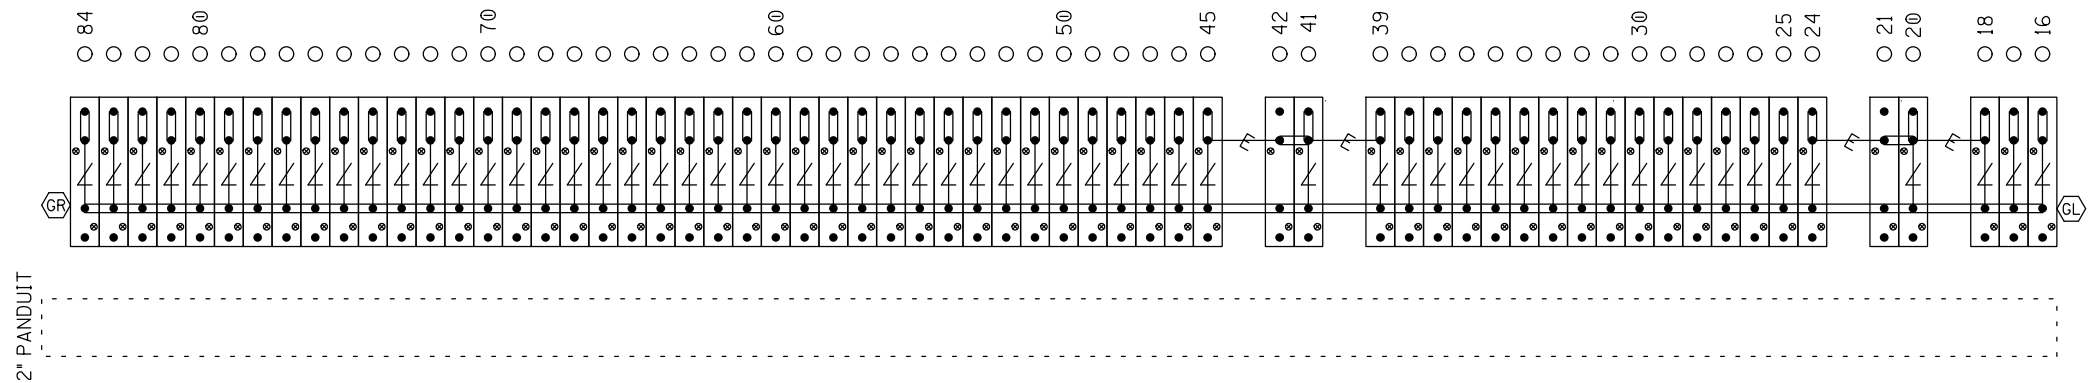

AREA BELOW IS SCALED WITH AS=.75


$$=1C=$$


~~E~~ = Heavy Duty Equalizer
(022700-1X)

Clearview
 ∠ = Lightning Arrester
 (022585-1X)


 = LPC-10560-51



 = TERMINALS GROUNDED TO SHIELD.
 4 POST BLOCKS USE EITHER -
 GR - SERMMI PART NO. 61278
 GL - SERMMI PART NO. 61278-1.


FARADAY SHIELD 1C


= INDICATES PLACEMENT
OF PANDUIT

THIS SHEET IS FOR REFERENCE ONLY,
TO REFLECT HOW THE FARADAY SHIELD
IS PREDRILLED. ONLY INSTALL AND USE
THE TERMINALS NEEDED.


DESIGNED BY:		 NORFOLK SOUTHERN	
JWB	05-09-18		
DRAWN BY:		OFFICE OF ASS'T. VICE PRESIDENT COMM. & SIGNAL, ATLANTA, GA.	M.P.: B-309.48
IRE	05-09-18	LEIPSIC, OH CFLGS AT CR 5	
CHECKED BY:			
DBS	05-10-18		
IN SERVICE:		FOSTORIA DISTRICT	FILE NO. R-
	- -	CADD or DWG. No. FSBT30948.20	SHEET NO. 20 of 23

[illegible]

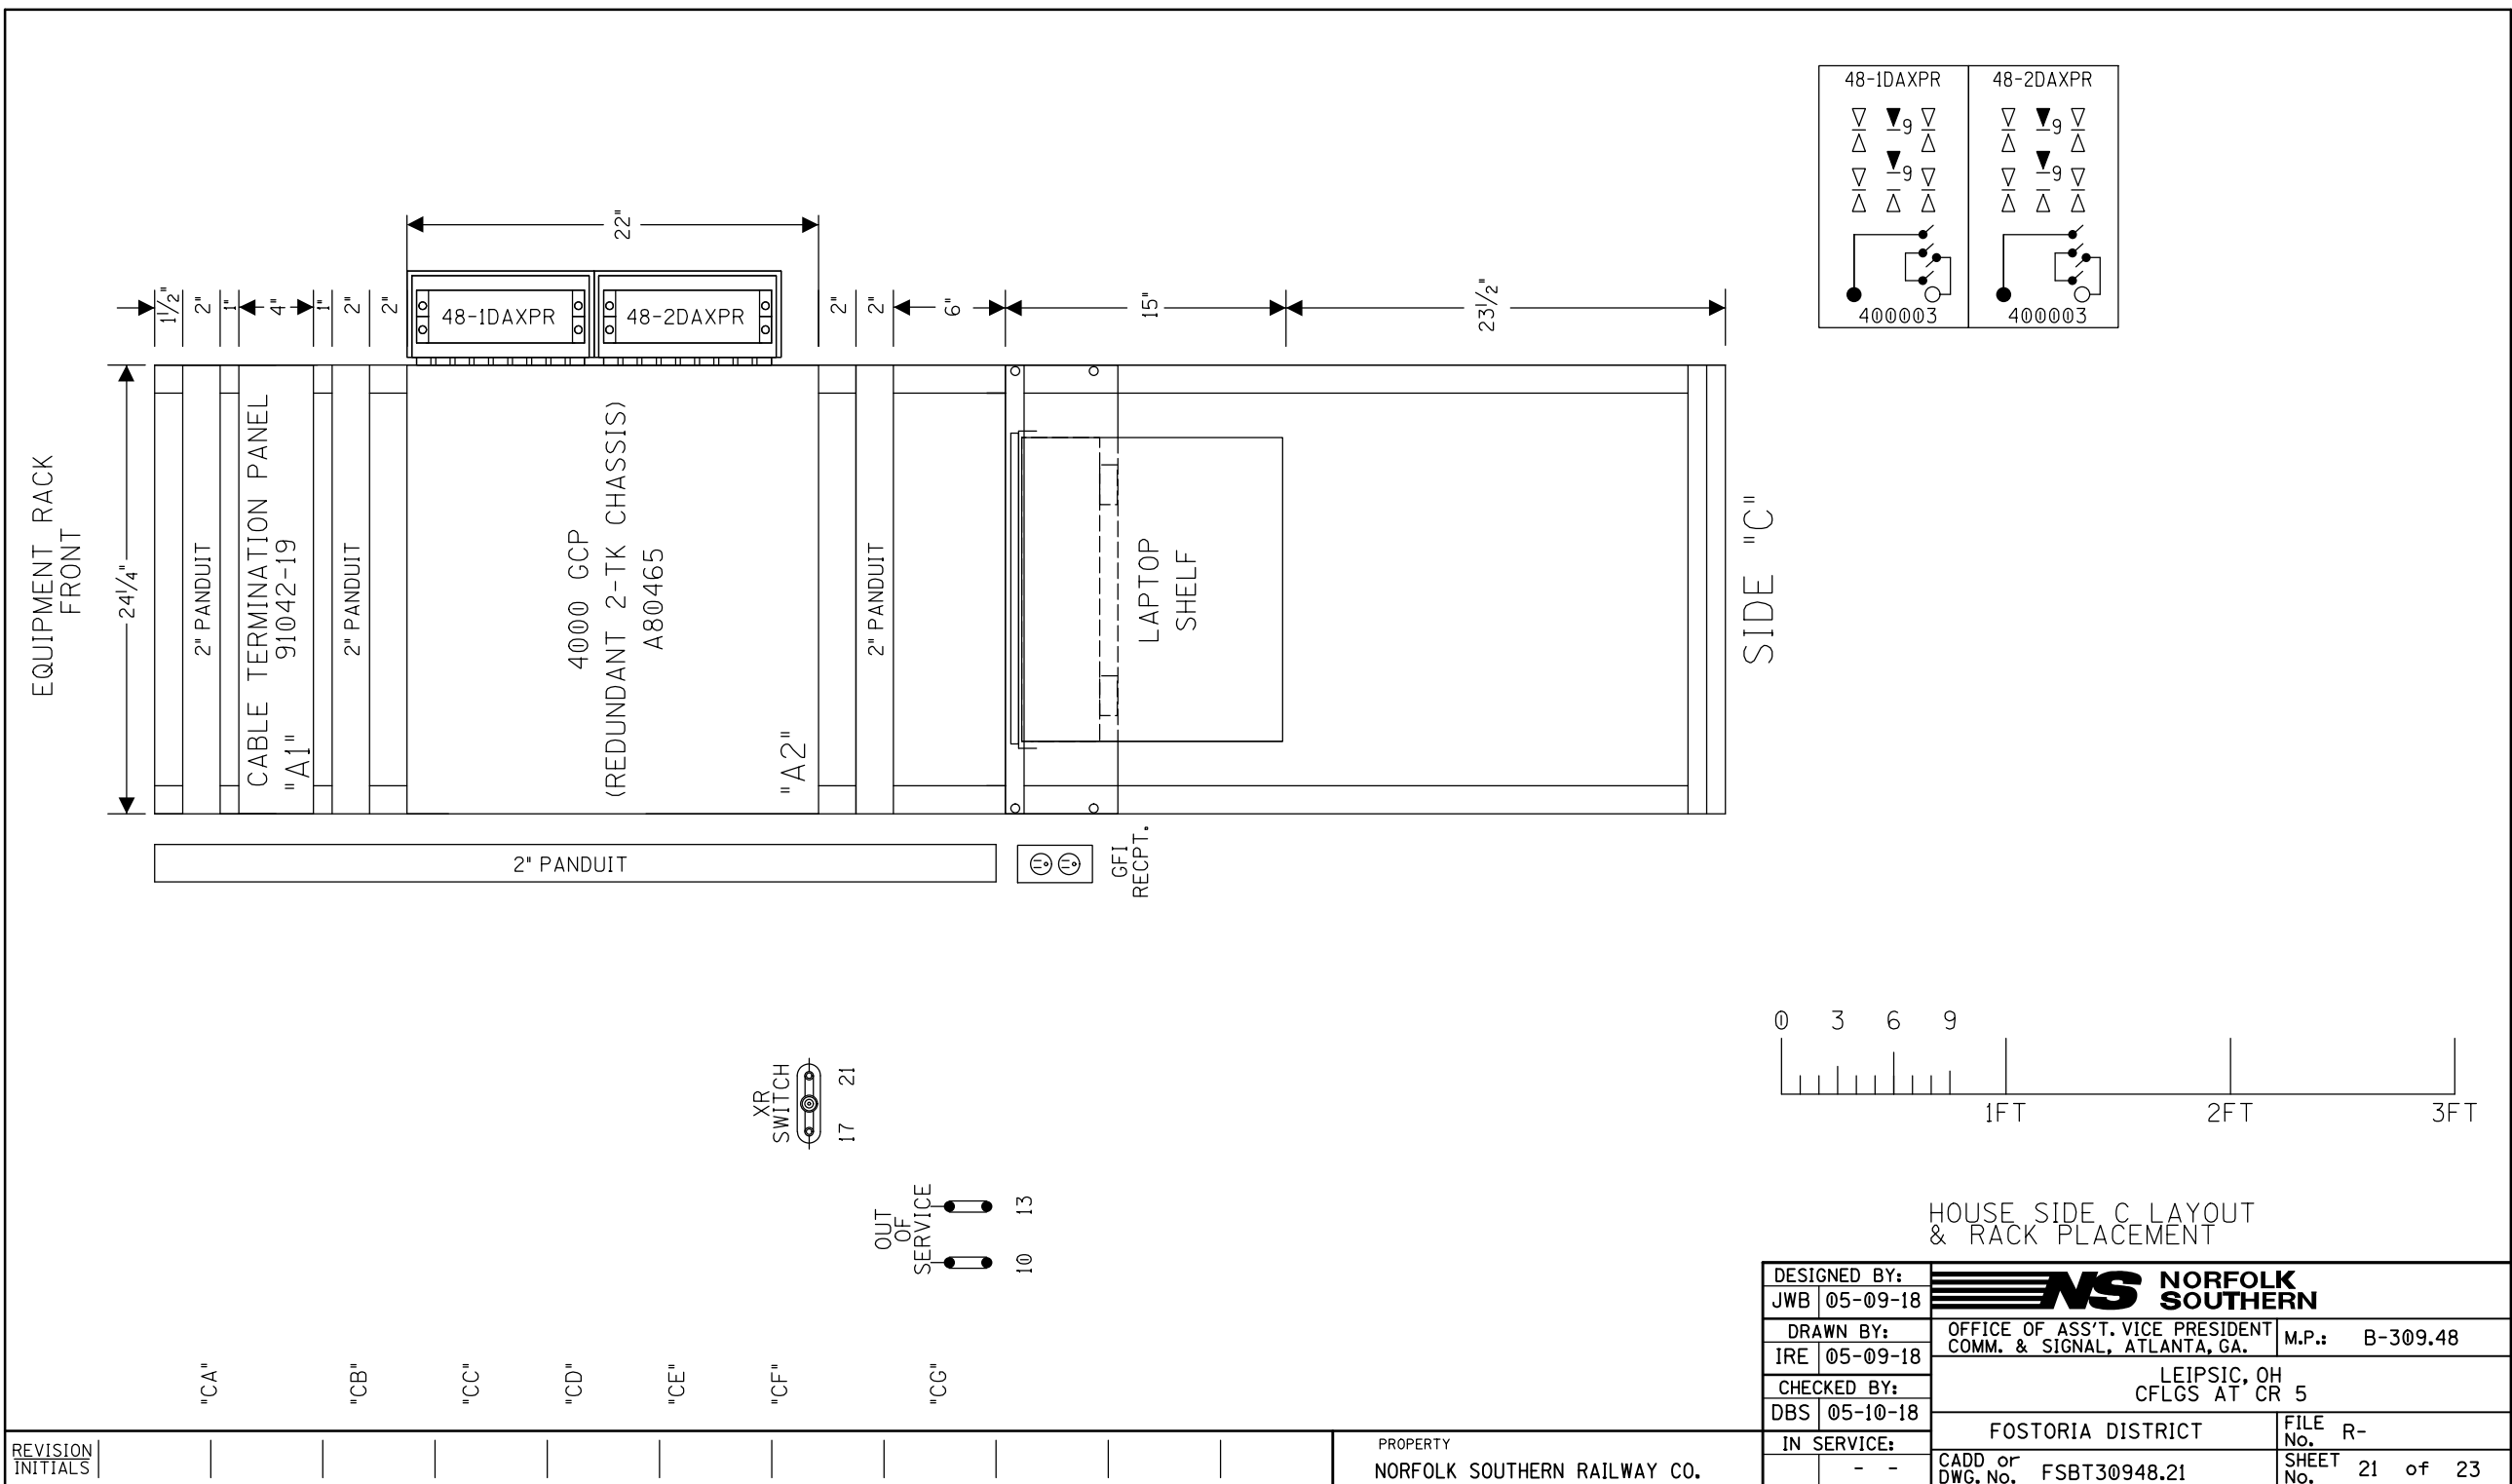

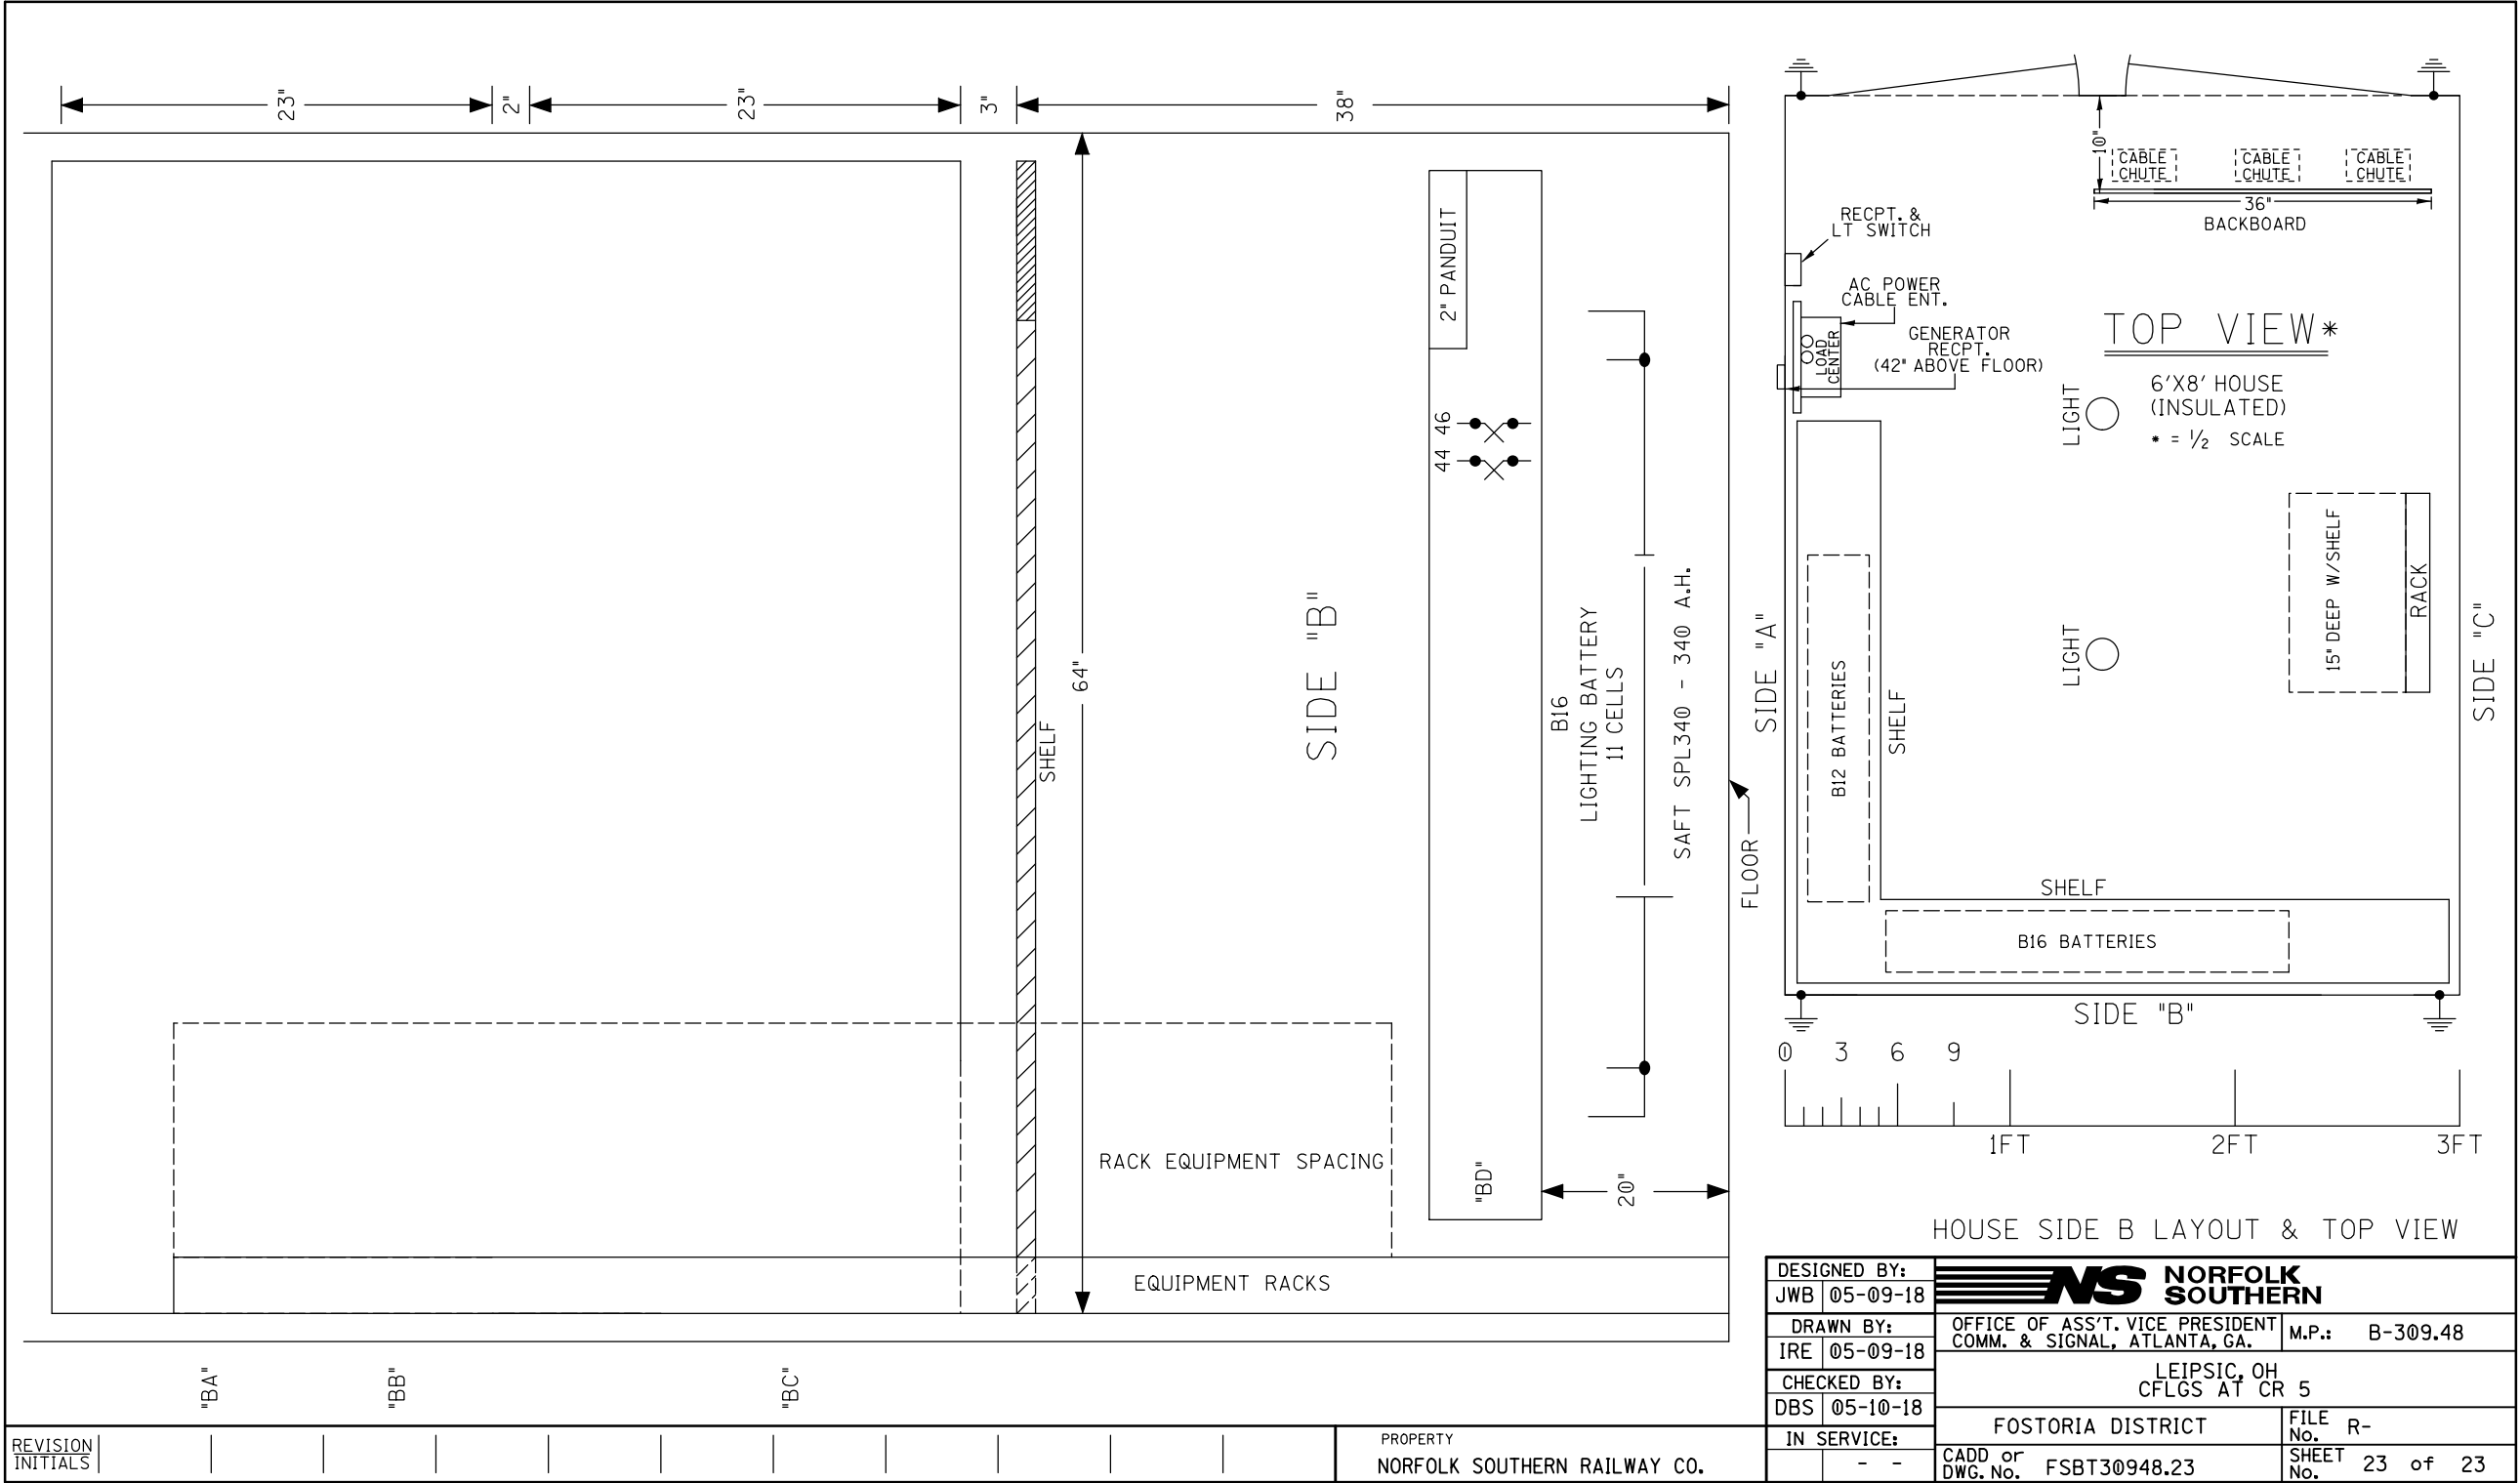

HOUSE SIDE B LAYOUT & TOP VIEW

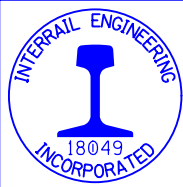

RED = IN
YELLOW = OUT

DATE: 05-09-2018
NS PROJ.#10.3208
IRE/JWB/DBS

IN SERVICE _____ SIGNED _____ DATE _____


- ☐ S&E ENGINEERING COPY
☐ CONSTRUCTION OFFICE COPY
RETURN TO S&E ENG. AFTER COMPLETION
☐ FIELD COPY
RETURN TO CASE AFTER COMPLETION
☐ PROJECT ENGINEER COPY

SH. NO.	CONTENTS
NX1	INDEX SHEET
NX2	OUT OF SERVICE (OOS) INSTRUCTIONS
1	OUTSIDE PLAN
2	3000 GCP HOOK-UP
3	3000 GCP SET-UP
2	4 WIRING FOR GEO TRACK 2 & 4 UNITS
3	5 TRACK 2 SIGNAL LIGHTING
4	6 TRACK 4 SIGNAL LIGHTING
5	7 TRACK 2 MODULES AND I/O PINOUTS
6	8 TRACK 4 MODULES AND I/O PINOUTS
7	9 GEO SYSTEM CONFIGURATION - TRACK 2
8	10 GEO SYSTEM CONFIGURATION - TRACK 4
9	11 ASPECTS
10	12 LOAD CENTER, B14 RECTIFIER & BATTERY
11	13 XB12, B14 RECTIFIER AND BATTERY
12	14 GEO CONSOLE - TRACK 2
13	15 GEO CONSOLE - TRACK 2 PROGRAMMING
14	16 GEO CONSOLE - TRACK 4
15	17 GEO CONSOLE - TRACK 4 PROGRAMMING
16	18 PTC RADIO AND MESSAGE SERVER
17	19 PTC RADIO CONFIGURABLE PARAMETERS
18	20 SEAR II RECORDER & VHF RADIO
19	21 SEAR II SET UP & GROUND FAULT TESTER
	20 CONNECTORS FOR TRACK MODULES
	21 CONNECTORS FOR CPU MODULE
	22 BACKBOARD 1A & 1B

SH. NO.	CONTENTS
23	FARADAY SHIELD 1A & 1B
24	FARADAY SHIELD 1C
25	PLACEMENT - SIDE C
26	PLACEMENT - SIDE A
27	PLACEMENT - SIDE B
28	CABLE PLAN

4000 GCP 5-TK CHASSIS & MODULE LAYOUT
4000 GCP PROGRAMMING SETUP

INDEX SHEET

DESIGNED BY:	 NORFOLK SOUTHERN		
MAG 09-11-14	OFFICE OF ASS'T. VICE PRESIDENT COMM. & SIGNAL, ATLANTA, GA.		M.P.: B-309.10
DRAWN BY:	BELLEVUE, OH TO FORT WAYNE, IN		
SII 09-11-14	AUTOMATIC SIGNALS - 3090/3093 AND 3091/3092		
CHECKED BY:	FOSTORIA DISTRICT		FILE No. R-3493
EWP 10-06-14	IN SERVICE:		SHEET No. 1 of 2 1
NAG 08-18-15	CADD or DWG. No. FSBT30910.NX1		

REVISION
INITIALS

PROPERTY
NORFOLK SOUTHERN RAILWAY CO.

TAKING TRACK(S) OUT OF SERVICE (OOS):

SP-1001 MUST BE COMPLIED WITH

THE OUT OF SERVICE MENU IS ACCESSED ON THE DISPLAY BY TOUCHING THE DESIRED TRACK IN THE TRACK STATUS WINDOW ON THE DISPLAY. SELECT OUT OF SERVICE FROM THE DROP DOWN MENU.

PLACE A JUMPER ACROSS THE OOS TERMINALS SHOWN IN THE PLANS.

SP-1001 MUST BE COMPLIED WITH

SELECT "TAKE GCP OUT OF SERVICE."

ONCE THE GCP APPROACH IS TAKEN OUT OF SERVICE, IF AN ISLAND EXISTS, THE OPTION TO "TAKE ISL OUT OF SERVICE" IS PRESENTED. IF THE ISLAND IS LEFT IN SERVICE, THE CROSSING WILL ACTIVATE IF THE ISLAND IS OCCUPIED.

IF DESIRED, SELECT "TAKE ISL OUT OF SERVICE."

THE TRACK IS NOW OUT OF SERVICE. WHEN THE OUT OF SERVICE SCREEN IS CLOSED, THE DISPLAY RETURNS TO THE TRACK STATUS SCREEN. NOTE THAT THE OUT OF SERVICE TRACK IS ALTERNATELY FLASHING DARK GRAY AND LIGHT BLUE.


REPEAT FOR ADDITIONAL TRACKS IF NEEDED.

PUTTING TRACK(S) BACK IN SERVICE:

SP-1001 MUST BE COMPLIED WITH

REMOVE THE JUMPER ACROSS THE OOS TERMINALS SHOWN IN THE PLANS.

SP-1001 MUST BE COMPLIED WITH

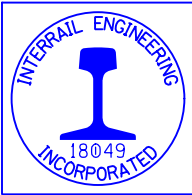

RED = IN

YELLOW = OUT

DATE: 05-09-2018
NS PROJ.#10.3208
IRE/JWB/DBS


OUT OF SERVICE (OOS) INSTRUCTIONS

REVISION INITIALS	
----------------------	--	--	

TO FORT WAYNE
(WEST)
M.P. INCREASING

TO BELLEVUE
(EAST)
M.P. DECREASING

CASE 3091

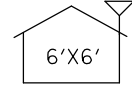

3000 GCP
430 HZ

3093
(4W)
CL

4000 GCP
430 HZ

CL
3090
(4E)

MAIN 2 4WT

CODES 1-4-8->
<-CODES 1-3-5-7-8

CODES 1-3-7-8->
<-CODES 1-3-5-7-8

4ET

MAIN 2

MAIN 1 2WT

CODES 1-2-3-7->
<-CODES 1-5-3-7-8

CODES 1-3-7-8->
<-CODES 1-5-3-7-8


2ET

MAIN 1

3091
(2W)
CL

CL
3092
(2E)

3087'
CR 5
DAX APPROACH (TO
EDGE OF ISLAND)
(MAIN #1 & #2)
1118'
TO NEAREST
GCP WIRES
(MAIN #1 & #2)

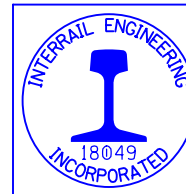

RED = IN
YELLOW = OUT

DATE: 05-09-2018
NS PROJ.#10.3208
IRE/JWB/DBS

IN SERVICE _____ SIGNED _____ DATE _____
☐ S&E ENGINEERING COPY
☐ CONSTRUCTION OFFICE COPY
RETURN TO S&E ENG. AFTER COMPLETION
☐ FIELD COPY
RETURN TO CASE AFTER COMPLETION
☐ PROJECT ENGINEER COPY

(A) - MF-NBS 62775-1543 (348HZ) W/8V617-800

(A) - MF-NBS FSS-1A 250849-000 (151HZ)
W/227032-003 FSS LOAD 1000 FT

(B) - MF-NBS 62775-1543 (430HZ)

OUTSIDE PLAN


DESIGNED BY: RJT 03-28-05	NORFOLK SOUTHERN	
DRAWN BY: SSC 03-28-05	OFFICE OF ASS'T. VICE PRESIDENT COMM. & SIGNAL, ATLANTA, GA.	M.P.: B-309.10
CHECKED BY: LAR 03-30-05	BELLEVUE, OH TO FORT WAYNE, IN AUTOMATIC SIGNALS - 3090/3093 AND 3091/3092	
IN SERVICE: MAL 12-04-06	FOSTORIA DISTRICT	FILE NO. R-1884
	CADD or DWG. No. FSBT30910.01	SHEET No. 1 of 28


REVISION
INITIALS






R-3493
NAG/08-18-15
SII/07-25-17

PROPERTY
NORFOLK SOUTHERN RAILWAY CO.



DESIGNED BY:			
RJT 03-28-05			
DRAWN BY:	OFFICE OF ASS'T. VICE PRESIDENT		M.P.: B-309.10
SSC 03-28-05	COMM. & SIGNAL, ATLANTA, GA.		
CHECKED BY:	BELLEVUE, OH TO FORT WAYNE, IN		
LAR 03-30-05	AUTOMATIC SIGNALS - 3090/3093 AND 3091/3092		
IN SERVICE:	FOSTORIA DISTRICT		FILE No. R-1884
MAL 12-04-06	CADD or DWG. No. FSBT30910.02V	SHEET No. 2 of 28	

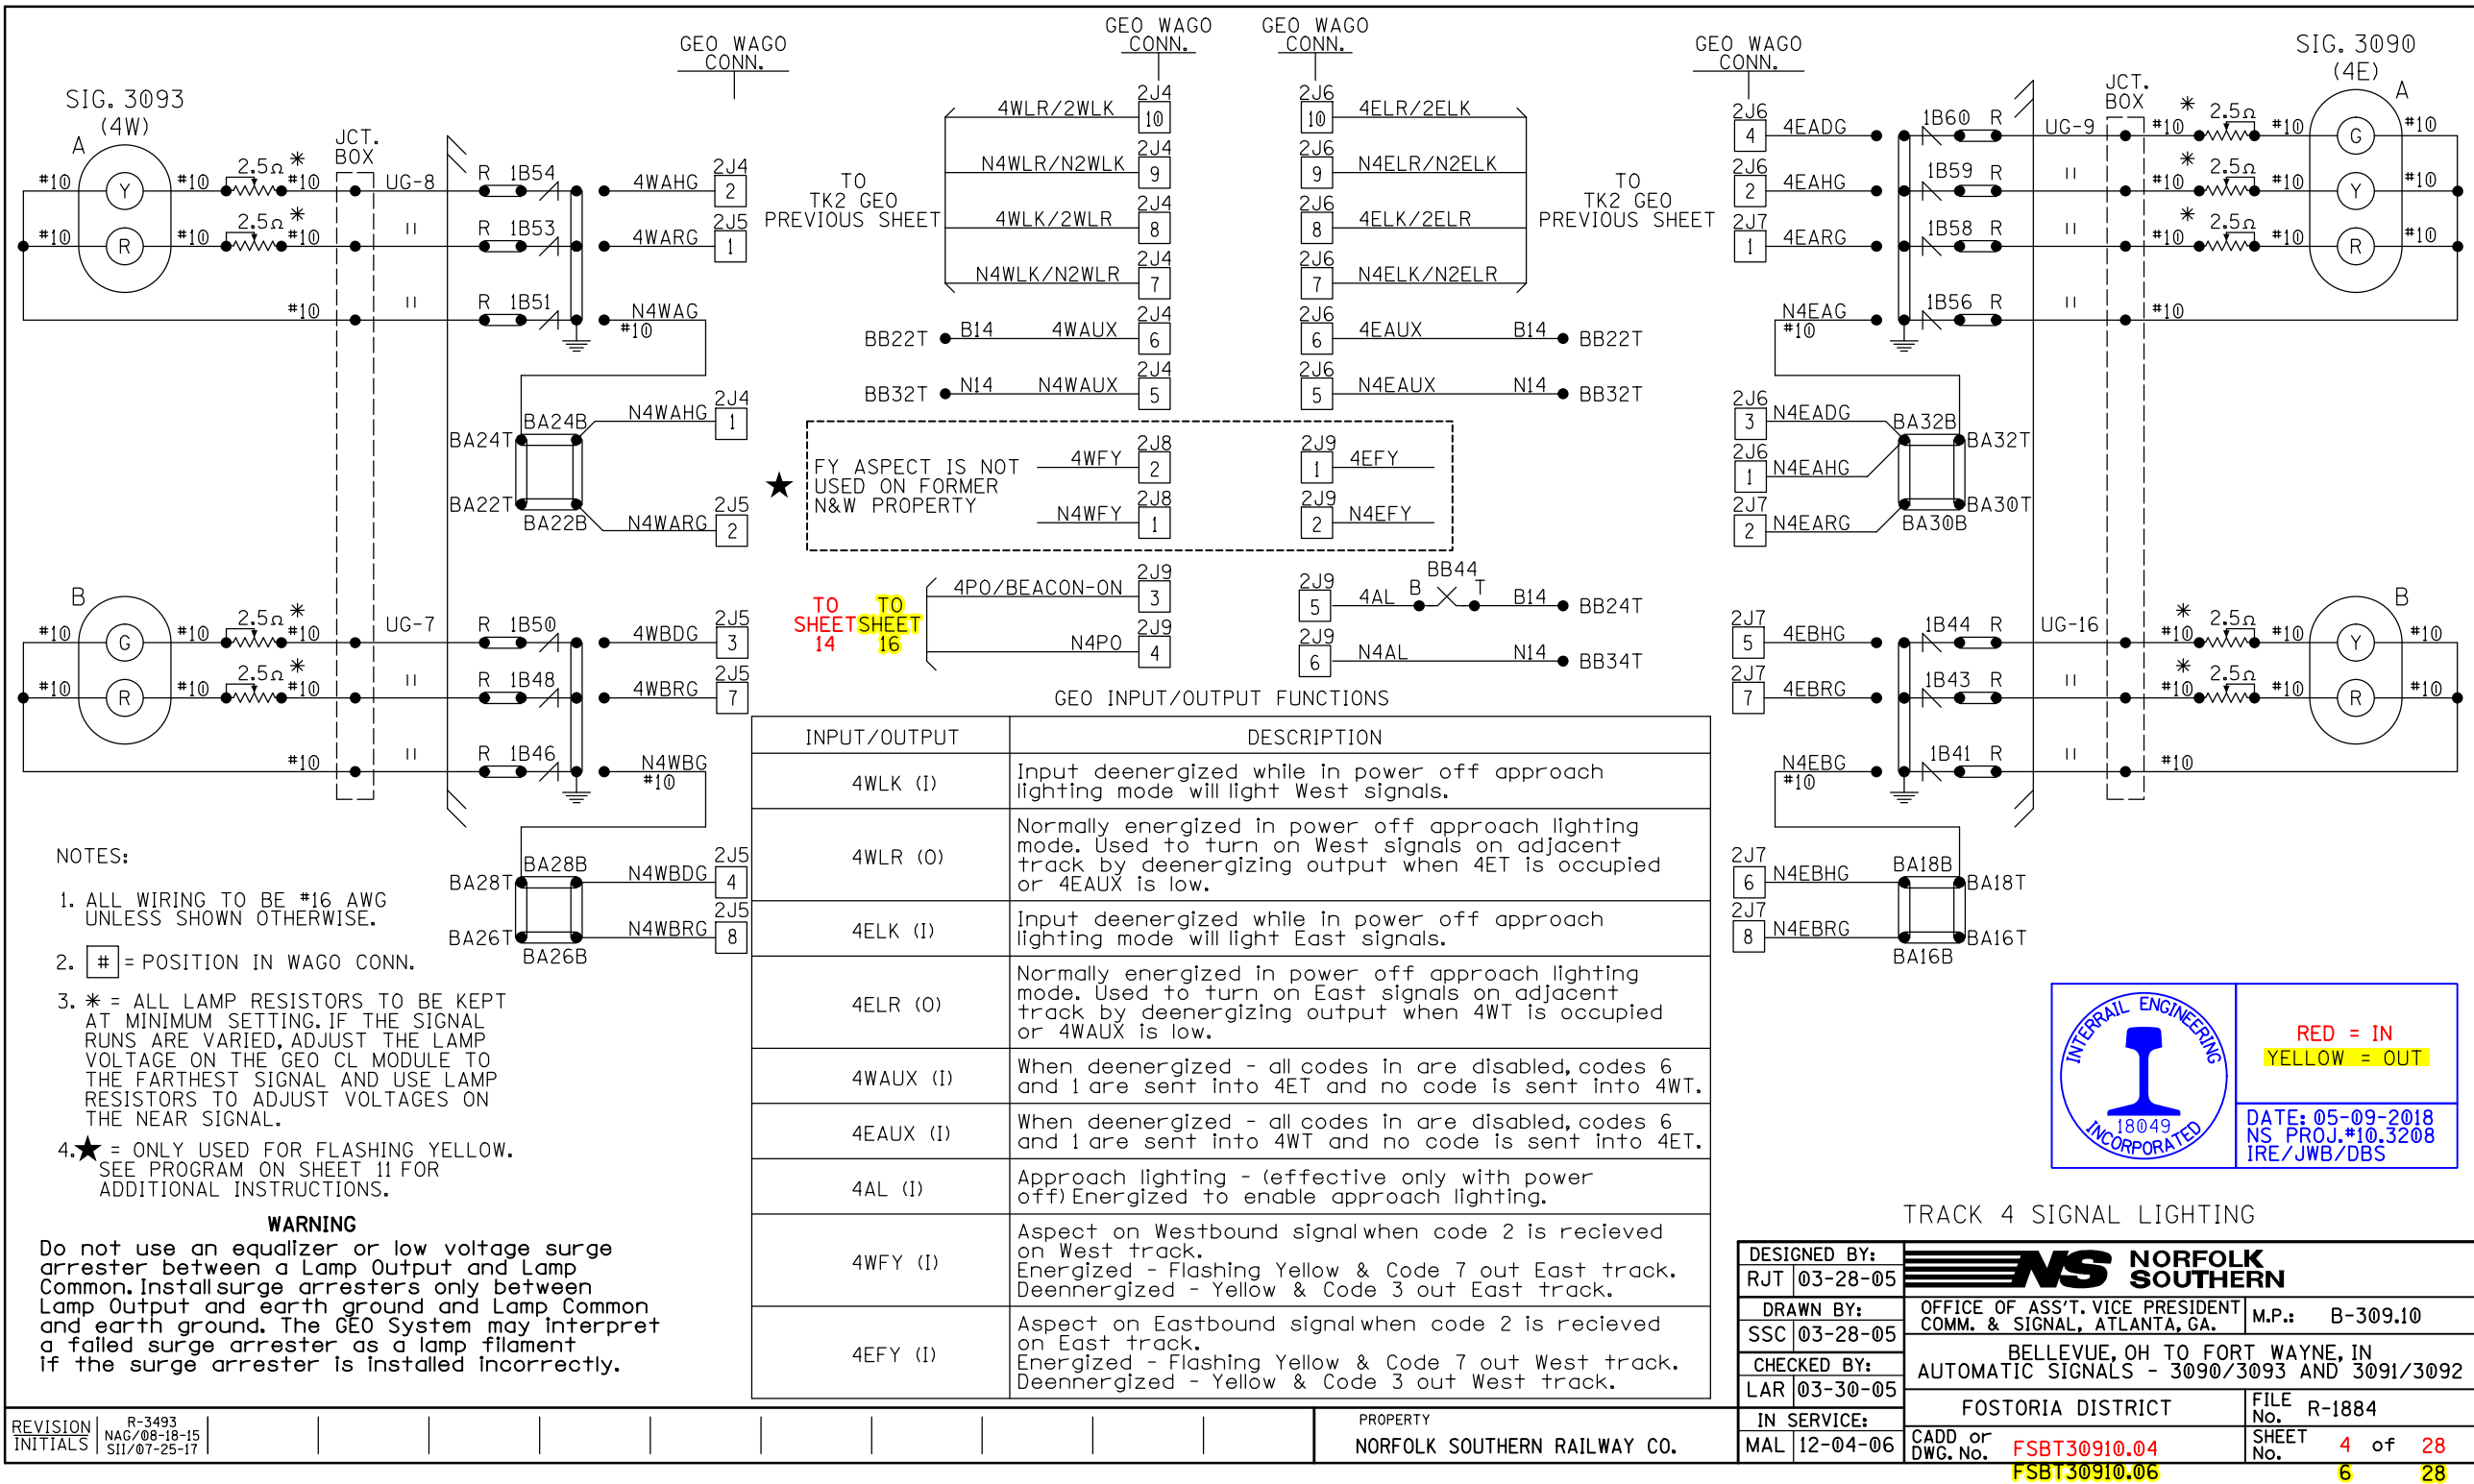

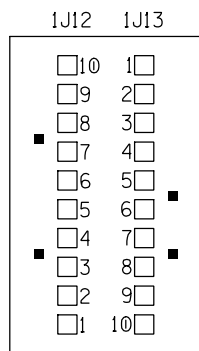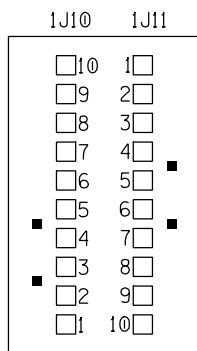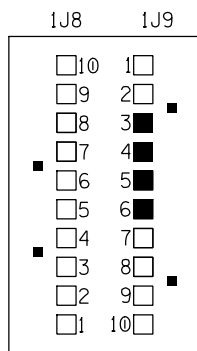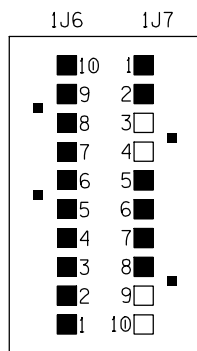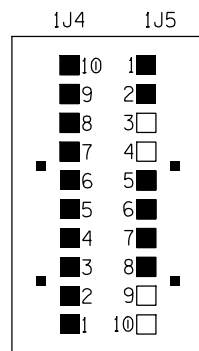

MCF NAME: EGEONSL002

UCN: 9B4F9F02

SIN: 70000000000000


CRC: DDAC3825

KEYING FINGERS: ■ = CUT


WAGO CONNECTION: ■ = USED

□ = NOT USED

MODULE SOFTWARE VERSIONS





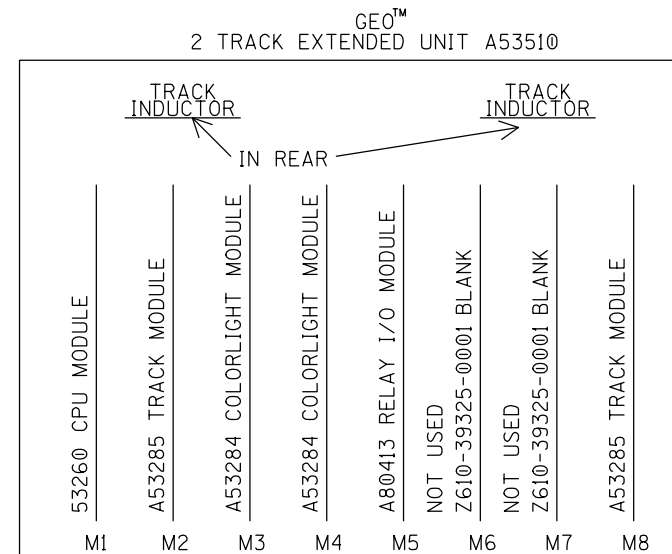
53260 CPU: GEO_00_32.PTC.MEF CRC: 6C06A53285 TRACK: TRK01_11 .MEF CRC: D3AFA53284 COLORLIGHT: CLS01_12.MEF CRC: EFBFA80413 RELAY I/O: RI001_06 .MEF CRC: 3433GEO A53510 CONNECTOR PINOUTS

PIN	1J4		1J6		1J8		1J10		1J12	
10	VR0 +	2WLR	VR0 +	2ELR	VR01 +	2WWL				
9	VR0 -	N2WLR	VR0 -	N2ELR	VR01 -	N2WWL				
8	VPI1 +	2WLK	VPI1 +	2ELK	VR02 +	2EWL				
7	VPI1 -	N2WLK	VPI1 -	N2ELK	VR02 -	N2EWL				
6	VPI2 +	2WAUX	VPI2 +	2EAUX	VR03 +					
5	VPI2 -	N2WAUX	VPI2 -	N2EAUX	VR03 -					
4	LAMP1 +	2WADG	LAMP1 +	2EADG	VR04 +					
3	LAMP1 -	N2WADG	LAMP1 -	N2EADG	VR04 -					
2	LAMP2 +	2WAHG	LAMP2 +	2EAHG	VPI1 +	2WIFY				
1	LAMP2 -	N2WAHG	LAMP2 -	N2EAHG	VPI1 -	N2WIFY				
PIN	1J5		1J7		1J9		1J11		1J13	
1	LAMP3 +	2WARG	LAMP3 +	2EARG	VPI2 +	2EIFY				
2	LAMP3 -	N2WARG	LAMP3 -	N2EARG	VPI2 -	N2EIFY				
3	LAMP4 +	2WBDG	LAMP4 +	2EBDG	VPI3 +	2P0 /BEACON-ON				
4	LAMP4 -	N2WBDG	LAMP4 -	N2EBDG	VPI3 -	N2P0				
5	LAMP5 +	2WBHG	LAMP5 +	2EBHG	VPI4 +	2AL				
6	LAMP5 -	N2WBHG	LAMP5 -	N2EBHG	VPI4 -	N2AL				
7	LAMP6 +	2WBRG	LAMP6 +	2EBRG	N/A +					
8	LAMP6 -	N2WBRG	LAMP6 -	N2EBRG	N/A -					
9	RED RET +		RED RIET +		N/A +					
10	RED RET -		RED RIET -		N/A -					

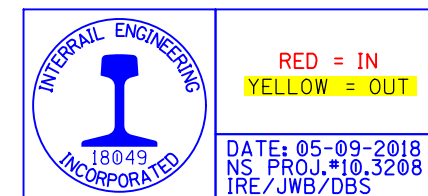

TRACK 2
2 TRACK EXTENDED UNIT
MODULES AND I/O PINOUTS


REVISION INITIALS	R-3493										PROPERTY NORFOLK SOUTHERN RAILWAY CO.	IN SERVICE:		FUSTORIA DISTRICT	No. R-1884
	NAG/08-18-15 SII/07-25-17											MAL	12-04-06	CADD or DWG. No. FSBT30910.05	SHEET No. 5 of 28
													FSBT30910.07	7	28

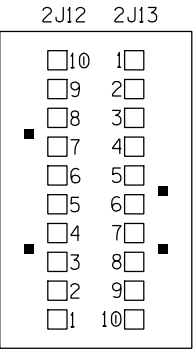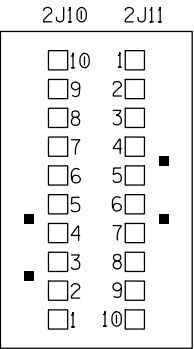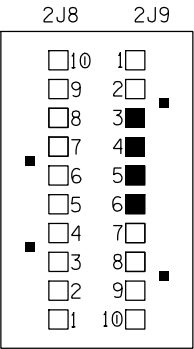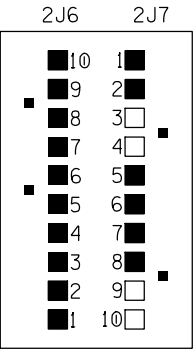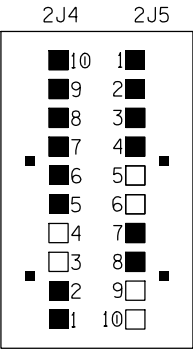

MCF NAME: EGEONSCL002
UCN: 9B4F9F02
SIN: 700000000000
CRC: DDAC3825

MODULE SOFTWARE VERSIONS


53260 CPU: GEO_00_32.PTC.MEF CRC: 6C06
A53285 TRACK: TRK01_11.MEF CRC: D3AF
A53284 COLORLIGHT: CLS01_12.MEF CRC: EFBF
A80413 RELAY I/O: RI001_06.MEF CRC: 3433

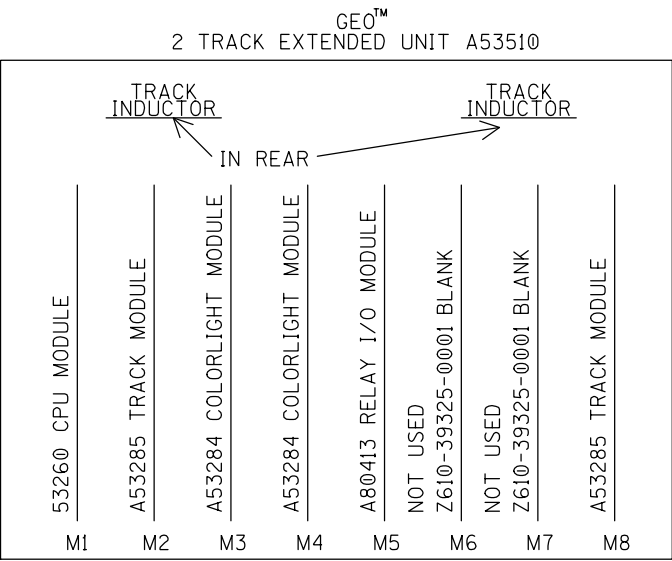

KEYING FINGERS: ■ = CUT
WAGO CONNECTION: ■ = USED
□ = NOT USED

GEO A53510 CONNECTOR PINOUTS

PIN	2J4		2J6		2J8		2J10		2J12	
10	VR0 +	4WLR	VR0 +	4ELR	VR01 +	4WWL				
9	VR0 -	N4WLR	VR0 -	N4ELR	VR01 -	N4WWL				
8	VPI1 +	4WLK	VPI1 +	4ELK	VR02 +	4EWL				
7	VPI1 -	N4WLK	VPI1 -	N4ELK	VR02 -	N4EWL				
6	VPI2 +	4WAUX	VPI2 +	4EAUX	VR03 +					
5	VPI2 -	N4WAUX	VPI2 -	N4EAUX	VR03 -					
4	LAMP1 +	4WADG	LAMP1 +	4EADG	VR04 +					
3	LAMP1 -	N4WADG	LAMP1 -	N4EADG	VR04 -					
2	LAMP2 +	4WAHG	LAMP2 +	4EAHG	VPI1 +	4WFY				
1	LAMP2 -	N4WAHG	LAMP2 -	N4EAHG	VPI1 -	N4WFY				
PIN	2J5		2J7		2J9		2J11		2J13	
1	LAMP3 +	4WARG	LAMP3 +	4EARG	VPI2 +	4EFY				
2	LAMP3 -	N4WARG	LAMP3 -	N4EARG	VPI2 -	N4EFY				
3	LAMP4 +	4WBDG	LAMP4 +	4EBDG	VPI3 +	4PO /BEACON-ON				
4	LAMP4 -	N4WBDG	LAMP4 -	N4EBDG	VPI3 -	N4PO				
5	LAMP5 +	4WBHG	LAMP5 +	4EBHG	VPI4 +	4AL				
6	LAMP5 -	N4WBHG	LAMP5 -	N4EBHG	VPI4 -	N4AL				
7	LAMP6 +	4WBRG	LAMP6 +	4EBRG	N/A +					
8	LAMP6 -	N4WBRG	LAMP6 -	N4EBRG	N/A -					
9	RED RET +		RED RET +		N/A +					
10	RED RET -		RED RET -		N/A -					

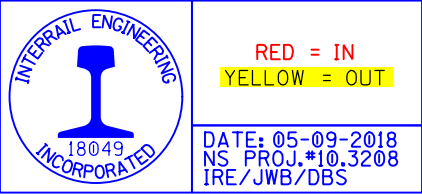

TRACK 4
4 TRACK EXTENDED UNIT
MODULES AND I/O PINOUTS

CODED TRACK OPERATING PARAMETERS

SLOT 2 (M2)		
PROPERTY	VALUE	UNITS
VCO VOLTAGE	*	mV
RECEIVE	TRUE	
TRANSMIT	TRUE	
CODE 5	ALTERNATING	
EC4 COMPATIBILITY	EC4 PLUS	
NON-VITAL CHANGE	1	CYCLES
VITAL CHANGE	2	CYCLES
SHUNT DROP	2	CYCLES
SHUNT PICK	5	CYCLES
CURRENT LIMIT	*	mA

CODED TRACK OPERATING PARAMETERS

SLOT 8 (M8)		
PROPERTY	VALUE	UNITS
VCO VOLTAGE	*	mV
RECEIVE	TRUE	
TRANSMIT	TRUE	
CODE 5	ALTERNATING	
EC4 COMPATIBILITY	EC4 PLUS	
NON-VITAL CHANGE	1	CYCLES
VITAL CHANGE	2	CYCLES
SHUNT DROP	2	CYCLES
SHUNT PICK	5	CYCLES
CURRENT LIMIT	*	mA

COLORLIGHT OPERATING PARAMETERS

SLOT 3 (M3)		
PROPERTY	VALUE	UNITS
LAMP VOLTAGE	*	mV
FILAMENT THRESHOLD	0	mA
COLD FILAMENT TEST	YES	
VPI DEBOUNCE	20	mS

COLORLIGHT OPERATING PARAMETERS

SLOT 4 (M4)		
PROPERTY	VALUE	UNITS
LAMP VOLTAGE	*	mV
FILAMENT THRESHOLD	0	mA
COLD FILAMENT TEST	YES	
VPI DEBOUNCE	20	mS

RIO OPERATING PARAMETERS

SLOT 5 (M5)		
PROPERTY	VALUE	UNITS
VPI DEBOUNCE	20	mS

CODE 5 COMMENTS

2EGBK OFF = CODE 5 NOT GENERATED OUT EAST TRACK.

2EGBK ON = CODE 5 GENERATED OUT EAST TRACK.

2EGBK ON TK = CODE 5 GENERATED OUT EAST TRACK IF CODE 1 IS RECEIVED FROM WEST TRACK.

2EGBK REPEAT = CODE 5 GENERATED OUT EAST TRACK IF CODE 5 IS RECEIVED FROM WEST TRACK.

2WGBK OFF = CODE 5 NOT GENERATED OUT WEST TRACK.

2WGBK ON = CODE 5 GENERATED OUT WEST TRACK.

2WGBK ON TK = CODE 5 GENERATED OUT WEST TRACK IF CODE 1 IS RECEIVED FROM EAST TRACK.

2WGBK REPEAT = CODE 5 GENERATED OUT WEST TRACK IF CODE 5 IS RECEIVED FROM EAST TRACK.

GENERAL

2WWLNWPOPT = WEST NWP OPTION (ENABLED MEANS THE UNIT MUST SEE BATTERY ON WEST NWP INPUT) ENABLED IS THE DEFAULT.

2EWLNWPOPT = EAST NWP OPTION (ENABLED MEANS THE UNIT MUST SEE BATTERY ON EAST NWP INPUT) ENABLED IS THE DEFAULT.

2WWLNWP = APPLIES TO NWP INPUTS FROM OVERLAY TRACK CIRCUITS ONLY. GEO MUST SEE THE TRACK SHUNTED WITHIN 10 SECONDS OF WEST NWP INPUT GOING LOW IN ORDER TO PERMIT THE STICK TO SET.

2WWLWFD = FALL DOWN TIMER (REMOVAL OF WEST NWP FOR 20 SECONDS WILL OUTPUT 2WLR IF CONDITIONS PERMIT).

2EWLNWP = APPLIES TO NWP INPUTS FROM OVERLAY TRACK CIRCUITS ONLY. GEO MUST SEE THE TRACK SHUNTED WITHIN 10 SECONDS OF WEST NWP INPUT GOING LOW IN ORDER TO PERMIT THE STICK TO SET.

2EWLWFD = FALL DOWN TIMER (REMOVAL OF EAST NWP FOR 20 SECONDS WILL OUTPUT 2ELR IF CONDITIONS PERMIT).

2WWLAUXBK = IF SET TO "OFF" AND WEST NWP INPUT OPENS THE UNIT WILL NOT SEND ANY C5 OUT EITHER DIRECTION. SENDS NO CODE INTO OPEN AUX. AND A CODE 1 & 6 IN THE OPPOSITE DIRECTION.

2EWLAUXBK = IF SET TO "OFF" AND EAST NWP INPUT OPENS THE UNIT WILL NOT SEND ANY C5 OUT EITHER DIRECTION. SENDS NO CODE INTO OPEN AUX. AND A CODE 1 & 6 IN THE OPPOSITE DIRECTION.

2WGAL = WEST POWER OFF APPROACH LIGHT MODE.

2EGAL = EAST POWER OFF APPROACH LIGHT MODE.

2EC3OPT = EAST CODE 3 OUT OPTION. IF CODE 8 RECEIVED FROM WEST, AND OPTION SET FALSE, SENDS CODE 7 OUT EAST TRACK. IF TRUE, SENDS CODE 3 OUT EAST TRACK.

2WC3OPT = WEST CODE 3 OUT OPTION. IF CODE 8 RECIVED FROM EAST, AND OPTION SET FALSE, SENDS CODE 7 OUT WEST TRACK. IF TRUE, SENDS CODE 3 OUT WEST TRACK.

NOTE:

1. * = VALUE TO BE FILLED IN BY FIELD FORCES.

SETUP VITAL OPTIONS

VITAL USER OPTIONS		
USER OPTION	VALUE	UNITS
2EVLNWPOPT	ENABLED	N/A
2WWLNWPOPT	ENABLED	N/A
2EC3OPT	TRUE	N/A
2WC3OPT	TRUE	N/A
VITAL USER TIMERS		
TIMERS	VALUE	UNITS
2EVLNWP	10	SEC
2EWLWFD	20	SEC
2WWLNWP	10	SEC
2WWLWFD	20	SEC

INTERRAIL ENGINEERING

18049

INCORPORATED

RED = IN

YELLOW = OUT

DATE: 05-09-2018

NS PROJ.#10.3208

IRE/JWB/DBS

NON-VITAL USER OPTIONS				
OPTIONS	WEST TRACK (SLOT 2)		EAST TRACK (SLOT 8)	
CODE 5	2WGBK OFF	<input type="checkbox"/>	2EGBK OFF	<input checked="" type="checkbox"/>
	2WGBK ON	<input type="checkbox"/>	2EGBK ON	<input type="checkbox"/>
	2WGBK ON TRACK	<input type="checkbox"/>	2EGBK ON TRACK	<input type="checkbox"/>
	2WGBK REPEAT	<input checked="" type="checkbox"/>	2EGBK REPEAT	<input type="checkbox"/>
APPROACH LIGHTING	2WGAL TRUE	<input checked="" type="checkbox"/>	2EGAL TRUE	<input checked="" type="checkbox"/>
	2WGAL FALSE	<input type="checkbox"/>	2EGAL FALSE	<input type="checkbox"/>
AUX BLOCK	2WWLAUXBK OFF	<input checked="" type="checkbox"/>	2EWLAUXBK OFF	<input checked="" type="checkbox"/>
	2WWLAUXBK OFF ADJ	<input type="checkbox"/>	2EWLAUXBK OFF ADJ	<input type="checkbox"/>
	2WWLAUXBK OFF AUX	<input type="checkbox"/>	2EWLAUXBK OFF AUX	<input type="checkbox"/>
	2WWLAUXBK ON	<input type="checkbox"/>	2EWLAUXBK ON	<input type="checkbox"/>

GEO TRACK 2 USER OPTIONS AND OPERATING PARAMETERS

DESIGNED BY:	<div><div></div><div>NS NORFOLK SOUTHERN</div></div>		
RJT 03-28-05			
DRAWN BY:	OFFICE OF ASS'T. VICE PRESIDENT	M.P.: B-309.10	
SSC 03-28-05	COMM. & SIGNAL, ATLANTA, GA.		
CHECKED BY:	BELLEVUE, OH TO FORT WAYNE, IN		
LAR 03-30-05	AUTOMATIC SIGNALS - 3090/3093 AND 3091/3092		
IN SERVICE:	FOSTORIA DISTRICT		FILE NO. R-1884
MAL 12-04-06	CADD or DWG. No.	FSBT30910.07	SHEET No. 7 of 28
		FSBT30910.09	9 28

CODED TRACK OPERATING PARAMETERS

SLOT 2 (M2)		
PROPERTY	VALUE	UNITS
VCO VOLTAGE	*	mV
RECEIVE	TRUE	
TRANSMIT	TRUE	
CODE 5	ALTERNATING	
EC4 COMPATIBILITY	EC4 PLUS	
NON-VITAL CHANGE	1	CYCLES
VITAL CHANGE	2	CYCLES
SHUNT DROP	2	CYCLES
SHUNT PICK	5	CYCLES
CURRENT LIMIT	*	mA

CODED TRACK OPERATING PARAMETERS

SLOT 8 (M8)		
PROPERTY	VALUE	UNITS
VCO VOLTAGE	*	mV
RECEIVE	TRUE	
TRANSMIT	TRUE	
CODE 5	ALTERNATING	
EC4 COMPATIBILITY	EC4 PLUS	
NON-VITAL CHANGE	1	CYCLES
VITAL CHANGE	2	CYCLES
SHUNT DROP	2	CYCLES
SHUNT PICK	5	CYCLES
CURRENT LIMIT	*	mA

COLORLIGHT OPERATING PARAMETERS

SLOT 3 (M3)		
PROPERTY	VALUE	UNITS
LAMP VOLTAGE	*	mV
FILAMENT THRESHOLD	0	mA
COLD FILAMENT TEST	YES	
VPI DEBOUNCE	20	mS

COLORLIGHT OPERATING PARAMETERS

SLOT 4 (M4)		
PROPERTY	VALUE	UNITS
LAMP VOLTAGE	*	mV
FILAMENT THRESHOLD	0	mA
COLD FILAMENT TEST	YES	
VPI DEBOUNCE	20	mS

RIO OPERATING PARAMETERS

SLOT 5 (M5)		
PROPERTY	VALUE	UNITS
VPI DEBOUNCE	20	mS

CODE 5 COMMENTS

4EGBK OFF = CODE 5 NOT GENERATED OUT EAST TRACK.

4EGBK ON = CODE 5 GENERATED OUT EAST TRACK.

4EGBK ON TK = CODE 5 GENERATED OUT EAST TRACK IF CODE 1 IS RECEIVED FROM WEST TRACK.

4EGBK REPEAT = CODE 5 GENERATED OUT EAST TRACK IF CODE 5 IS RECEIVED FROM WEST TRACK.

4WGBK OFF = CODE 5 NOT GENERATED OUT WEST TRACK.

4WGBK ON = CODE 5 GENERATED OUT WEST TRACK.

4WGBK ON TK = CODE 5 GENERATED OUT WEST TRACK IF CODE 1 IS RECEIVED FROM EAST TRACK.

4WGBK REPEAT = CODE 5 GENERATED OUT WEST TRACK IF CODE 5 IS RECEIVED FROM EAST TRACK.

GENERAL

4WWLNWPOPT = WEST NWP OPTION (ENABLED MEANS THE UNIT MUST SEE BATTERY ON WEST NWP INPUT) ENABLED IS THE DEFAULT.

4EWLNWPOPT = EAST NWP OPTION (ENABLED MEANS THE UNIT MUST SEE BATTERY ON EAST NWP INPUT) ENABLED IS THE DEFAULT.

4WWLNWP = APPLIES TO NWP INPUTS FROM OVERLAY TRACK CIRCUITS ONLY. GEO MUST SEE THE TRACK SHUNTED WITHIN 10 SECONDS OF WEST NWP INPUT GOING LOW IN ORDER TO PERMIT THE STICK TO SET.

4WWLWFD = FALL DOWN TIMER (REMOVAL OF WEST NWP FOR 20 SECONDS WILL OUTPUT 4WLR IF CONDITIONS PERMIT).

4EWLNWP = APPLIES TO NWP INPUTS FROM OVERLAY TRACK CIRCUITS ONLY. GEO MUST SEE THE TRACK SHUNTED WITHIN 10 SECONDS OF WEST NWP INPUT GOING LOW IN ORDER TO PERMIT THE STICK TO SET.

4EWLWFD = FALL DOWN TIMER (REMOVAL OF EAST NWP FOR 20 SECONDS WILL OUTPUT 4ELR IF CONDITIONS PERMIT).

4WWLAUXBK = IF SET TO "OFF" AND WEST NWP INPUT OPENS THE UNIT WILL NOT SEND ANY C5 OUT EITHER DIRECTION. SENDS NO CODE INTO OPEN AUX. AND A CODE 1 & 6 IN THE OPPOSITE DIRECTION.

4EWLAUXBK = IF SET TO "OFF" AND EAST NWP INPUT OPENS THE UNIT WILL NOT SEND ANY C5 OUT EITHER DIRECTION. SENDS NO CODE INTO OPEN AUX. AND A CODE 1 & 6 IN THE OPPOSITE DIRECTION.

4WGAL = WEST POWER OFF APPROACH LIGHT MODE.

4EGAL = EAST POWER OFF APPROACH LIGHT MODE.

4EC3OPT = EAST CODE 3 OUT OPTION. IF CODE 8 RECEIVED FROM WEST, AND OPTION SET FALSE, SENDS CODE 7 OUT EAST TRACK. IF TRUE, SENDS CODE 3 OUT EAST TRACK.

4WC3OPT = WEST CODE 3 OUT OPTION. IF CODE 8 RECIVED FROM EAST, AND OPTION SET FALSE, SENDS CODE 7 OUT WEST TRACK. IF TRUE, SENDS CODE 3 OUT WEST TRACK.

NOTE:


1. * = VALUE TO BE FILLED IN BY FIELD FORCES.

SETUP VITAL OPTIONS

VITAL USER OPTIONS		
USER OPTION	VALUE	UNITS
4EVLNWPOPT	ENABLED	N/A
4WWLNWPOPT	ENABLED	N/A
4EC3OPT	TRUE	N/A
4WC3OPT	TRUE	N/A

VITAL USER TIMERS

TIMERS	VALUE	UNITS
4EVLNWP	10	SEC
4EWLWFD	20	SEC
4WWLNWP	10	SEC
4WWLWFD	20	SEC

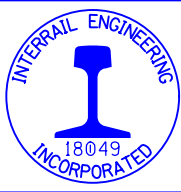

RED = IN


YELLOW = OUT


DATE: 05-09-2018
NS PROJ.#10.3208
IRE/JWB/DBS

NON-VITAL USER OPTIONS

OPTIONS	WEST TRACK (SLOT 2)		EAST TRACK (SLOT 8)	
CODE 5	4WGBK OFF	_____	4EGBK OFF	___X___
	4WGBK ON	_____	4EGBK ON	_____
	4WGBK ON TRACK	_____	4EGBK ON TRACK	_____
	4WGBK REPEAT	___X___	4EGBK REPEAT	_____
APPROACH LIGHTING	4WGAL TRUE	___X___	4EGAL TRUE	___X___
	4WGAL FALSE	_____	4EGAL FALSE	_____
AUX BLOCK	4WWLAUXBK OFF	___X___	4EWLAUXBK OFF	___X___
	4WWLAUXBK OFF ADJ	_____	4EWLAUXBK OFF ADJ	_____
	4WWLAUXBK OFF AUX	_____	4EWLAUXBK OFF AUX	_____
	4WWLAUXBK ON	_____	4EWLAUXBK ON	_____

GEO TRACK 4 USER OPTIONS AND OPERATING PARAMETERS

DESIGNED BY:			
RJT 03-28-05			
DRAWN BY:	OFFICE OF ASS'T. VICE PRESIDENT	M.P.: B-309.10	
SSC 03-28-05	COMM. & SIGNAL, ATLANTA, GA.		
CHECKED BY:	BELLEVUE, OH TO FORT WAYNE, IN		
LAR 03-30-05	AUTOMATIC SIGNALS - 3090/3093 AND 3091/3092		
IN SERVICE:	FOSTORIA DISTRICT		FILE NO. R-1884
MAL 12-04-06	CADD or DWG. No.	FSBT30910.08	SHEET No. 8 of 28
		FSBT30910.10	10 28

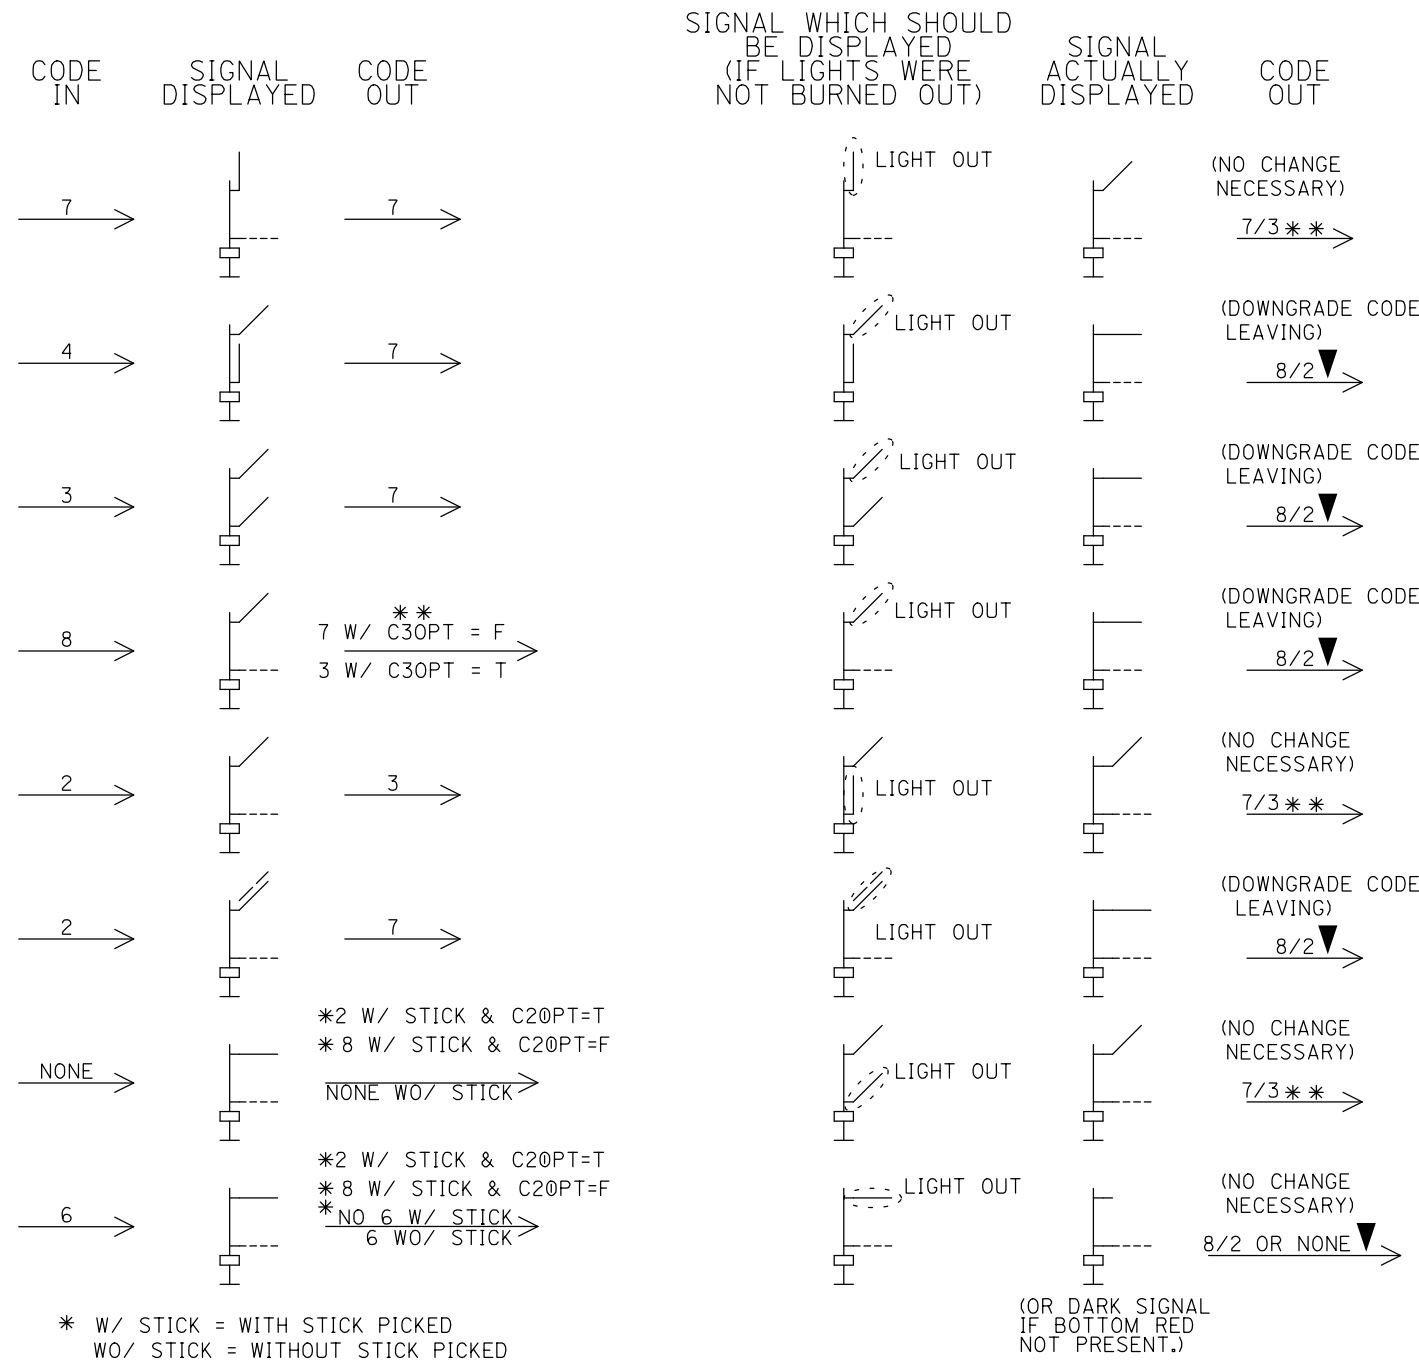

* W/ STICK = WITH STICK PICKED
WO/ STICK = WITHOUT STICK PICKED
★ FOR FLASHING YELLOW ASPECT SEE PROGRAM INFORMATION AT RIGHT

(OR DARK SIGNAL IF BOTTOM RED NOT PRESENT.)

RED = IN
YELLOW = OUT

DATE: 05-09-2018
NS PROJ.#10.3208
IRE/JWB/DBS

INTERFAC ENGINEERING
18049
INCORPORATED

PROGRAM " EGEONSCLO02"

LOGIC IS SYMMETRICAL FOR AUTOMATIC SIGNAL LOCATIONS.

RED ASPECT MAY OR MAY NOT BE PRESENT ON BOTTOM HEAD, IF NOT PRESENT, BOTTOM ASPECT (SHOWN DOTTED) WILL BE DARK WHEN DIAGRAM SHOWS BOTTOM RED ASPECT DISPLAYED.

LOSS OF AN AUX INPUT WILL DISABLE ALL CODES IN AND ALL CODES OUT FOR THAT DIRECTION.

CODES SHOWN IN DIAGRAMS ARE IN ADDITION TO CODE 1, (TRACK CODE), AND POSSIBLY CODE 5, (INDICATION CODE).

A MOVE PAST A PROCEED SIGNAL WILL PICK THE STICK AND SEND OUT A CODE 8 FOR A FOLLOW UP MOVE. AT AN INTERMEDIATE LOCATION, THE OPPOSING SIGNAL WILL REMAIN RED AS LONG AS THE STICK REMAINS PICKED.

THE SYSTEM USES A 10 SECOND LOSS OF SHUNT IN JOINT HOP LOGIC AND ANY VITAL CODES OUT ARE DOWNGRADED TO CODE 8 INTO THE OCCUPIED TRACK.


- ★ FOR FLASHING YELLOW ASPECT WEST, INSTALL B12 JUMPER TO J8-2 AND N12 JUMPER TO J8-1. FOR FLASHING YELLOW ASPECT EAST, INSTALL B12 JUMPER TO J9-1 AND N12 JUMPER TO J9-2.

SIGNALS ARE CONTINUOUSLY LIT WHEN AC POWER REPEATER INPUT IS PRESENT ACROSS TERMINALS J9-3 & J9-4.

THIS PROGRAM CAN BE USED FOR COLORLIGHT SIGNALS ONLY.

- ▼ EC2OPTOPT - TRUE WILL TRANSMIT CODE 2 OUT EAST TRACK. FALSE WILL TRANSMIT CODE 8 OUT EAST TRACK, WHEN WEST STICK IS PICKED OR SIGNAL DOWNGRADED TO RED.
- ▼ WC2OPTOPT - TRUE WILL TRANSMIT CODE 2 OUT WEST TRACK. FALSE WILL TRANSMIT CODE 8 OUT WEST TRACK, WHEN EAST STICK IS PICKED OR SIGNAL DOWNGRADED TO RED.
- ** EC3OPT - TRUE WILL TRANSMIT CODE 3 OUT EAST TRACK. FALSE WILL TRANSMIT CODE 7 OUT EAST TRACK, WHEN DISPLAYING WESTBOUND APPROACH SIGNAL.
- ** WC3OPT - TRUE WILL TRANSMIT CODE 3 OUT WEST TRACK. FALSE WILL TRANSMIT CODE 7 OUT WEST TRACK, WHEN DISPLAYING EASTBOUND APPROACH SIGNAL.



ASPECTS

DESIGNED BY:		 NORFOLK SOUTHERN	
RJT	03-28-05		
DRAWN BY:		OFFICE OF ASS'T. VICE PRESIDENT	M.P.: B-309.10
SSC	03-28-05	COMM. & SIGNAL, ATLANTA, GA.	
CHECKED BY:		BELLEVUE, OH TO FORT WAYNE, IN	
LAR	03-30-05	AUTOMATIC SIGNALS - 3090/3093 AND 3091/3092	
IN SERVICE:		FOSTORIA DISTRICT	FILE No. R-1884
MAL	12-04-06	CADD or DWG. No. FSBT30910.09	SHEET No. 9 of 28


FSBT30910.11

11

28

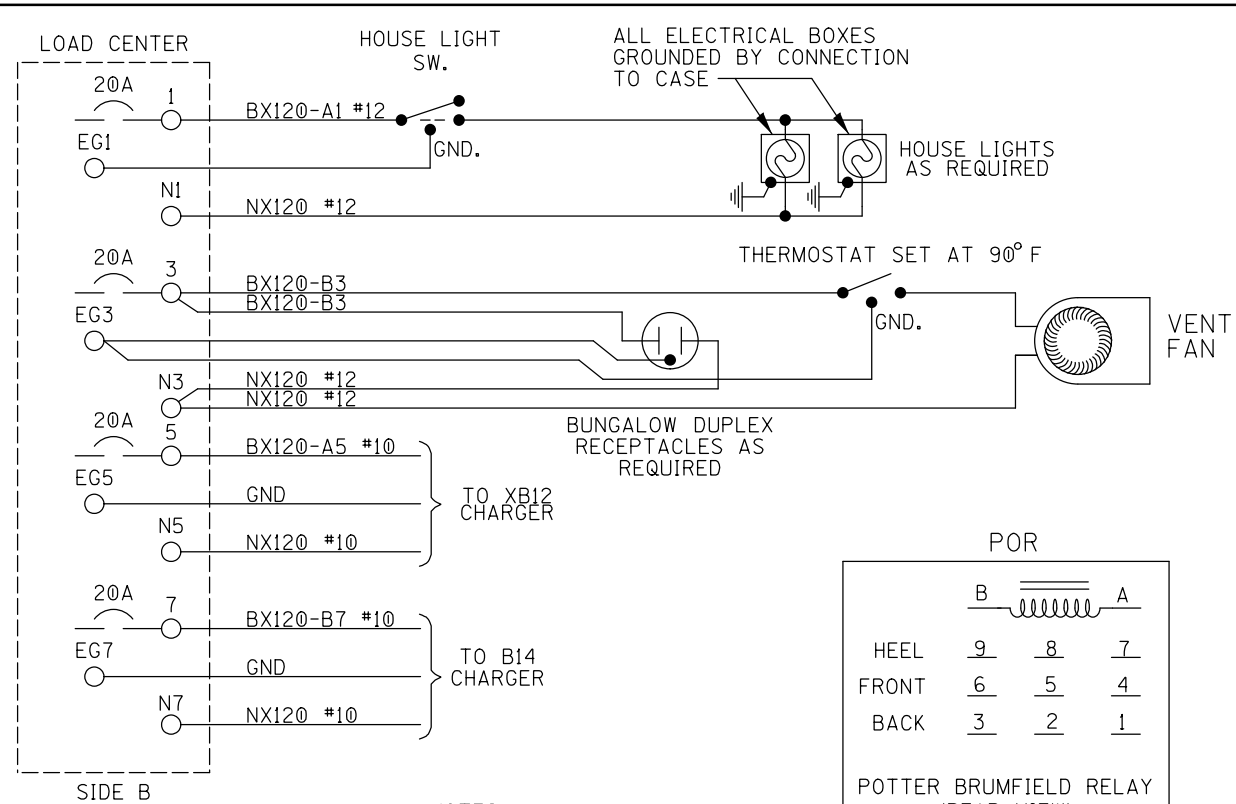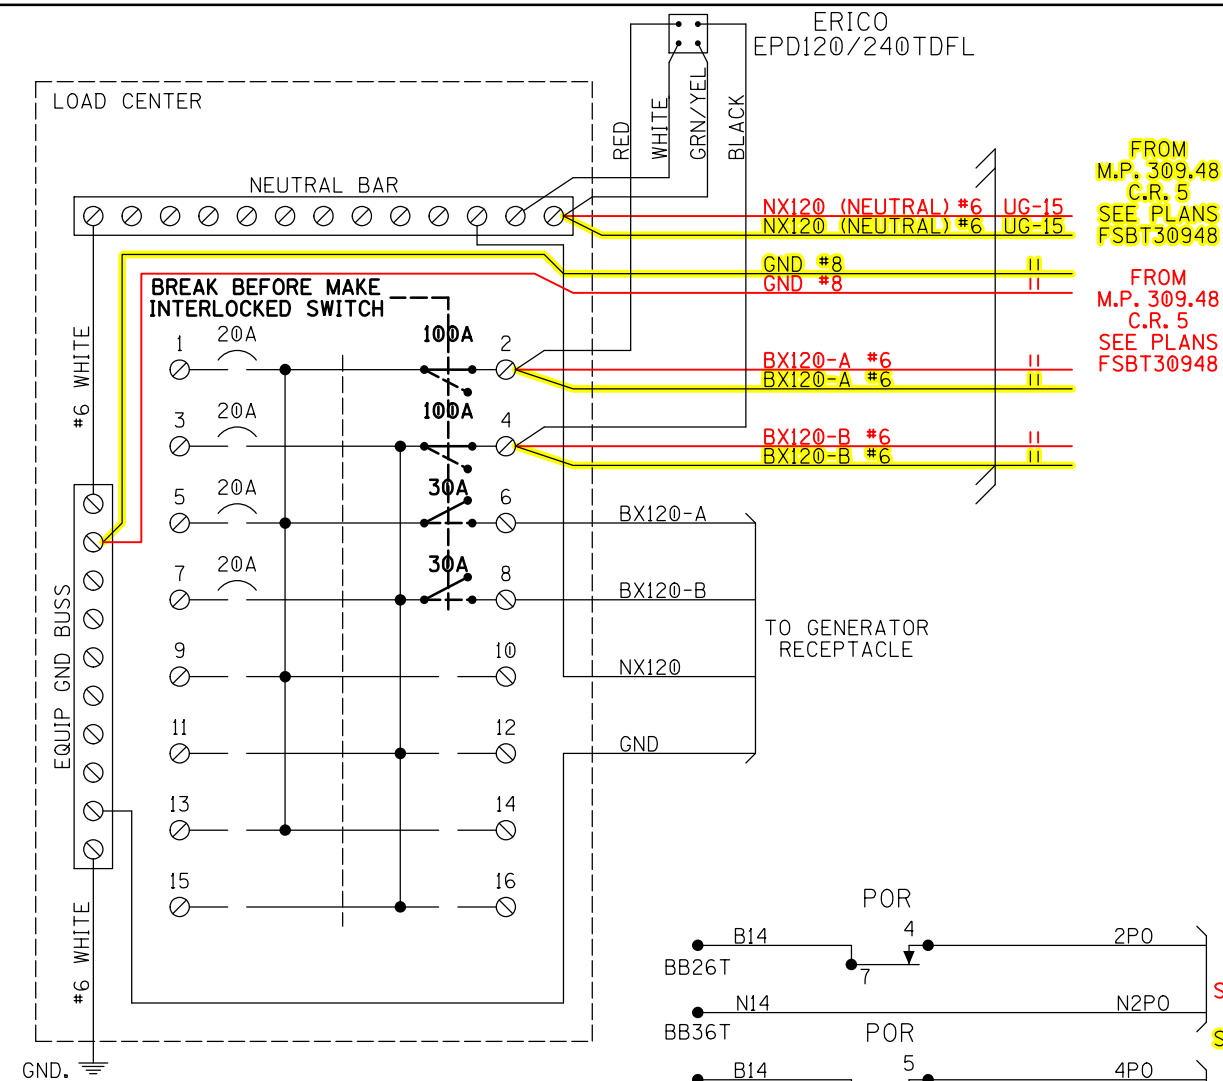

- NOTES:
1. IF ONLY USING 120VAC FROM POWER SOURCE, ELIMINATE BX120-B, MOVE BLACK ARRESTER LEAD FROM TERMINAL 4 TO TERMINAL 2 AND RELOCATE CIRCUIT BREAKER IN SLOT #3 TO SLOT #9.
 2. ALL WIRING TO BE #16AWG UNLESS NOTED OTHERWISE.
 3. " = TWIST BATTERY LEADS
 4. # = POSITION IN WAGO CONN.

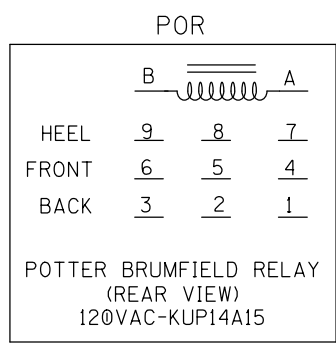

SQUARE "D" PART NUMBERS:

LOAD CENTER——Q0116L125G

100A 2P CIR BKR——Q02100

30A 2P CIR BKR——Q0230

MECH INTERLOCK——PK4DTIM4LA

GENERATOR RECEPTACLE:

MALE CONNECTOR - NEMA L1430-F1

INTERRAIL ENGINEERING

18049 INCORPORATED

RED = IN

YELLOW = OUT


DATE: 05-09-2018



NS PROJ.#10,3208


IRE/JWB/DBS

LOAD CENTER,
B14 RECTIFIER & BATTERY

DESIGNED BY:	RJT 03-28-05	NS NORFOLK SOUTHERN	
DRAWN BY:	SSC 03-28-05	OFFICE OF ASS'T. VICE PRESIDENT COMM. & SIGNAL, ATLANTA, GA.	M.P.: B-309.10
CHECKED BY:	LAR 03-30-05	BELLEVUE, OH TO FORT WAYNE, IN AUTOMATIC SIGNALS - 3090/3093 AND 3091/3092	
IN SERVICE:	MAL 12-04-06	FOSTORIA DISTRICT	FILE No. R-1884
CADD or DWG. No.	FSBT30910.10	FSBT30910.12	SHEET No. 10 of 28

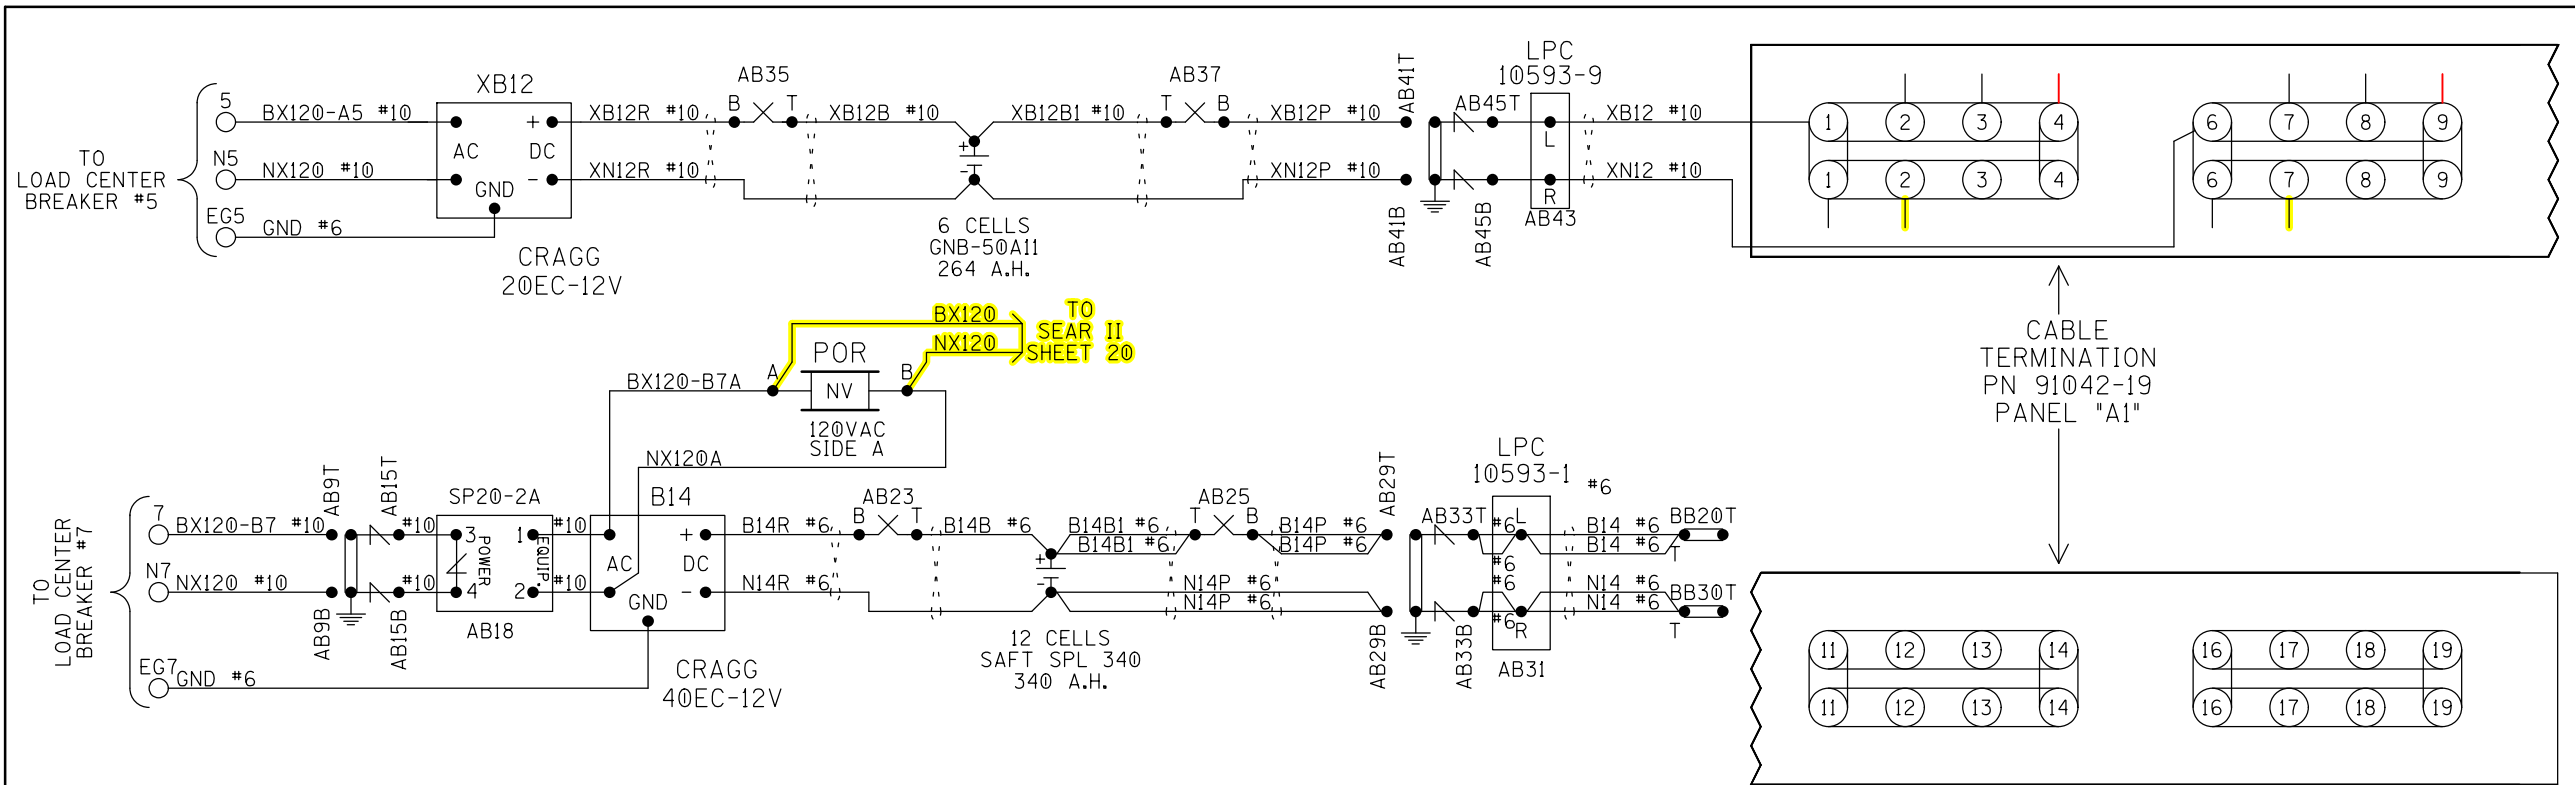

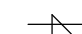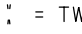- NOTES:
-  = CLEARVIEW ARRESTER
 -  = TWIST BATTERY LEADS

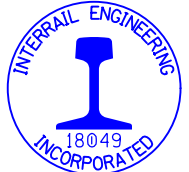

INTERRAIL ENGINEERING
18049
INCORPORATED


RED = IN
YELLOW = OUT

DATE: 05-09-2018
NS PROJ.#10.3208
IRE/JWB/DBS

XB12, B14
RECTIFIER AND BATTERY

REVISION					PROPERTY					DESIGNED BY:				
INITIALS					NORFOLK SOUTHERN RAILWAY CO.					RJT 03-28-05				
R-3493										DRAWN BY:				
NAG/08-18-15										SSC 03-28-05				
SII/07-25-17										CHECKED BY:				
										LAR 03-30-05				
										IN SERVICE:				
										MAL 12-04-06				
										CADD or				
										DWG. No. FSBT30910.11				
										FILE No. R-1884				
										SHEET No. 11 of 28				
										FSBT30910.13 13 28				

REVISION INITIALS										PROPERTY NORFOLK SOUTHERN RAILWAY CO.	IN SERVICE:	FUSTORIA DISTRICT	No. R-1884
											NAG 08-18-15	CADD or DWG. No. FSBT30910.12	SHEET 12 of 28
												FSBT30910.14	14 28

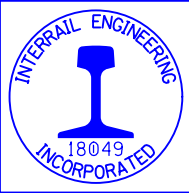


RED = IN
YELLOW = OUT


DATE: 05-09-2018
NS PROJ.#10.3208
IRE/JWB/DBS

GEO CONSOLE TRACK 2 PROGRAMMING

REVISION INITIALS											PROPERTY NORFOLK SOUTHERN RAILWAY CO.	IN SERVICE:	FOSTORIA DISTRICT		No.	R-1884	
												NAG	08-18-15	CADD or DWG. No.	FSBT30910.13	SHEET No.	13 of 28
														FSBT30910.15		15	28

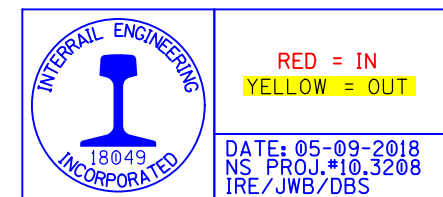

GEO CONSOLE TRACK 4 PROGRAMMING

DESIGNED BY:		 NORFOLK SOUTHERN	
MAG	03-22-13		
DRAWN BY:		OFFICE OF ASS'T. VICE PRESIDENT	M.P.: B-309.10
SII	03-22-13	COMM. & SIGNAL, ATLANTA, GA.	
CHECKED BY:		BELLEVUE, OH TO FORT WAYNE, IN	
SEK	06-12-13	AUTOMATIC SIGNALS - 3090/3093 AND 3091/3092	
IN SERVICE:		FOSTORIA DISTRICT	FILE No. R-1884
NAG	08-18-15	CADD or DWG. No. FSBT30910.15	SHEET No. 15 of 28
		FSBT30910.17	17 28

[illegible]


COMPONENT	PARAMETER	CONFIGURABLE IN	VALUE
WIU	WIU ADDRESS	FIELD OR BACK OFFICE	550.629.107.01
WIU	HMAC KEY	FIELD OR BACK OFFICE	TBD
WIU	PTC CONFIG CRC	FIELD OR BACK OFFICE	TBD
WIU	BROADCAST RATE	FIELD OR BACK OFFICE	1000 MS *
WIU	BroadcastOnChange (EVENT DRIVEN)	FIELD OR BACK OFFICE	NO *
WIU	BeaconContinuous	FIELD OR BACK OFFICE	1 *
WIU	BeaconBitTime	FIELD OR BACK OFFICE	300 SEC *
WIU	BeaconEnd	FIELD OR BACK OFFICE	120 SEC *
WIU	MaxBeaconInterval	FIELD OR BACK OFFICE	DISABLED *
WIU	EMP HEADER SOURCE ADDRESS	FIELD	TBD
WIU	CLASS C MULTICAST ADDRESS	FIELD	239.255.0.5 *
WIU	CLASS C PORT ADDRESS	FIELD	32768 *
WIU	EMP DEST ADDRESS	FIELD	TBD
WIU	TTL BEACON	FIELD OR BACK OFFICE	12 SEC *
WIU	TTL RESPONSE TO GET WIU STATUS	FIELD OR BACK OFFICE	12 SEC *
WIU	FLAGS BEACON	FIELD OR BACK OFFICE	00001001
WIU	FLAGS RESPONSE TO GET WIU STATUS	FIELD OR BACK OFFICE	00010001
WIU	QOS BEACON	FIELD OR BACK OFFICE	1656
WIU	QOS RESPONSE TO GET WIU STATUS	FIELD OR BACK OFFICE	3576
WIU	CLASS D MODE	FIELD OR BACK OFFICE	BIDIRECTIONAL *
WIU	AG IP ADDRESS (CLASS D)	FIELD OR BACK OFFICE	10.255.255.210 *
WIU	AG PORT (CLASS D)	FIELD OR BACK OFFICE	8001 *

CONFIGURABLE PARAMETERS SUMMARY

COMPONENT	PARAMETER	CONFIGURABLE IN	VALUE
WIU	CLASS D KEEP ALIVE INTERVAL	FIELD OR BACK OFFICE	9000ms *
WIU	CLASS D ACKNOWLEDGEMENT TIMEOUT	FIELD OR BACK OFFICE	3000ms *
WIU	CLASS D NAK RETRY COUNT	FIELD OR BACK OFFICE	2 *
WIU	CLASS D RETRANSMIT DELAY	FIELD OR BACK OFFICE	2000ms *
WIU	CLASS D CONNECT ATTEMPT TIMEOUT	FIELD OR BACK OFFICE	1000ms *
WIU	CLASS D CONNECT ATTEMPT DELAY	FIELD OR BACK OFFICE	1000ms *
WIU	CLASS D CONNECT ATTEMPT RETRY COUNT	FIELD OR BACK OFFICE	-1 *
WIU	CLASS D RECONNECT ATTEMPT RETRY COUNT	FIELD OR BACK OFFICE	-1 *
WIU	CLASS D DATA ACK ENABLED	FIELD OR BACK OFFICE	YES *
WIU	CLASS D LOG TRAFFIC	FIELD OR BACK OFFICE	NO *
WIU	TIME MESSAGES BEFORE SENDING WSM	FIELD OR BACK OFFICE	5 *
WIU	TIME MESSAGE DEVIATION	FIELD OR BACK OFFICE	1 SEC *
WIU	IGNORED TIME DIFFERENCE	FIELD OR BACK OFFICE	3 SEC *
WIU	MAXIMUM SECONDS TIME CHANGE	FIELD OR BACK OFFICE	3 SEC *
WIU	MAXIMUM TIME CHANGE WITHIN MINUTES	FIELD OR BACK OFFICE	60 MIN *
WIU	LRM MAXIMUM SECONDS TIME DIFFERENCE	FIELD OR BACK OFFICE	3 SEC *
WIU	NO TIME SYNC MESSAGE	FIELD OR BACK OFFICE	6 MIN *

CONFIGURABLE PARAMETERS SUMMARY (CONTINUED)


* = DEFAULT VALUE

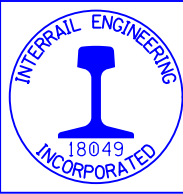

RED = IN
YELLOW = OUT


DATE: 05-09-2018
NS PROJ.#10.3208
IRE/JWB/DBS

PTC RADIO CONFIGURABLE PARAMETERS


DESIGNED BY:	 NORFOLK SOUTHERN		
MAG 03-22-13			
DRAWN BY:	OFFICE OF ASS'T. VICE PRESIDENT COMM. & SIGNAL, ATLANTA, GA.		M.P.: B-309.10
SII 03-22-13			
CHECKED BY:	BELLEVUE, OH TO FORT WAYNE, IN AUTOMATIC SIGNALS - 3090/3093 AND 3091/3092		
SEK 06-12-13			
IN SERVICE:	FOSTORIA DISTRICT		FILE No. R-1884
NAG 08-18-15	CADD or DWG. No.	FSBT30910.17 FSBT30910.19	SHEET No. 17 of 28 19 28

REVISION
INITIALS

PROPERTY
NORFOLK SOUTHERN RAILWAY CO.

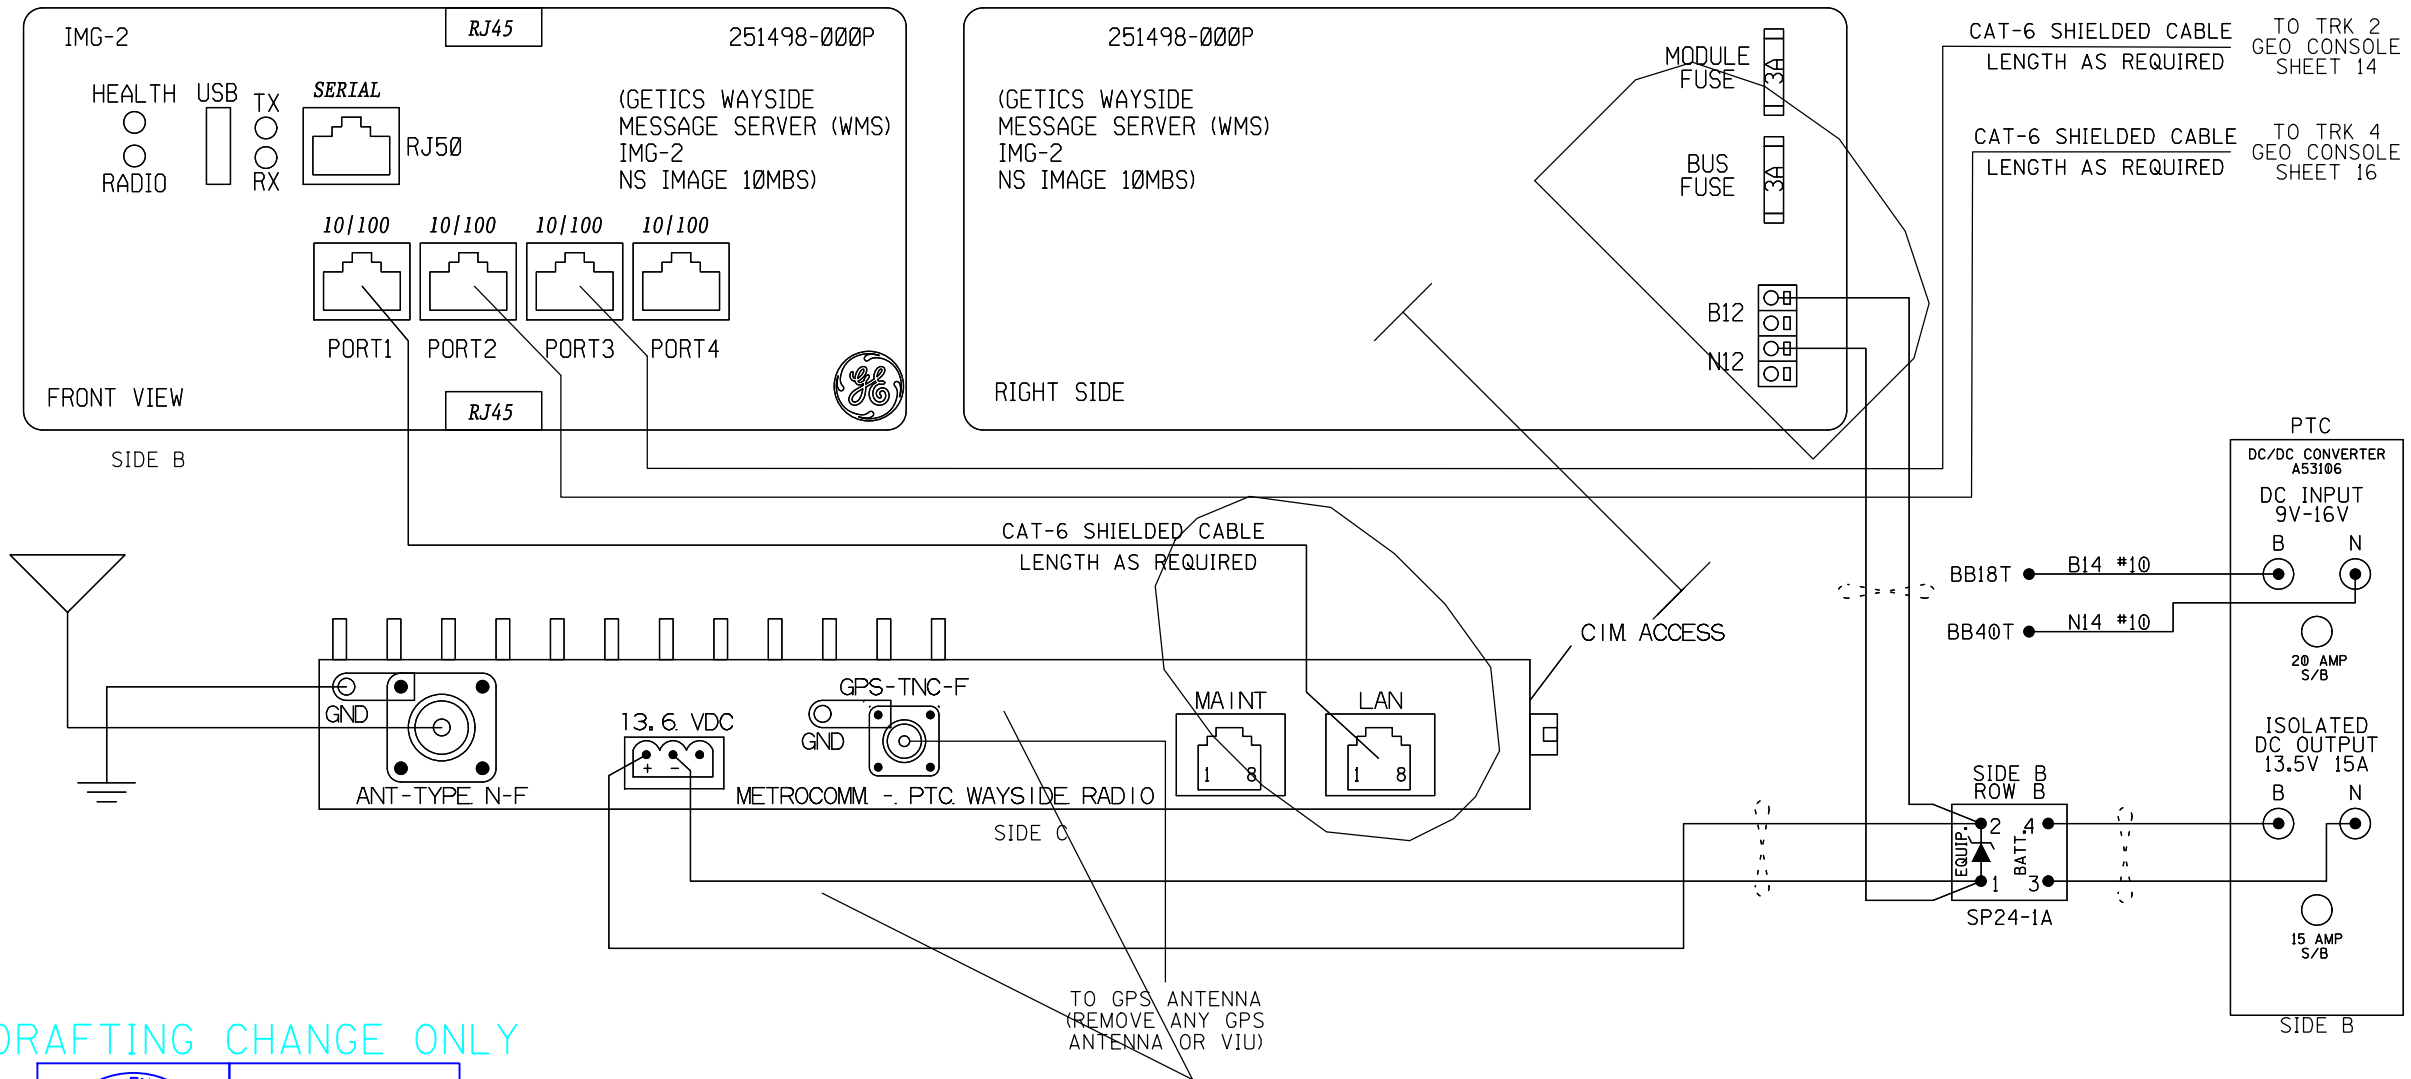

DRAFTING CHANGE ONLY

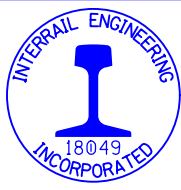

18049
INCORPORATED


THIS SHEET
VOID ON PROJECT
COMPLETION

DATE: 05-09-2018
NS PROJ.#10.3208
IRE/JWB/DBS

NOTE: PTC RADIO AND WMS POWER CONNECTOR
WAGO P/N 231-203/026-000

⋯ = TWIST

PTC RADIO AND MESSAGE SERVER

DESIGNED BY:		 NORFOLK SOUTHERN	
MAG	03-22-13		
DRAWN BY:		OFFICE OF ASS'T. VICE PRESIDENT COMM. & SIGNAL, ATLANTA, GA.	M.P.: B-309.10
SII	03-22-13		
CHECKED BY:		BELLEVUE, OH TO FORT WAYNE, IN AUTOMATIC SIGNALS - 3090/3093 AND 3091/3092	
SEK	06-12-13		
IN SERVICE:		FOSTORIA DISTRICT	FILE No. R-3493
NAG	08-18-15	CADD or DWG. No. FSBT30910.18AV	SHEET 18 of 28

REVISION
INITIALS

PROPERTY
NORFOLK SOUTHERN RAILWAY CO.

Program Report

Location and SIN

DOT Number: 000000R
Milepost Number: B309-48
Site Name: REMOTE LOCATION

SIN: 762010010016

MCF and Template Selection

MCF Name: GCP-T6X-02-1.mcf
MCF Revision: 021
MCF CRC: 6076E435

Template = 4A:6 Remotes

Check Numbers

Office Check No. (DT 4.6.0): 393D9227
Office Check Number: 393D9227
Config. Check Number: 537B44AA
(Based on MCF Revision 021)

Program

BASIC: module configuration

Track 1 Slot = Track
Track 2/RIO 1 Slot = Track
Track 3 Slot = Not Used
Track 4 Slot = Not Used
Track 5/RIO 2 Slot = Not Used
Track 6/RIO 3 Slot = Not Used
SSCC-1 Slot = Not Used
SSCC-2 Slot = Not Used
SEAR Used = No

BASIC: MS/GCP operation

Track 1: MS/GCP Operation = Yes
Track 2: MS/GCP Operation = Yes

BASIC: Island operation

Track 1: Island Used = No
Track 2: Island Used = No

BASIC: radio Dax links

Radio DAX link A Used = No
Radio DAX link B Used = No

BASIC: Vital Comms links

Vital Comms link 1 Used = No
Vital Comms link 2 Used = No

PREDICTORS: track 1

Track 1: Prime Used = No
Track 1: Dax A Used = Yes
Track 1: Dax B Used = No
Track 1: Dax C Used = No
Track 1: Dax D Used = No
Track 1: Dax E Used = No
Track 1: Dax F Used = No
Track 1: Dax G Used = No

PREDICTORS: track 2

Track 2: Prime Used = No
Track 2: Dax A Used = Yes
Track 2: Dax B Used = No
Track 2: Dax C Used = No
Track 2: Dax D Used = No
Track 2: Dax E Used = No
Track 2: Dax F Used = No
Track 2: Dax G Used = No

GCP: track 1

Track 1: GCP Freq Category = Standard
Track 1: GCP Frequency = 430 Hz
Track 1: Approach Distance = 1118 ft
Track 1: Uni/Bi/Sim-Bidirnl = Unidirnl
Track 1: GCP Transmit Level = Medium
Track 1: Island Connection = No Islands
Track 1: Island Distance = 0 ft
Track 1: Computed Distance = 9999 ft
Track 1: Linearization Steps = 100

GCP: track 1 enhanced det

Track 1: Inbound PS Sensitivity = Off
Track 1: Speed Limiting Used = Yes
Track 1: Outbound False Act Lvl = Normal
Track 1: Outbound PS Timer = 20 sec
Track 1: Trailing Switch Logic = On
Track 1: Post Joint Detn Time = 15 sec
Track 1: Adv Appr Predn = No
Track 1: Cancel Pickup Delay = This Isl

GCP: track 1 Dax A

Track 1: Dax A Warning Time = 30 sec
Track 1: Dax A Offset Distance = 1969 ft
Track 1: Switch MS EZ Level = 0
Track 1: Pickup Delay Mode = Auto
Track 1: Dax A MS/GCP Mode = Pred
Track 1: Dax A Pickup Delay = 15 sec
Track 1: Dax A Enable = Not Used

GCP: track 1 pos start

Track 1: Positive Start = Off
Track 1: Sudden Shnt Det Used = No
Track 1: Low EZ Detection Used = No

GCP: track 1 MS Control

Track 1: MS/GCP CtrlIP Used = No
Track 1: MS Sensitivity Level = 0
Track 1: Compensation Level = 1300
Track 1: Warn Time-Ballast Comp = Low
Track 1: Low EX Adjustment = 39
Track 1: Bidrn Dax Passthru = No
Track 1: False Act on Train Stop = No
Track 1: EX Limiting Used = Yes
Track 1: EZ Correction Used = Yes

GCP: track 2

Track 2: GCP Freq Category = Standard
Track 2: GCP Frequency = 430 Hz
Track 2: Approach Distance = 1118 ft
Track 2: Uni/Bi/Sim-Bidirnl = Unidirnl
Track 2: GCP Transmit Level = Medium
Track 2: Island Connection = No Islands
Track 2: Island Distance = 0 ft
Track 2: Computed Distance = 9999 ft
Track 2: Linearization Steps = 100

GCP: track 2 enhanced det

Track 2: Inbound PS Sensitivity = Off
Track 2: Speed Limiting Used = Yes
Track 2: Outbound False Act Lvl = Normal
Track 2: Outbound PS Timer = 20 sec
Track 2: Trailing Switch Logic = On
Track 2: Post Joint Detn Time = 15 sec
Track 2: Adv Appr Predn = No
Track 2: Cancel Pickup Delay = This Isl

GCP: track 2 Dax A

Track 2: Dax A Warning Time = 30 sec
Track 2: Dax A Offset Distance = 1969 ft
Track 2: Switch MS EZ Level = 0
Track 2: Pickup Delay Mode = Auto
Track 2: Dax A MS/GCP Mode = Pred
Track 2: Dax A Pickup Delay = 15 sec
Track 2: Dax A Enable = Not Used

GCP: track 2 pos start

Track 2: Positive Start = Off
Track 2: Sudden Shnt Det Used = No
Track 2: Low EZ Detection Used = No

GCP: track 2 MS Control

Track 2: MS/GCP CtrlIP Used = No
Track 2: MS Sensitivity Level = 0
Track 2: Compensation Level = 1300
Track 2: Warn Time-Ballast Comp = Low
Track 2: Low EX Adjustment = 39
Track 2: Bidrn Dax Passthru = No
Track 2: False Act on Train Stop = No
Track 2: EX Limiting Used = Yes
Track 2: EZ Correction Used = Yes

AND: track Anding

AND 1 XR Used = No
AND 2 Used = No
AND 3 Used = No
AND 4 Used = No
AND 5 Used = No
AND 6 Used = No
AND 7 Used = No
AND 8 Used = No

ADVANCED: MS restart

MS/GCP Restart Used = No

ADVANCED: out of service

00S Control = Display+00S IPs
00S Timeout = Yes
00S Timeout = 1 hrs

ADVANCED: out of service 2

T1 00S Control = 00S Input 1
T2 00S Control = 00S Input 1

ADVANCED: track wrap circuits

Wrap LOS Timer = 5 sec
Track 1 Wrap Used = No
Track 2 Wrap Used = No

ADVANCED: trk 1 overrides

Track 1: All Predictors Override Used = No
Track 1: Dax A Override Used = No

ADVANCED: trk 2 overrides

Track 2: All Predictors Override Used = No
Track 2: Dax A Override Used = No

ADVANCED: OR logic

OR 1 Used = No
OR 2 Used = No
OR 3 Used = No
OR 4 Used = No

ADVANCED: internal I/O 1

Pass Thrus = No
Int.1 Sets = Not Used
Int.1 Set by = Not Used
Int.2 Sets = Not Used
Int.2 Set by = Not Used
Int.3 Sets = Not Used
Int.3 Set by = Not Used
Int.4 Sets = Not Used
Int.4 Set by = Not Used

ADVANCED: internal I/O 2

Int.5 Sets = Not Used
Int.5 Set by = Not Used
Int.6 Sets = Not Used
Int.6 Set by = Not Used
Int.7 Sets = Not Used
Int.7 Set by = Not Used
Int.8 Sets = Not Used
Int.8 Set by = Not Used

ADVANCED: internal I/O 3

Int.9 Sets = Not Used
Int.9 Set by = Not Used
Int.10 Sets = Not Used
Int.10 Set by = Not Used
Int.11 Sets = Not Used
Int.11 Set by = Not Used
Int.12 Sets = Not Used
Int.12 Set by = Not Used

ADVANCED: internal I/O 4

Int.13 Sets = Not Used
Int.13 Set by = Not Used
Int.14 Sets = Not Used
Int.14 Set by = Not Used
Int.15 Sets = Not Used
Int.15 Set by = Not Used
Int.16 Sets = Not Used
Int.16 Set by = Not Used

ADVANCED: site options

Daylight Savings = Off
Units = Standard
Maint Call Rpt IP Used = No
Emergency Activate IP = No
EZ/EX Logging = Change
EZ/EX Point Change = 3

OUTPUT: assignment page 1

OUT 1.1 = T1 Dax A
OUT 1.2 = Not Used
OUT 2.1 = T2 Dax A
OUT 2.2 = Not Used

INPUT: assignment page 1


IN 1.1 = Not Used
IN 1.2 = Out Of Service IP 1
IN 2.1 = Not Used
IN 2.2 = Not Used

SITE: programming

Radio Subnode = 1
Field Password = Off
Low Battery Enabled = Off

Configuration Package File

Filename: FSBT30910.pac

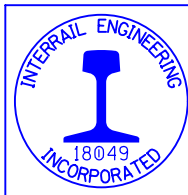


NEW SHEET

RED = IN

DATE: 05-09-2018
NS PROJ.#10.3208
IRE/JWB/DBS




4000 GCP PROGRAMMING SETUP

DESIGNED BY:	 NORFOLK SOUTHERN		
JWB 05-09-18			
DRAWN BY:	OFFICE OF ASS'T. VICE PRESIDENT COMM. & SIGNAL, ATLANTA, GA.	M.P.: B-309.10	
IRE 05-09-18			
CHECKED BY:	BELLEVUE TO FORT WAYNE AUTOMATIC SIGNALS - 3090/3093 AND 3091/3092		
DBS 05-10-18			
IN SERVICE:	FOSTORIA DISTRICT	FILE No.	R-1884
- -	CADD or DWG. No. FSBT30910.19	SHEET No.	19 of 28

REVISION
INITIALS

PROPERTY

NORFOLK SOUTHERN RAILWAY CO.

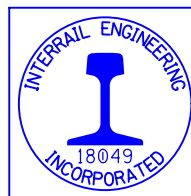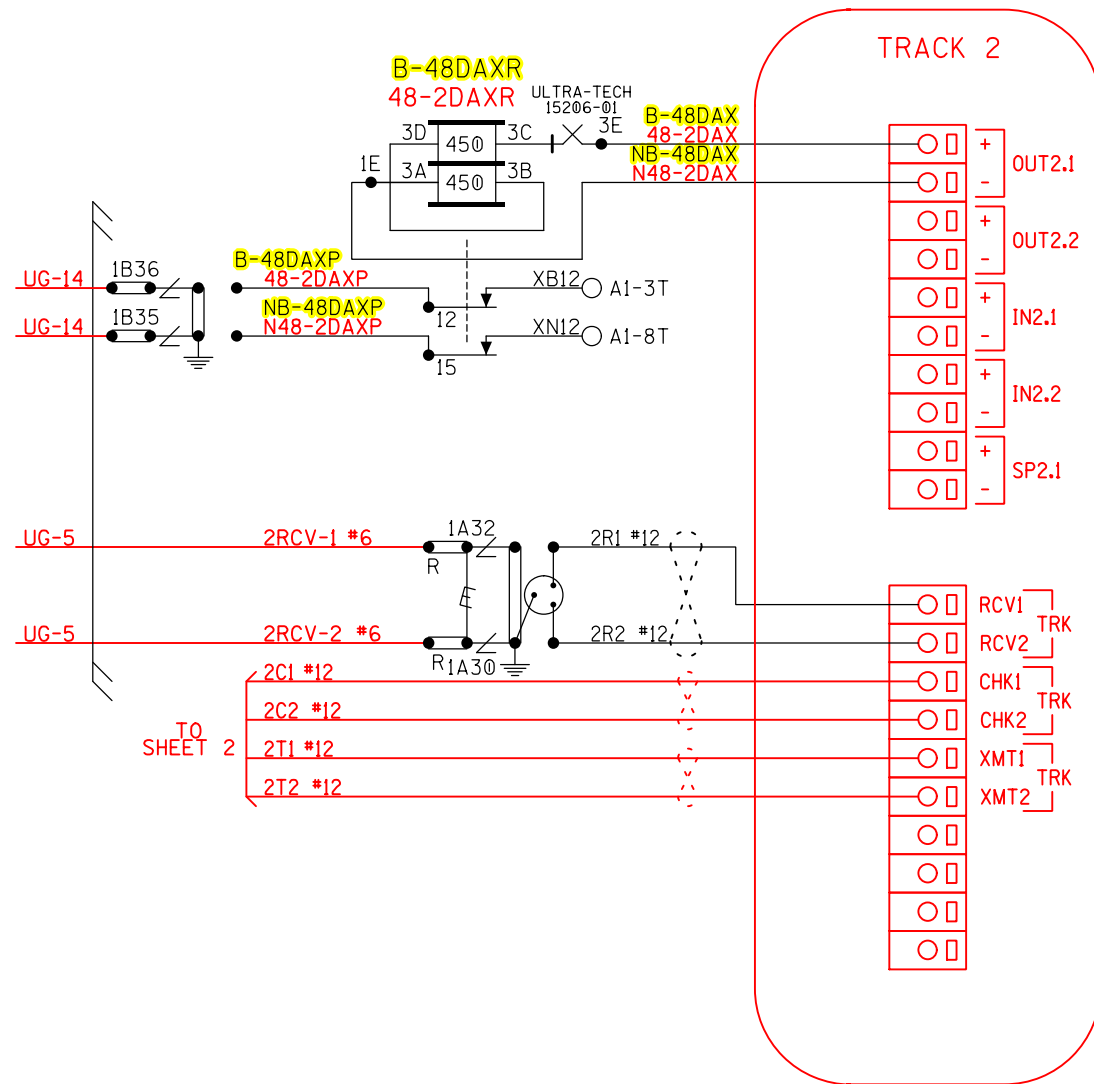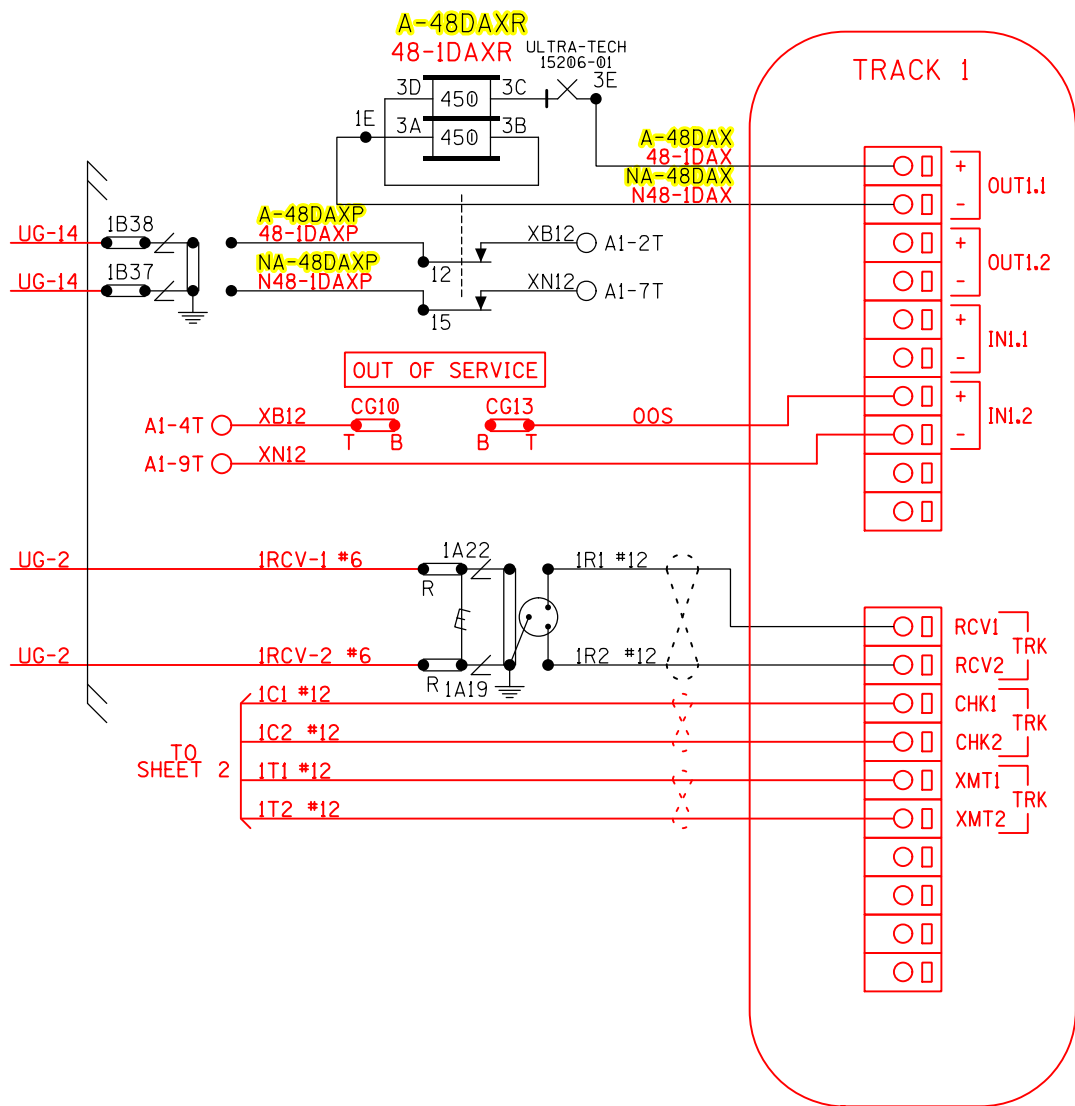

NEW SHEET

RED = IN
YELLOW = OUT
BLACK = EXISTING

DATE: 05-09-2018
NS PROJ.#10.3208
IRE/JWB/DBS

NOTES:
ALL WIRING TO BE #16AWG
UNLESS NOTED OTHERWISE.


⋈ = TWIST

CONNECTORS FOR TRACK MODULES


DESIGNED BY:	JWB 05-09-18	NS NORFOLK SOUTHERN	
DRAWN BY:	IRE 05-09-18	OFFICE OF ASS'T. VICE PRESIDENT COMM. & SIGNAL, ATLANTA, GA.	M.P.: B-309.10
CHECKED BY:	DBS 05-10-18	BELLEVUE TO FORT WAYNE AUTOMATIC SIGNALS - 3090/3093 AND 3091/3092	
IN SERVICE:	- -	FOSTORIA DISTRICT	FILE NO. R-1884
		CADD or DWG. No. FSBT30910.20	SHEET No. 20 of 28

REVISION
INITIALS

PROPERTY
NORFOLK SOUTHERN RAILWAY CO.

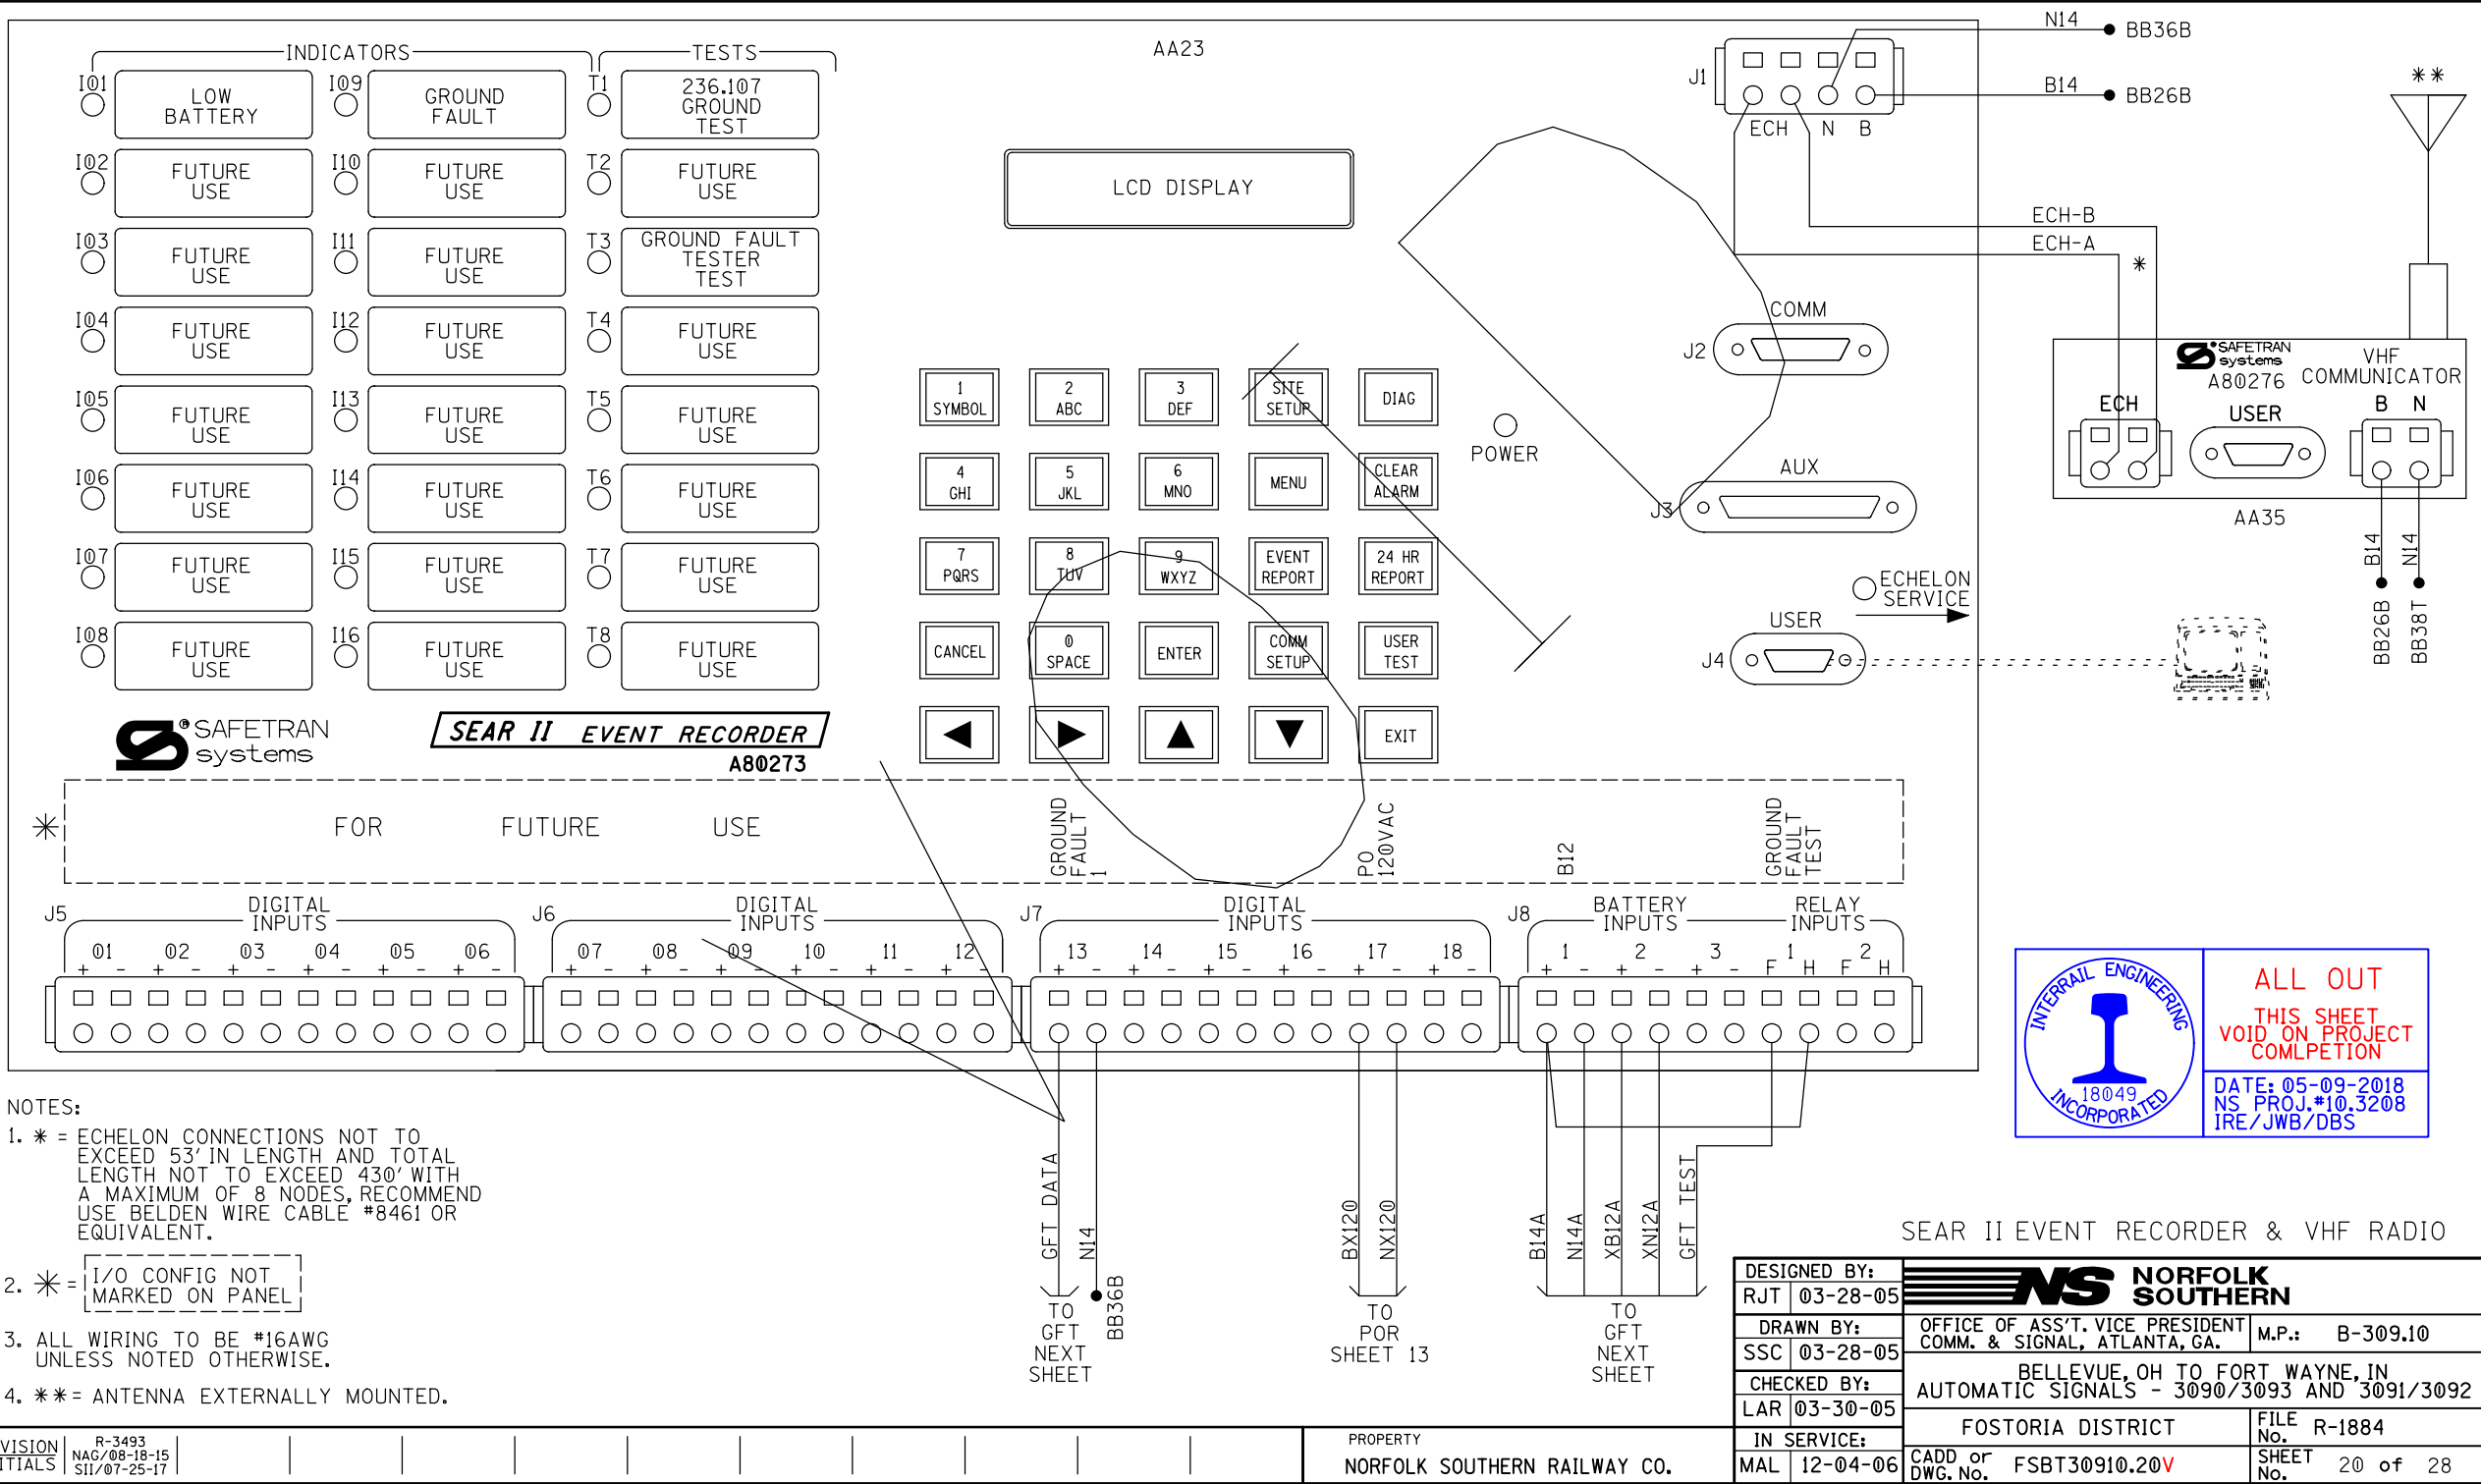

- NOTES:
- * = ECHELON CONNECTIONS NOT TO EXCEED 53' IN LENGTH AND TOTAL LENGTH NOT TO EXCEED 430' WITH A MAXIMUM OF 8 NODES, RECOMMEND USE BELDEN WIRE CABLE #8461 OR EQUIVALENT.
 - * = I/O CONFIG NOT MARKED ON PANEL
 - ALL WIRING TO BE #16AWG UNLESS NOTED OTHERWISE.
 - ** = ANTENNA EXTERNALLY MOUNTED.

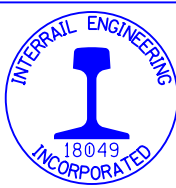


18049
INCORPORATED

ALL OUT
THIS SHEET
VOID ON PROJECT
COMPLETION


DATE: 05-09-2018
NS PROJ.#10.3208
IRE/JWB/DBS

SEAR II EVENT RECORDER & VHF RADIO

DESIGNED BY:	NS NORFOLK SOUTHERN		
RJT	03-28-05	OFFICE OF ASS'T. VICE PRESIDENT COMM. & SIGNAL, ATLANTA, GA.	M.P.: B-309.10
DRAWN BY:	SSC	BELLEVUE, OH TO FORT WAYNE, IN	
03-28-05	LAR	AUTOMATIC SIGNALS - 3090/3093 AND 3091/3092	
CHECKED BY:	IN SERVICE:	FOSTORIA DISTRICT	
03-30-05	12-04-06	FILE No. R-1884	
MAL	12-04-06	CADD or DWG. No. FSBT30910.20V	SHEET No. 20 of 28

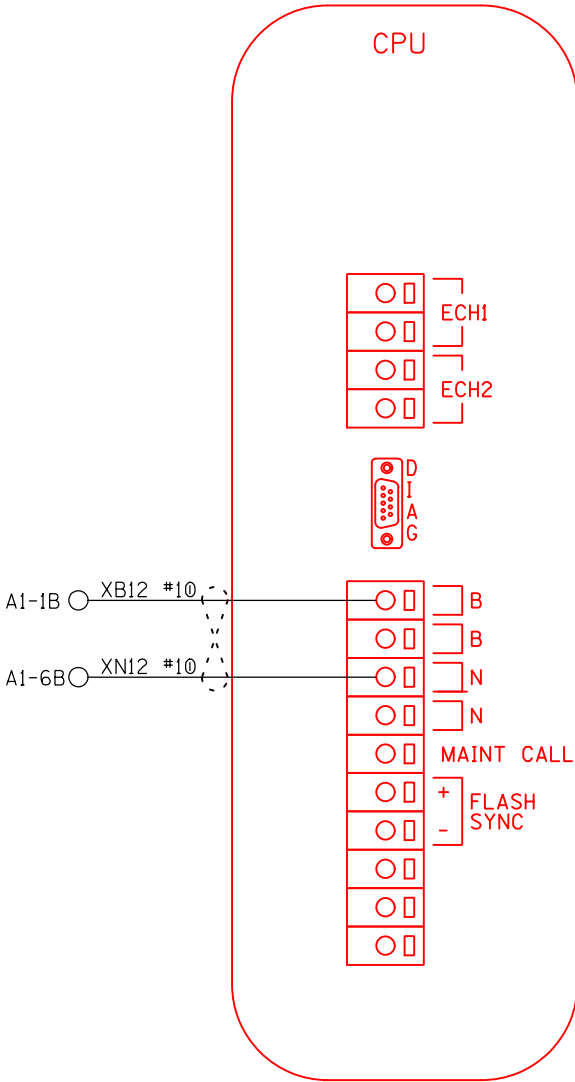

⋈ = TWIST

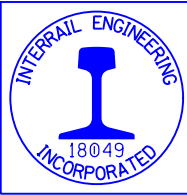


NEW SHEET

RED = IN
BLACK = EXISTING





DATE: 05-09-2018
NS PROJ.#10.3208
IRE/JWB/DBS

CONNECTORS FOR CPU MODULE

DESIGNED BY:	 NORFOLK SOUTHERN		
JWB 05-09-18			
DRAWN BY:	OFFICE OF ASS'T. VICE PRESIDENT COMM. & SIGNAL, ATLANTA, GA.		M.P.: B-309.10
IRE 05-09-18			
CHECKED BY:	BELLEVUE TO FORT WAYNE AUTOMATIC SIGNALS - 3090/3093 AND 3091/3092		
DBS 05-10-18			
IN SERVICE:	FOSTORIA DISTRICT		FILE No. R-1884
- -	CADD or DWG. No. FSBT30910.21		SHEET 21 of 28

REVISION
INITIALS

PROPERTY
NORFOLK SOUTHERN RAILWAY CO.

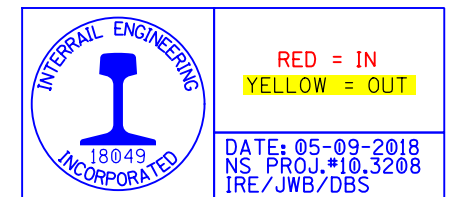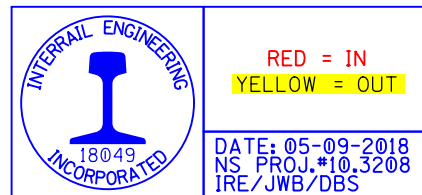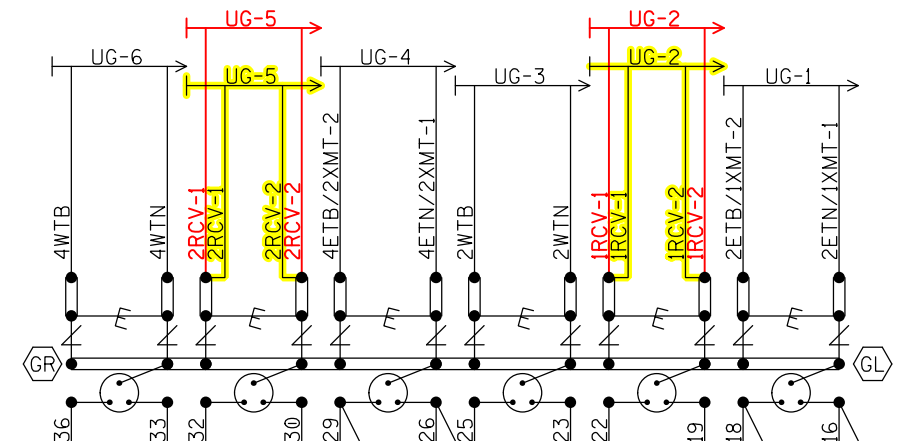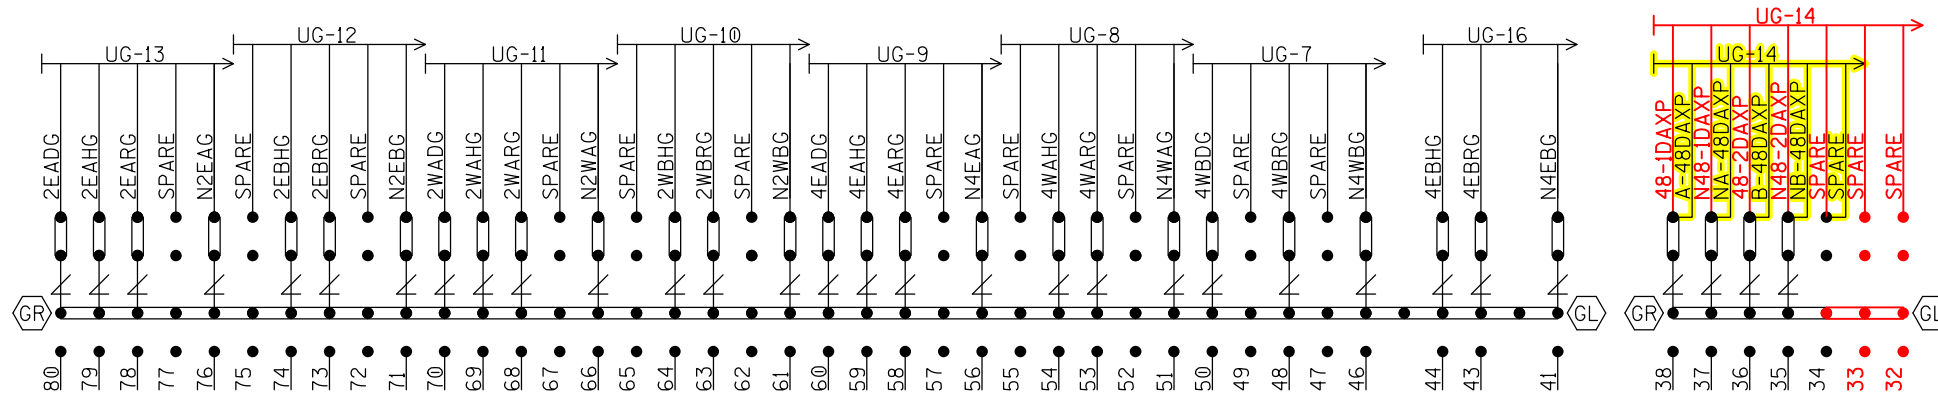




NOTE: INSTALL TEST LINKS ON ALL TRACK
WIRES AND ON ALL LOW VOLTAGE
UNDERGROUND CABLE TERMINATIONS.

SEE FARADAY SHIELD DETAILS - 1A & 1B
FOR HOW THIS PORTION OF THE FARADAY
SHIELD IS PREDRILLED. ONLY INSTALL AND
USE THE TERMINALS NEEDED.


~~E~~ = Heavy Duty Equalizer
(022700-1X)

Clearview
Lightning Arrester
(022585-1X)

 = LPC-10560-51



 = TERMINALS GROUNDED TO SHIELD.
 4 POST BLOCKS USE EITHER -
 GR - SERMMI PART NO. 61278
 GL - SERMMI PART NO. 61278-1.

BACKBOARD DETAIL - 1A & 1B

DESIGNED BY:	 NORFOLK SOUTHERN	
RJT 03-28-05		
DRAWN BY:	OFFICE OF ASS'T. VICE PRESIDENT	M.P.: B-309.10
SSC 03-28-05	COMM. & SIGNAL, ATLANTA, GA.	
CHECKED BY:	BELLEVUE, OH TO FORT WAYNE, IN	
LAR 03-30-05	AUTOMATIC SIGNALS - 3090/3093 AND 3091/3092	
IN SERVICE:	FOSTORIA DISTRICT	FILE NO. R-1884
MAL 12-04-06	CADD or DWG. No. FSBT30910.22	SHEET NO. 22 of 28

[illegible]

NOTE: IF THE FARADAY SHIELD WOULD EVER NEED TO BE DRILLED IN THE FIELD, PROPER PRECAUTIONS MUST BE TAKEN TO INSURE METAL SHAVINGS DO NOT GET INTO EXISTING TERMINALS/WIRES.

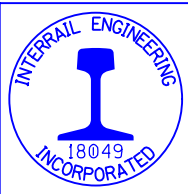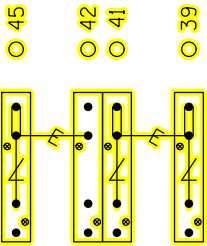


RED = IN
YELLOW = OUT

DATE: 05-09-2018
NS PROJ.#10.3208
IRE/JWB/DBS

AREA BELOW IS SCALED WITH AS=.75

TERMINAL BOARD 1
LEFT HALF

"1B"
"1A"

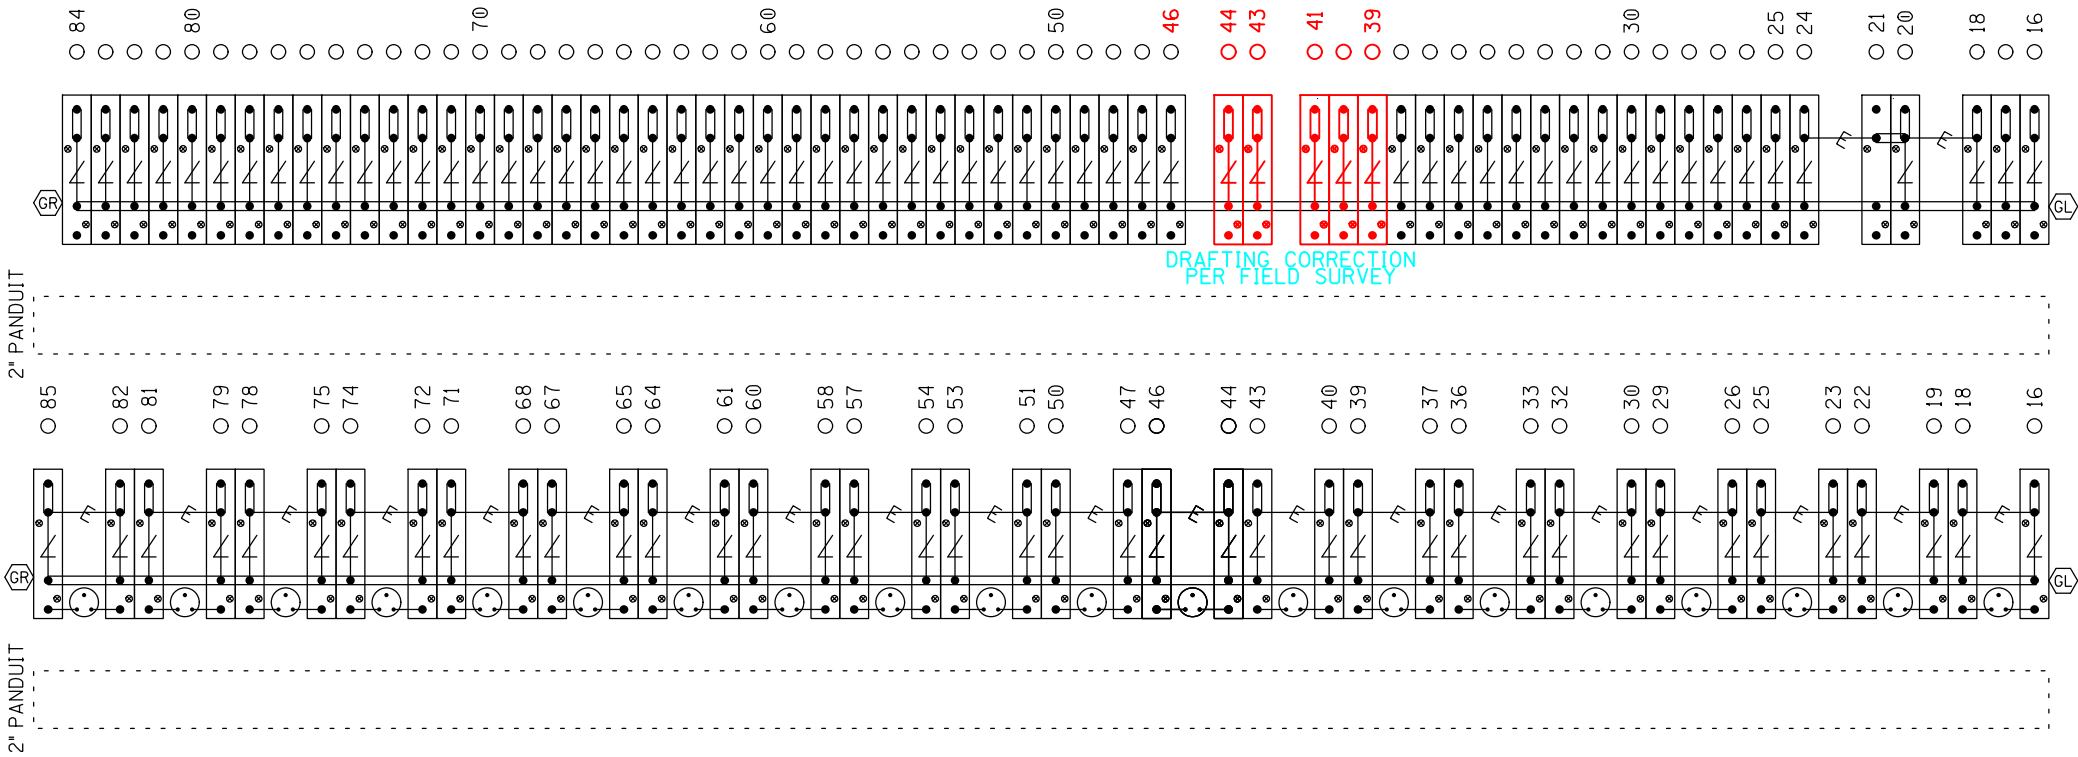

⚡ = Heavy Duty Equalizer
(022700-1X)

Clearview
⚡ = Lightning Arrester
(022585-1X)

⚡ = LPC-10560-51

GR = TERMINALS GROUNDED TO SHIELD.
4 POST BLOCKS USE EITHER -
GR - SERMMI PART NO. 61278
GL - SERMMI PART NO. 61278-1.


TERMINAL BOARD 1
LEFT TWO ROWS
FARADAY SHIELD DETAIL - 1A & 1B

= INDICATES PLACEMENT
OF PANDUIT

THIS SHEET IS FOR REFERENCE ONLY,
TO REFLECT HOW THE FARADAY SHIELD
IS PREDRILLED. ONLY INSTALL AND USE
THE TERMINALS NEEDED.

REVISION	R-3493	PROPERTY	NORFOLK SOUTHERN RAILWAY CO.	DESIGNED BY:	RJT 03-28-05	 NORFOLK SOUTHERN	
INITIALS	NAG/08-18-15 SII/07-25-17			DRAWN BY:	SSC 03-28-05	OFFICE OF ASS'T. VICE PRESIDENT COMM. & SIGNAL, ATLANTA, GA.	M.P.: B-309.10
				CHECKED BY:	LAR 03-30-05	BELLEVUE, OH TO FORT WAYNE, IN AUTOMATIC SIGNALS - 3090/3093 AND 3091/3092	
				IN SERVICE:	MAL 12-04-06	FOSTORIA DISTRICT	FILE NO. R-1884
						CADD or DWG. No. FSBT30910.23	SHEET 23 of 28

NOTE: IF THE FARADAY SHIELD WOULD EVER NEED TO BE DRILLED IN THE FIELD, PROPER PRECAUTIONS MUST BE TAKEN TO INSURE METAL SHAVINGS DO NOT GET INTO EXISTING TERMINALS/WIRES.

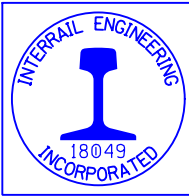


RED = IN
YELLOW = OUT

DATE: 05-09-2018
NS PROJ.#10.3208
IRE/JWB/DBS

AREA BELOW IS SCALED WITH AS=.75

TERMINAL BOARD 1
RIGHT HALF
"1C"

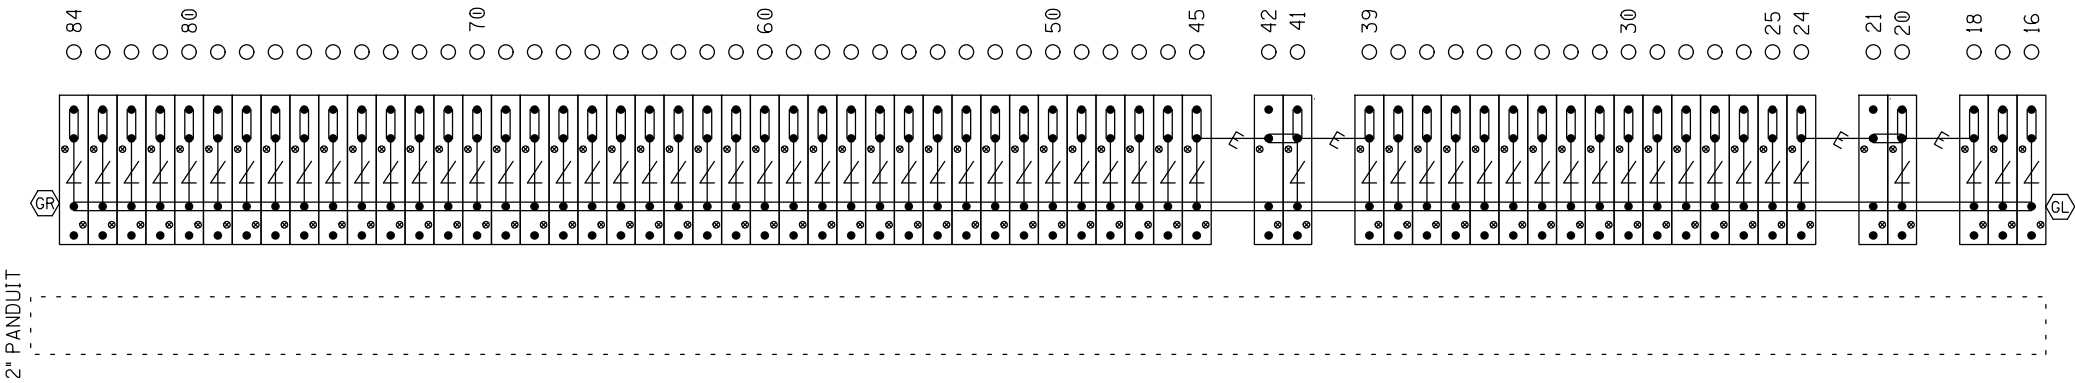

⚡ = Heavy Duty Equalizer
(022700-1X)

∠ = Clearview
Lightning Arrester
(022585-1X)

⊙ = LPC-10560-51



⊙ = GR = TERMINALS GROUNDED TO SHIELD.
⊙ = GL
4 POST BLOCKS USE EITHER -
GR - SERMMI PART NO. 61278
GL - SERMMI PART NO. 61278-1.

TERMINAL BOARD 1
RIGHT ROW
FARADAY SHIELD DETAIL - 1C

= INDICATES PLACEMENT
OF PANDUIT

THIS SHEET IS FOR REFERENCE ONLY,
TO REFLECT HOW THE FARADAY SHIELD
IS PREDRILLED. ONLY INSTALL AND USE
THE TERMINALS NEEDED.

REVISION	R-3493	PROPERTY	NORFOLK SOUTHERN RAILWAY CO.	DESIGNED BY:	RJT 03-28-05	 NORFOLK SOUTHERN	
INITIALS	NAG/08-18-15 SII/07-25-17			DRAWN BY:	SSC 03-28-05		
				CHECKED BY:	LAR 03-30-05	OFFICE OF ASS'T. VICE PRESIDENT COMM. & SIGNAL, ATLANTA, GA.	
				IN SERVICE:	MAL 12-04-06	BELLEVUE, OH TO FORT WAYNE, IN AUTOMATIC SIGNALS - 3090/3093 AND 3091/3092	
						FOSTORIA DISTRICT	FILE No. R-1884
						CADD or DWG. No. FSBT30910.24	SHEET 24 of 28

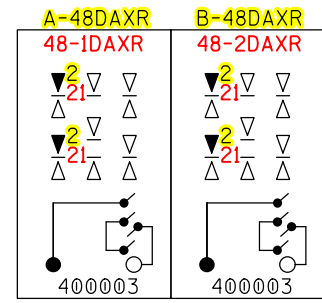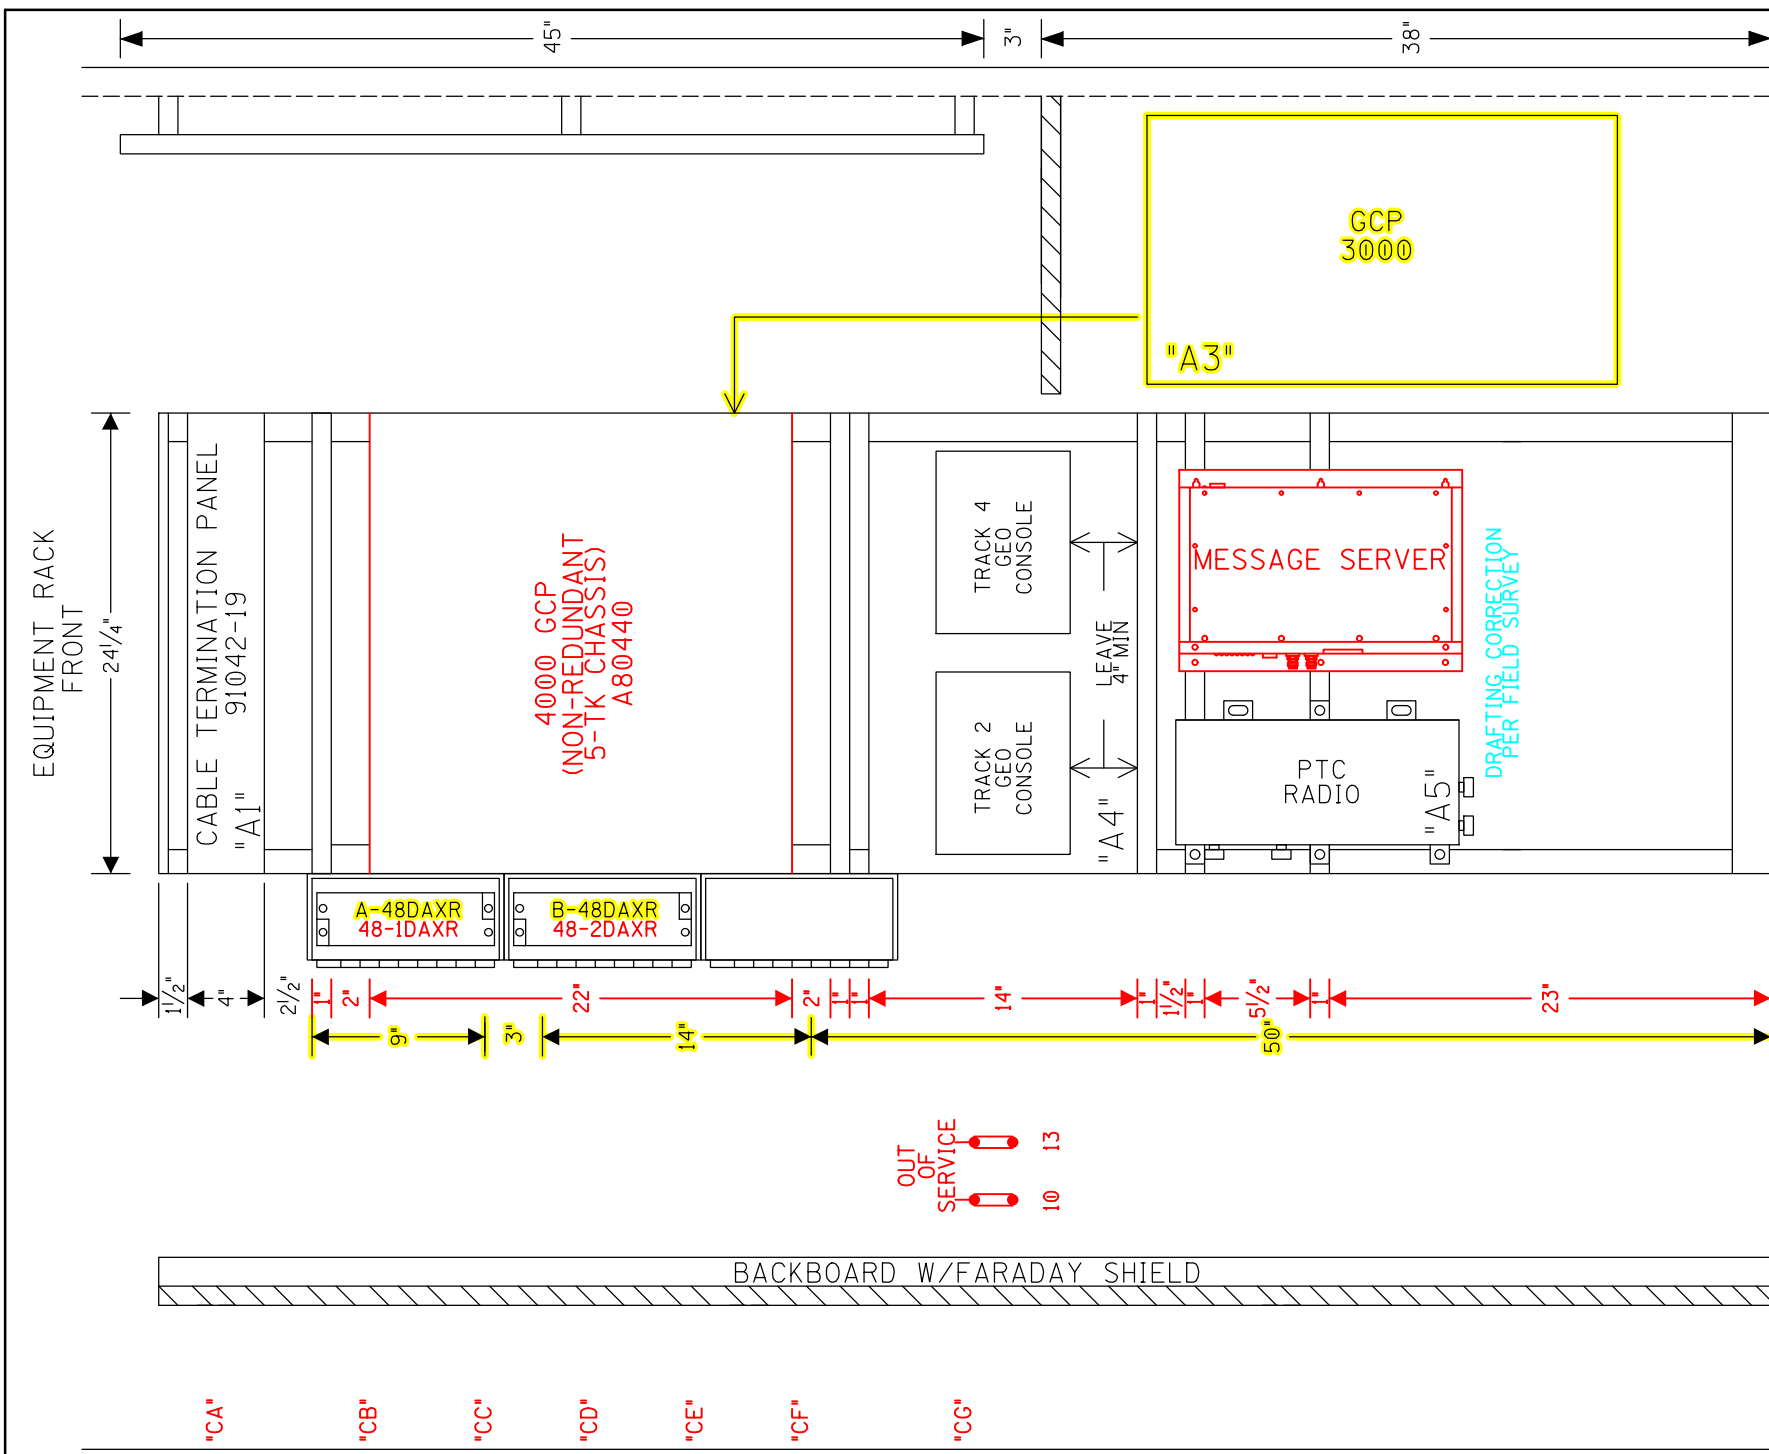



SAFETRAK, ALSTOM (GRS)
RELAY CROSS REFERENCE LIST
SAFETRAK ALSTOM (GRS)
400003 — A62-308

RED = IN
YELLOW = OUT
DATE: 05-09-2018
NS PROJ.#10.3208
IRE/JWB/DBS


SIDE "C"



RACK PLACEMENT
6' X 6' HOUSE - SIDE "C"

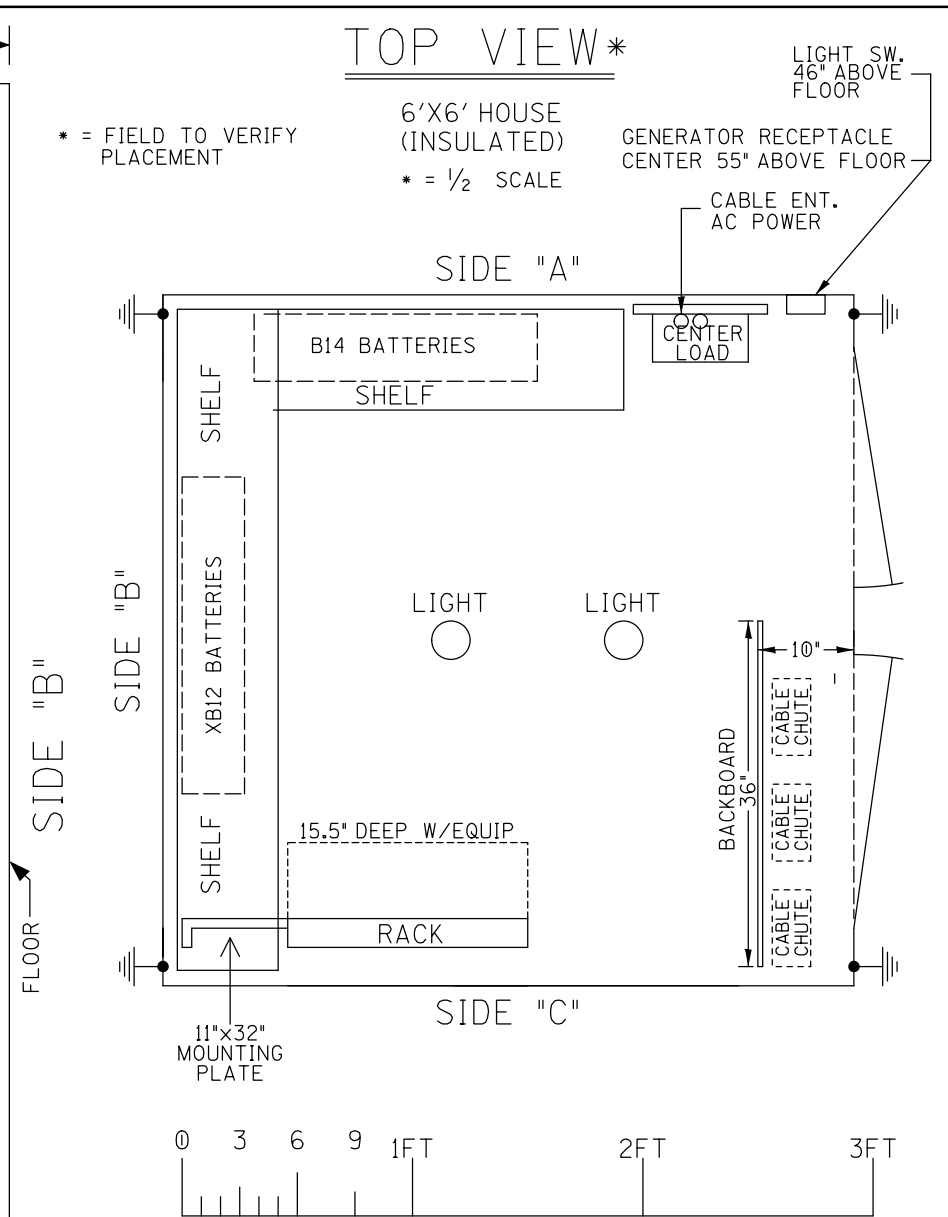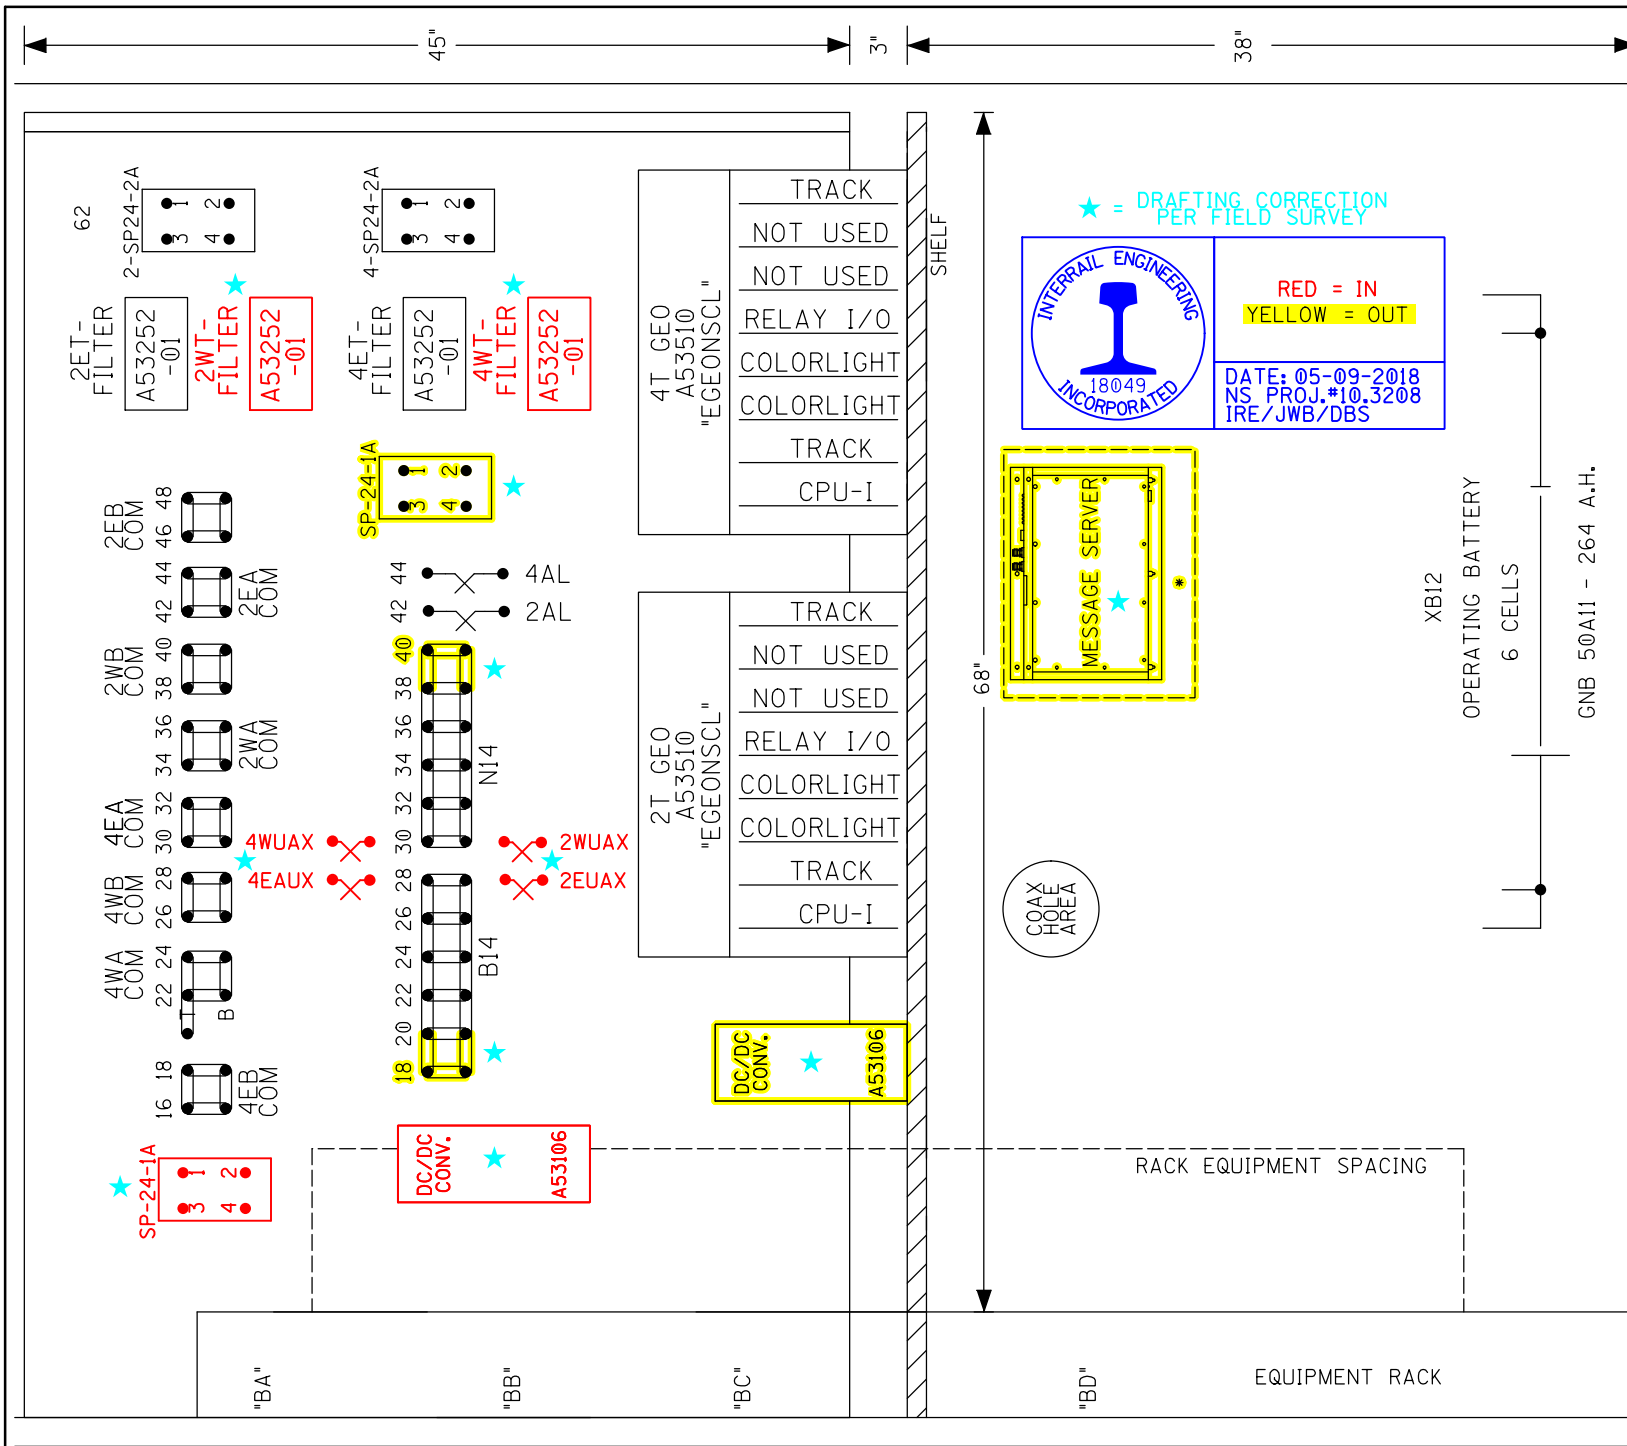


REVISION INITIALS	R-3493 NAG/08-18-15 SII/07-25-17	PROPERTY NORFOLK SOUTHERN RAILWAY CO.	DESIGNED BY: RJT 03-28-05	NS NORFOLK SOUTHERN
			DRAWN BY: SSC 03-28-05	OFFICE OF ASS'T. VICE PRESIDENT COMM. & SIGNAL, ATLANTA, GA.
			CHECKED BY: LAR 03-30-05	M.P.: B-309.10
			IN SERVICE: MAL 12-04-06	BELLEVUE, OH TO FORT WAYNE, IN AUTOMATIC SIGNALS - 3090/3093 AND 3091/3092
				FOSTORIA DISTRICT
				FILE NO. R-1884
				CADD or DWG. No. FSBT30910.27
				SHEET 27 of 28

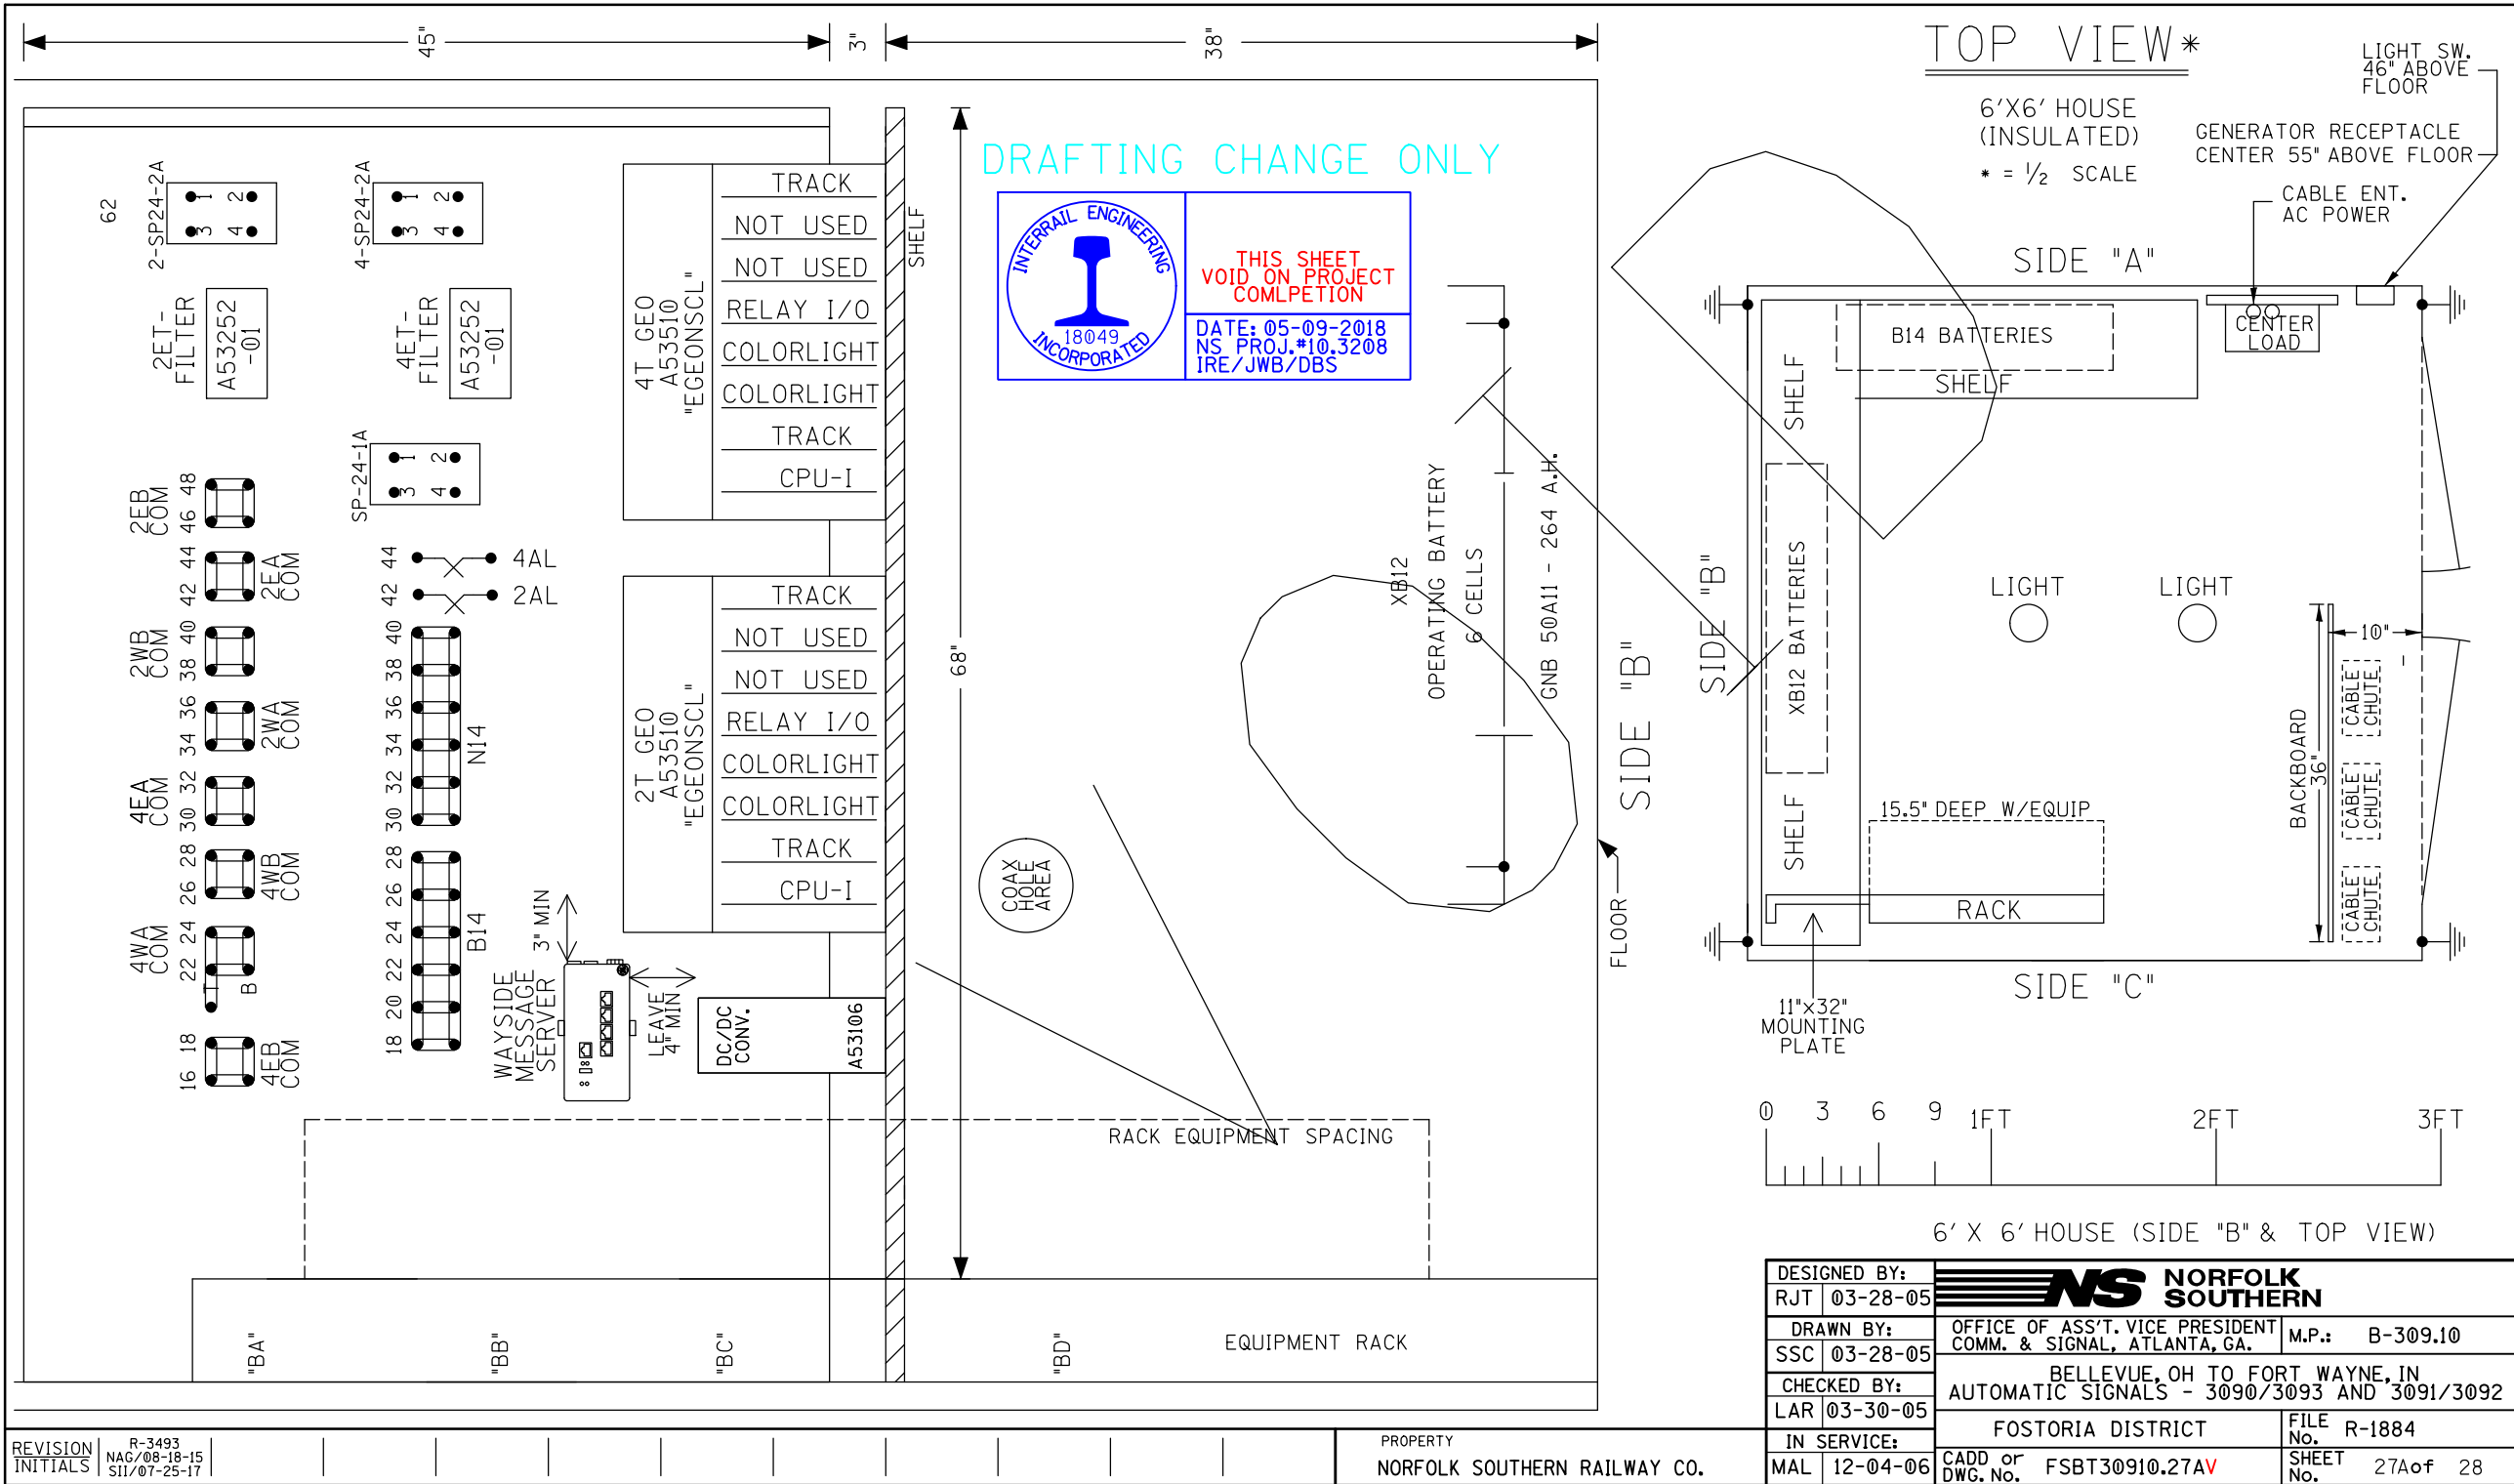


TO FT. WAYNE
(R.R. WEST)
M.P. INCREASING
TO FT. WAYNE

TO BELLEVUE
(R.R. EAST)
M.P. DECREASING
TO BELLEVUE

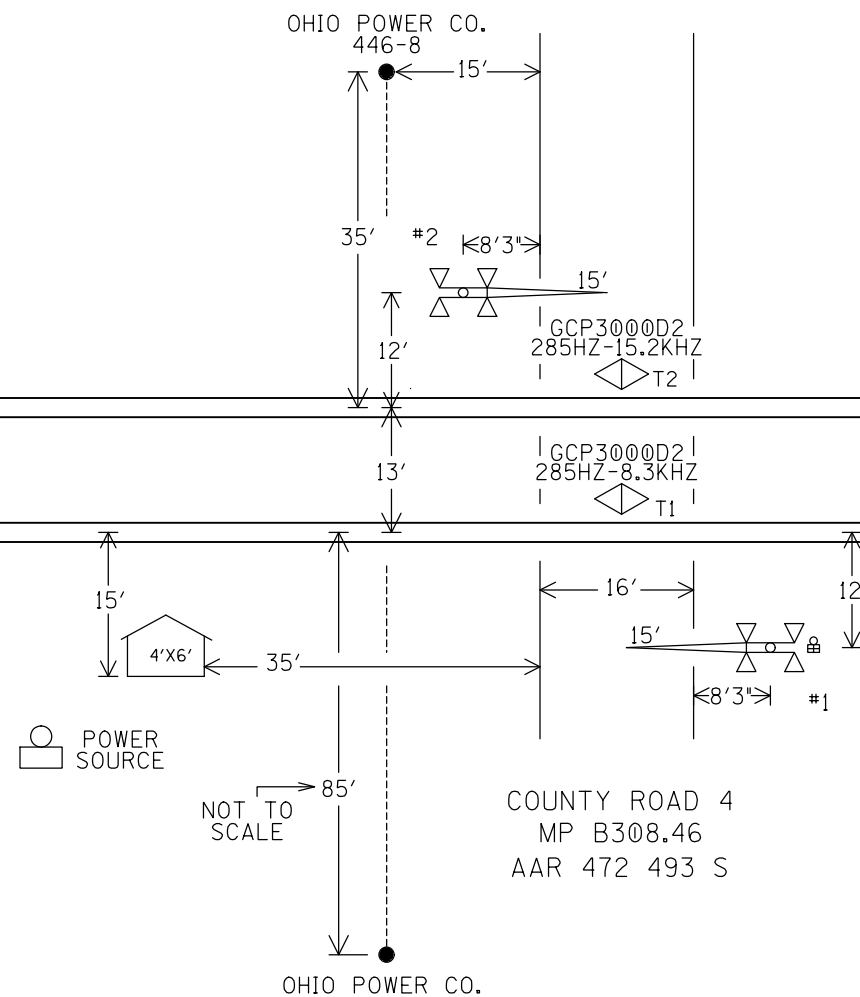

CHANGES TO SHEETS
1 & 2 ONLY

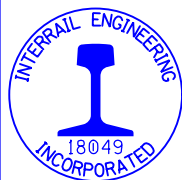


RED = IN
YELLOW = OUT

DATE: 05-09-2018
NS PROJ.#10.3208
IRE/JWB/DBS

IN SERVICE _____ SIGNED _____ DATE _____

☐ S&E ENGINEERING COPY
☐ CONSTRUCTION OFFICE COPY
RETURN TO S&E ENG. AFTER COMPLETION
☐ FIELD COPY
RETURN TO CASE AFTER COMPLETION
☐ PROJECT ENGINEER COPY

NOTES:
1. MAX. TRAIN SPEED 60 M.P.H.
2. CROSSING LOCATED IN PUTNAM COUNTY

PROJECT 10.0203		R-9727	
DESIGNED BY:			
MEI	05-15-93		
DRAWN BY:		OFFICE OF ASS'T. VICE PRESIDENT COMM. & SIGNAL, ATLANTA, GA.	M.P.: B308.46
MEI	05-15-93		
CHECKED BY:		YELLOW CREEK, OH. GATES/FLS. AT CO. RD. 4	
	- -		
IN SERVICE:		FOSTORIA DISTRICT	FILE: 06I-10.32I
JF	06-01-95	CADD or DWG. No. FSBT30846.01	SHEET No. 1 of 14

REVISION	AS INSTALLED	SWS	EGC	5/13/98	R-1884
INITIALS	07-15-96 RSD	01-17-97	SWS	8/11/98	10-09-06 SSC/MAL

PROPERTY
NORFOLK & WESTERN R.WY.CO.

SCALE: 1"=20'

TO FT. WAYNE
(R.R. WEST)
M.P. INCREASING
TO FT. WAYNE

ALL DISTANCES TO EDGE OF ROAD

TO BELLEVUE
(R.R. EAST)
M.P. DECREASING
TO BELLEVUE




2628'
CR-4
APPROACH (TO
EDGE OF ROAD)

2628'
CR-4
APPROACH (TO
EDGE OF ROAD)


APP
C.R. 5

APP
CR 5

APP
C.R. 3

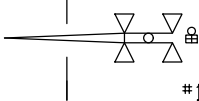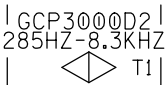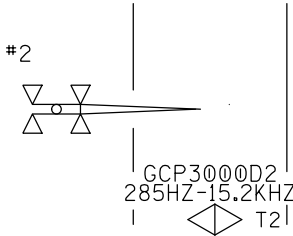

COUNTY ROAD 4
MP B308.46
AAR 472 493 S

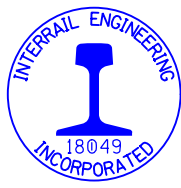

RED = IN
YELLOW = OUT


DATE: 05-09-2018
NS PROJ.#10.3208
IRE/JWB/DBS


XXXX'

- (A) - MF-NBS 62775-1543 (285 HZ)
(B) - MF-NBS 62775-1543 (430HZ) (B) - NBS 62775-1543 (430 HZ)
(C) - MF-NBS 62775-1543 (348 HZ)


REVISION	AS INSTALLED	SWS	EGC	10-09-06	R-1884
INITIALS	07-15-96	01-17-97	5/13/98	10-09-06	SSC/MAL
	RSD		8/11/98		


PROPERTY
NORFOLK & WESTERN R.WY. CO.

PROJECT 10.0203		
DESIGNED BY:	 NORFOLK SOUTHERN	
MEI 05-15-93		
DRAWN BY:	OFFICE OF ASS'T. VICE PRESIDENT COMM. & SIGNAL, ATLANTA, GA.	
MEI 05-15-93		
CHECKED BY:	YELLOW CREEK, OH. GATES/FLS. AT CO. RD. 4	
- -		
IN SERVICE:	FOSTORIA DISTRICT	FILE: 06I-10.32I
JF 06-01-95	CADD or DWG. No. FSBT30846.02	SHEET No. 2 of 14



120 MIN.

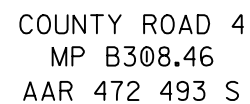

DESIGNED BY:			
MEI	05-15-93		
DRAWN BY:		OFFICE OF ASS'T. VICE PRESIDENT	M.P.: B308.46
MEI	05-15-93	COMM. & SIGNAL, ATLANTA, GA.	
CHECKED BY:		YELLOW CREEK, OH.	
	- -	GATES/FLS. AT CO. RD. 4	
IN SERVICE:		FOSTORIA DISTRICT	FILE: 06I-10.32I
JF	06-01-95	CADD OF DWG. No. FSBT30846.03	SHEET No. 3 of 14


[illegible]

MODEL 3000D2 GCP MODULE ASSEMBLIES																						
UPPER BAY											LOWER BAY											
MODULES POSITION	M1	M2	M3	M4	M5	M6	M7	M8	M9	M10	M11	M12	M13	M14	M15	M16	M17	M18	M19	M20	M21	
MODULE NUMBERS	80011-f(1)*	80011-f(2)	80012	80012	80013	80014	80015	80016 (1)	80016 (2)	80020	80011-f(1)*	80011-f(2)	80012	80012	80013	80014	80015	80016 (1)	80016 (2)	80020	80028	
MODULES USED	X	X	X	X	X	X				X	X	X	X	X	X	X				X	X	

* = 1ST SLOT AT LEFT END OF BAY

EXPANDED PROGRAMMING PARAMETERS		
PROGRAM		ENTER
		T1 T2
1	SWITCH TO MS (EZ VALUE)	10 10
2	TRANSFER DELAY MS TO GCP	0 0
3	PRIME PREDICTION OFFSET	0 0
4	PICKUP DELAY PRIME	15
5	COMPENSATION	1000 1000
6	NO OF TRACK WIRES	4 4

PROGRAMMING SYSTEM APPLICATION PARMETERS (F-LEVEL)			
PROGRAM			ENTER
			T1 T2
1	NUMBER OF TRACKS		2
2	FREQUENCY		285 HZ.
3	UNIDIRECTIONAL/BIDIRECTIONAL		BI BI
4	TRANSMIT LEVEL		MED MED
5	PREDICTOR/MOTION SENSOR		PRE PRE
6	WARNING TIME		30 30
7	APPROACH (DISTANCE)		2628' 2628'
8	UAX PICKUP DELAY (0 = OFF)		0
9	UAX2 ENA / PU DLY (0 = OFF)		0
10	ISLAND (DISTANCE)		MIN.120' MIN.120'
11	SLAVING - MASTER OR SLAVE		MASTER
12	PASSWORD DISABLED		DIS
13	RECORDER NOT INSTALLED/INSTALLED		NOT INSTALLED

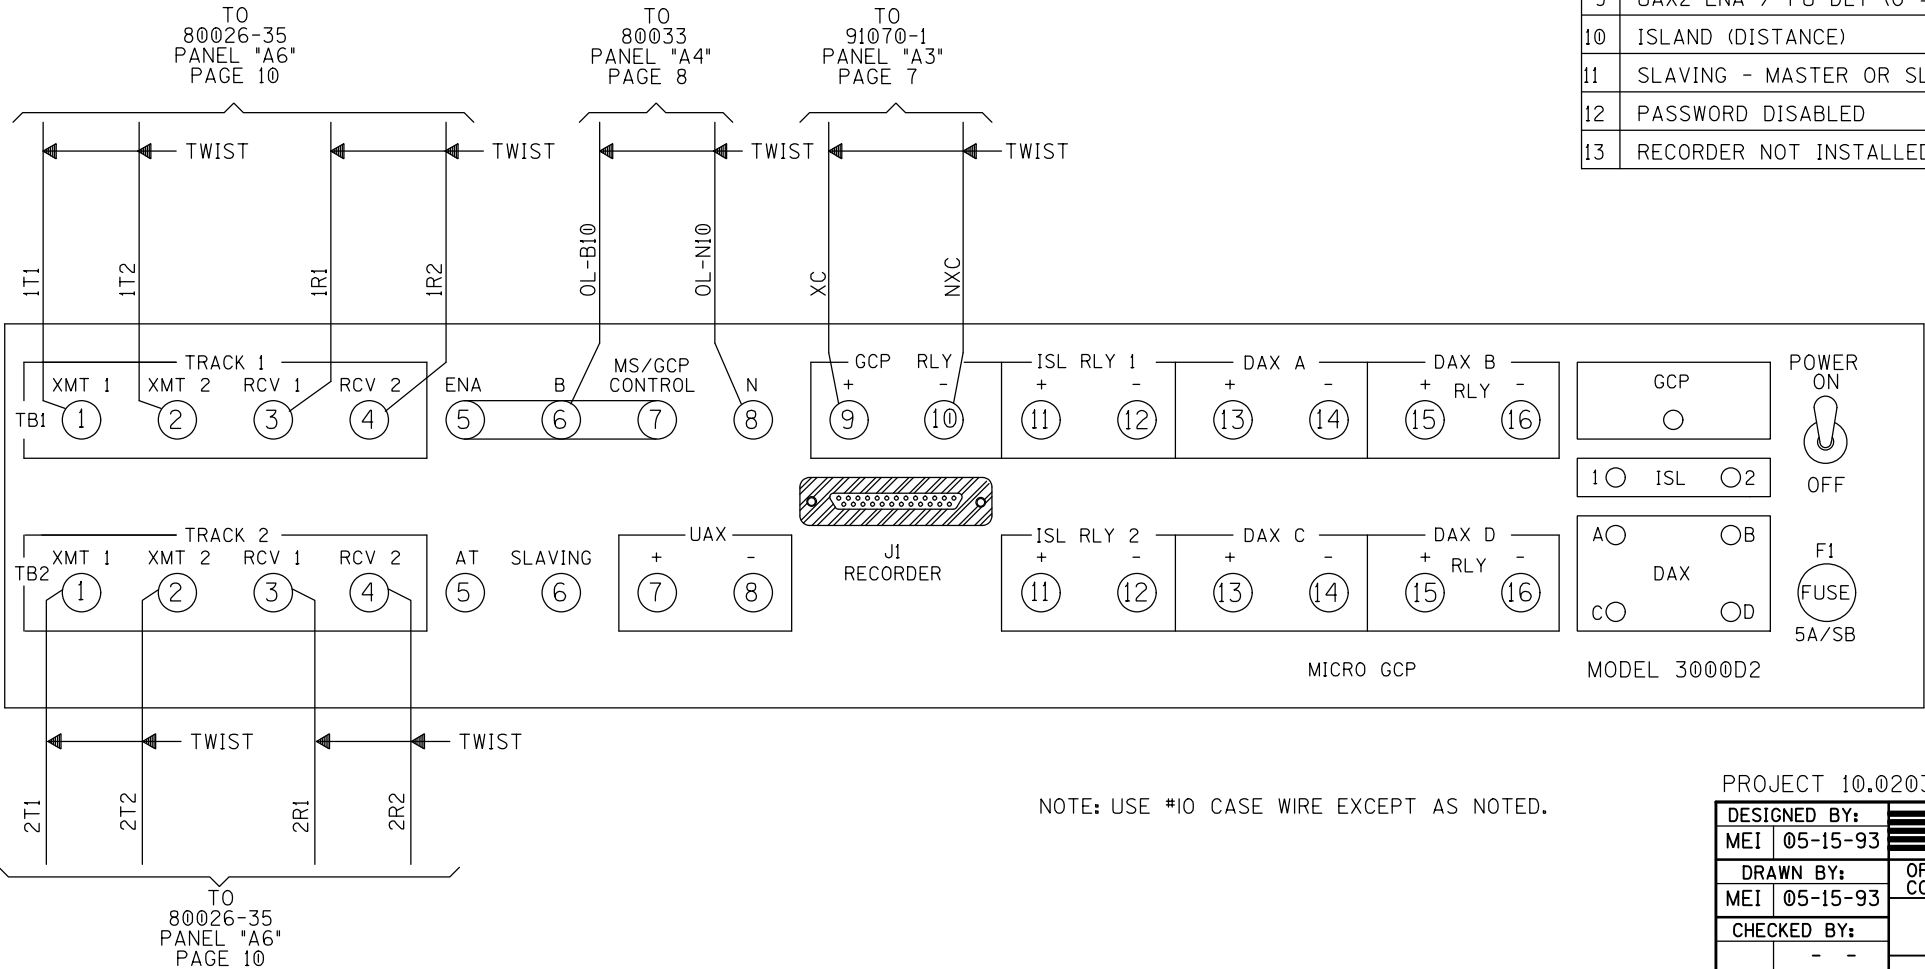


3000D2 GCP
(TRACK 1)
MF = 156 HZ.
IF = 15.2 KHZ
(TRACK 2)
MF = 156 HZ.
IF = 8.3 KHZ

NOTE: USE #10 CASE WIRE EXCEPT AS NOTED.


PROJECT 10.0203

REVISION	AS INSTALLED	SWS	EGC	R-1884
INITIALS	07-15-96	01-17-97	5/13/98	10-09-06
	RSD		SWS	8/11/98
				SSC/MAL

PROPERTY
NORFOLK & WESTERN RY. CO.

DESIGNED BY:	 NORFOLK SOUTHERN	
MEI 05-15-93		
DRAWN BY:	OFFICE OF ASS'T. VICE PRESIDENT	
MEI 05-15-93	COMM. & SIGNAL, ATLANTA, GA.	
CHECKED BY:	YELLOW CREEK, OH.	
	GATES/FLS. AT CO. RD. 4	
IN SERVICE:	FOSTORIA DISTRICT	FILE: 06I-10.32I
JF 06-01-95	CADD or DWG. No. FSBT30846.06	SHEET No. 6 of 14

[illegible]

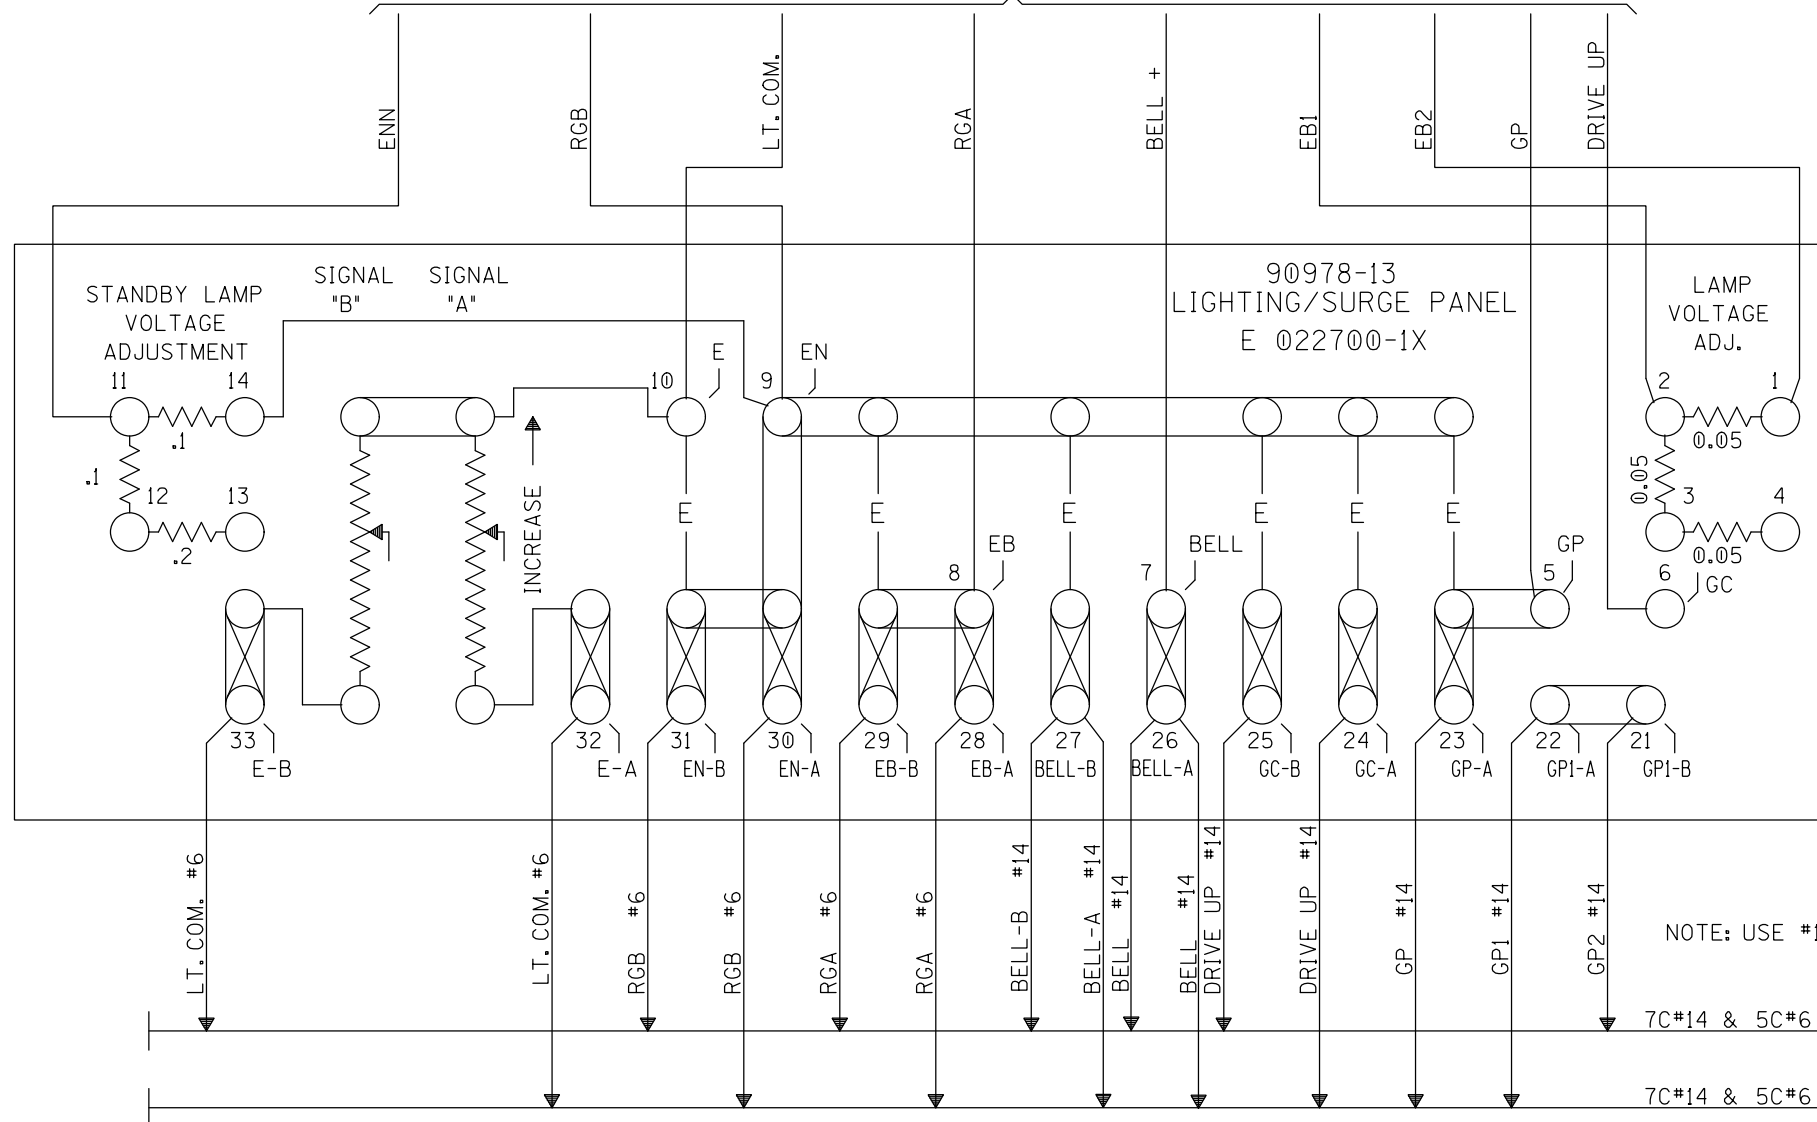


NOTE: USE #10 CASE WIRE EXCEPT AS NOTED.

7C#14 & 5C#6 TO SIG. #2

7C#14 & 5C#6 TO SIG. #1


PROJECT 10.0203

DESIGNED BY:			
MEI	05-15-93		
DRAWN BY:		OFFICE OF ASS'T. VICE PRESIDENT	
MEI	05-15-93	COMM. & SIGNAL, ATLANTA, GA.	M.P.: B308.46
CHECKED BY:		YELLOW CREEK, OH.	
	-	GATES/FLS. AT CO. RD. 4	
IN SERVICE:		FOSTORIA DISTRICT	FILE: 06I-10.32I
JF	06-01-95	CADD or DWG. No. FSBT30846.09	SHEET No. 9 of 14

REVISION	AS INSTALLED	SWS									PROPERTY
INITIALS	07-15-96 RSD	01-17-97									NORFOLK & WESTERN Rwy.CO.



PROPERTY
NORFOLK & WESTERN Rwy. CO.

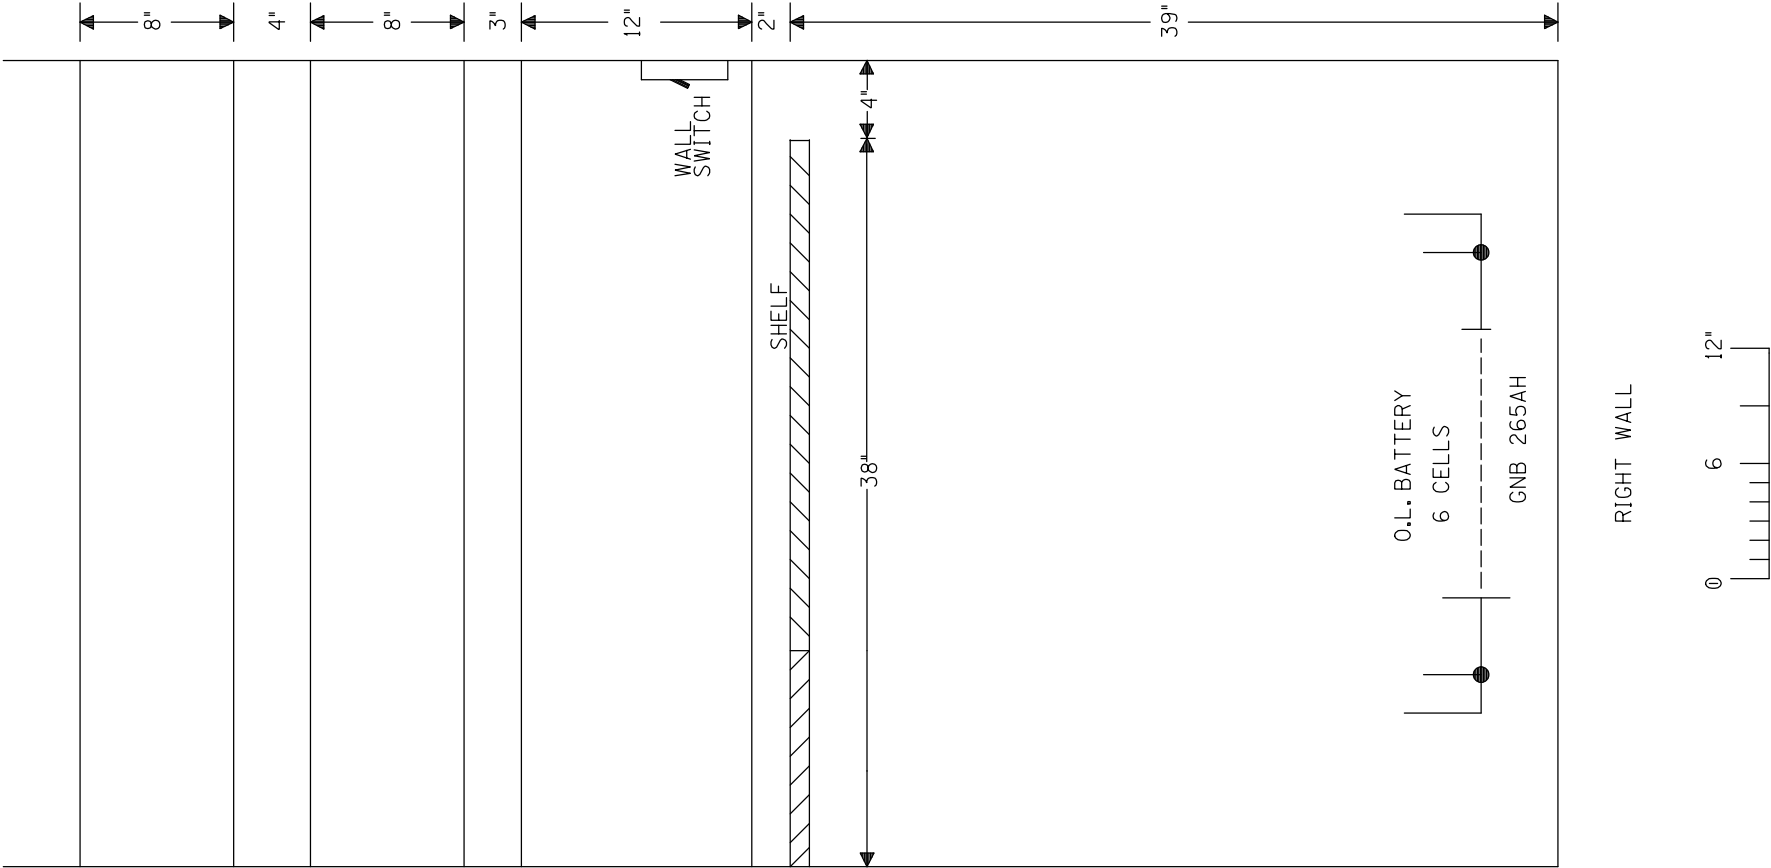

OFFICE OF ASS'T. VICE PRESIDENT
COMM. & SIGNAL, ATLANTA, GA. M.P.: B308.46

YELLOW CREEK, OH.
GATES/FLS. AT CO. RD. 4

FOSTORIA DISTRICT FILE: 06I-10.32I



OHIO RAIL DEVELOPMENT COMMISSION

Mail Stop #3140, 1980 West Broad Street, Columbus OH 43223

John R. Kasich, Governor • James G. Bradley, Chairman

February 27, 2018

Mr. Stephen Klinger
Norfolk Southern Corporation
Administrator Grade Crossing Program
1200 Peachtree St. NE, Box 123
Atlanta, GA 30309

RE: Grade Crossing Warning Device Improvements
Putnam County, CR 5
DOT# 472496M; PID# 106851

Dear Mr. Klinger:

A diagnostic review was held at the above grade crossing on 8/10/2017. As a result of the Diagnostic, the existing active warning device system (lights and gates) will be upgraded to include a new cantilever in the southeast quadrant for north-bound vehicular traffic along with other upgrades to the installation as needed.

Norfolk Southern Corporation is authorized to proceed with the site plans and cost estimates (PE) for this project. This authorization is made with the stipulation and understanding that any field work needs prior approval before work begins. This authorization is made with the stipulation and understanding that an approved estimate may contain entries for items or activities that may be cited and found to be ineligible for federal participation during the project audit.

The ORDC is not requesting that the PUCO issue an Order at this time. When the ORDC receives the PE it will be evaluated and a construction-only Order will be requested from PUCO. Please submit the PE to ORDC within 90 days of receipt of this letter.

The diagnostic review form is attached. Please note any recommendations (page 5), if any, made by the team with regard to requirements for this location. Any minor roadway work necessary for MUTCD compliance should be incorporated into the PE and such costs will flow through the railroad reimbursement process

The ORDC Project Manager for this project is Don Damron. Don can be reached at 614-466-2509 (office), or 614-917-8466 (cell), or don.damron@dot.state.oh.us, if you have any questions.

Sincerely,

Donald J. Damron
Project Manager

C: Randall Schumacher, Rail Division Chief, PUCO
Jill Henry, Rail Specialist, PUCO
ORDC (file)

Attachments: Diagnostic Review Team Survey dated 8/10/2017
PUCO/ORDC/NS Letter Agreement dated 1/17/2017



www.rail.ohio.gov

phone: 614.644.0306

IMPROVING RAIL TODAY FOR TOMORROW'S ECONOMY



OHIO RAIL DEVELOPMENT COMMISSION

Mail Stop #3140, 1980 West Broad Street, Columbus OH 43223

John R. Kasich, Governor • Mark Policinski, ORDC Chairman

January 17, 2018

Norfolk Southern Railway Company
Mr. Stephen Klinger
Administrator Highway Grade Crossing Improvements
1200 Peachtree Street
Atlanta, GA 30309-3597

RECEIVED
ORDC
2018 FEB 12 PM 1:16

Subject: Grade Crossing Warning Device Improvements, PID 106851
Putnam County, CR 5, DOT# 472496M

Dear Mr. Klinger:

A diagnostic review was conducted at the subject grade crossings on 8/10/2017. As a result of the review, the warning devices will receive equipment upgrades as needed and a cantilever at the crossing.

This project shall be completed in compliance with Agreement No. 17450, dated December 19, 2012, entered into by the State of Ohio and Norfolk Southern Railway Company (NS) and incorporated as if fully rewritten herein. This construction shall also meet the general terms and conditions under the Fixing America's Surface Transportation Act and subsequent amendments and the State of Ohio's Federally Funded Warning Device Program.

Preliminary engineering (PE) and construction costs shall be borne one hundred percent (100%) by ORDC. Reimbursable costs will be limited by the ORDC based on approved estimates and bid tabulations, if applicable. These limits will be quantified by the ORDC in its construction authorization to NS and may be amended by the ORDC based on revised estimates and bid tabulations.

This Letter Agreement and the approved plans constitute the scope of the project. NS shall notify ORDC in writing of any changes in the scope of work which are not in the approved plans and estimates and secure approval in writing of same before the work is performed.

PE will not be commenced by NS prior to ORDC issuing a PE authorization. PE will be submitted by NS to ORDC within ninety (90) days or other time specified by ORDC in the PE authorization. Construction will not be commenced by NS prior to ORDC issuing a construction authorization. Construction will be completed by NS within nine (9) months or other time specified in the time specified by ORDC in the construction authorization.

Please indicate your acceptance of the terms and conditions of this Letter Agreement by signing and returning one (1) copy to me at the address listed above and retain a copy for your files. This Agreement may be executed in one or more counterparts, each of which shall be deemed to be a duplicate original, but all of which taken together shall be deemed to constitute a single Agreement.

Sincerely,

Matthew R. Dietrich
Executive Director



www.rail.ohio.gov

phone: 614.644.0306

IMPROVING RAIL TODAY FOR TOMORROW'S ECONOMY

Norfolk Southern:


By: Gregory R. Comstock

Title: General Manager

Date: 1/22/18

PUT CR 5 PID 106851 472496M

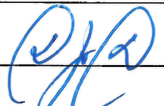

High Hazard Crossing With Active Warning Devices			
Street Name: CR 5		County: PUT	
LHA: Putnam County		USDOT#: 472496M	
Nearest City: Leipsic		Hazard Rank: 49	
Roadway Information			
ADT: 2527 (2015)		Posted Speed Limit:	
Railroad: Norfolk Southern		Number of Tracks: 3	
Train Count: 26		Speed Over Crossing: 60	
Storage Distance (Ft.): Not Listed		Train Detection Type: CD/AFO	
Accidents			
Accident Factors		2 # of Accidents in Last 5 Years:	
		1 # of Fatalities in Last 5 Years:	
Accident Date	2/14/15	5/29/13	
Position of Accident	Moving over the crossing.	Moving over the crossing.	
Circumstance			
Visibility/Time of Day	Dark	Day	
Weather Conditions	Clear	Snow	
Crossing Interconnect.	No	No	
Crossing Illuminated	No	No	
Drove Around Train	No	No	
Highway User Action	Stopped on crossing	Went thru Gate.	
Alcohol/Drug Related?			
Driver Speeding?			
Other Notes: 2/24/15: Train was struck by hwy-user at crossing. 5/29/13: Train traveling westbound on main 2 when northbound hwy user failed to stop and skid into the path of the train.			
Recommendations:			
<ul style="list-style-type: none"> • ADD SINGLE CANTILEVER TO S. SIDE (NORTH-BOUND TRAFFIC) • UPDATE EQUIPMENT ON AS NEEDED BASIS. 			
 MLL LH TB			

Existing Traffic Control Devices

Type of Warning Devices	Installed?		Quantity/Comments
Advance Warning Signs (condition?)	<input checked="" type="radio"/> Yes	<input type="radio"/> No	
'Stop' Signs	<input type="radio"/> Yes	<input checked="" type="radio"/> No	
'Stop Ahead' Signs	<input type="radio"/> Yes	<input type="radio"/> No	
Pavement Markings (condition?)	<input type="radio"/> Yes	<input checked="" type="radio"/> No	
Crossbucks	<input checked="" type="radio"/> Yes	<input type="radio"/> No	
Number of Tracks Signs	<input checked="" type="radio"/> Yes	<input type="radio"/> No	
Inventory Tags	<input checked="" type="radio"/> Yes	<input type="radio"/> No	
Interconnected Highway Traffic Signal	<input type="radio"/> Yes	<input checked="" type="radio"/> No	
Mast-Mounted Flashing Lights	<input checked="" type="radio"/> Yes	<input type="radio"/> No	
Cantilever Flashing Lights	<input type="radio"/> Yes	<input checked="" type="radio"/> No	Number: Length:
Side Lights	<input type="radio"/> Yes	<input checked="" type="radio"/> No	
Automatic Gates	<input type="radio"/> Yes	<input checked="" type="radio"/> No	Number: Length:
Bells	<input checked="" type="radio"/> Yes	<input type="radio"/> No	Number: 1 BELL
Sidewalk Gate Arms	<input type="radio"/> Yes	<input checked="" type="radio"/> No	
'No Turn' Signs	<input type="radio"/> Yes	<input checked="" type="radio"/> No	
Illumination	<input type="radio"/> Yes	<input checked="" type="radio"/> No	
Is crossing flagged by train crew?	<input type="radio"/> Yes	<input type="radio"/> No	
Other	<input type="radio"/> Yes	<input type="radio"/> No	

Railroad Data

Railroad Characteristics	Initial Information (from database)	Revised
Total trains per day	26	OK
< 1 per day		
Day thru trains	12	MAY VARY
Night thru trains	12	
Daytime switching movements	1	
Nighttime switching movements	1	
Total number of tracks	3	
Number of main tracks	2	
Number of other tracks	1 Siding	
Maximum train speed	60 / 40 - MAIN #TWO	
Typical train speed	60 40-45 MPH TRACK	NEITHER 40/60 MPH IS TYPICAL
Amtrak		

If multiple tracks, can two trains occupy crossing at the same time? ☒ Yes ☐ NoCan one train block the motorists' view of another train at crossing? ☒ Yes (Explain below) ☐ NoCan one or more tracks be eliminated through the crossing? ☒ Yes ☐ NoAre there other track(s) crossing this same roadway within 100 ft of this crossing? ☐ Yes ☒ No

If yes, Crossing DOT #(if different) _____

If yes, distance _____ (take measurement between track centerlines at closest point along roadway)

County: PUT Route: CR 5

DOT#:472496M

Date: 8/10/2017

Roadway Data

Local Highway Authority: Putnam County

Roadway Characteristics	Initial Information (from database)	Revised
Average daily traffic 2527	TIMS (2015)	OK (40% TRUCK)
Highway paved	Yes <input checked="" type="checkbox"/> No	Yes No
Roadway Surface: <u>Blacktop</u> Gravel Concrete Other _____	HIGHEST TRAFFIC ROAD IN COUNTY	
Roadway width: <u>24</u> ft.	26 FT WIDE PAVEMENT	
Number of highway lanes	2	OK
Urban or Rural	Local	OK
Vehicle Speed: <u>55</u> MPH		
School Bus Operation: No <input checked="" type="checkbox"/> Yes Amount <u>4</u>	UNKNOWN	
Hazardous Materials Trucks: No <input checked="" type="checkbox"/> Yes Amount <u>.04%</u>		
Shoulders: No <input checked="" type="checkbox"/> Yes <u>(2-3 FT.)</u>		
Is the shoulder surfaced? No <input checked="" type="checkbox"/> Yes		
Is there existing guardrail along roadway in crossing vicinity? No <input checked="" type="checkbox"/> Yes		
Is stopping site distance adequate? (See Table 2) Yes <input checked="" type="checkbox"/> No If no, deficient approach(es) _____		
Quadrant _____ Curb and Gutter: Functional (Curb height = 4" or more) Non-functional (Curb height = Less than 4") <u>None</u>	Quadrant _____ Curb and Gutter: Functional (Curb height = 4" or more) Non-functional (Curb height = Less than 4") <u>None</u>	
Pedestrians: No <input checked="" type="checkbox"/> Yes		
Is sidewalk present? No <input checked="" type="checkbox"/> Yes		
Is there a nearby intersection that could cause queuing over the crossing? No <input checked="" type="checkbox"/> Yes If yes, Street Name _____ Distance _____ Is this intersection signalized? No Yes Are the signals currently interconnected with the existing crossing warning devices? No Yes Is there a 'Do not Stop on Track' sign? No Yes		
Is a roadway improvement project (e.g. widening, turn lanes, nearby new or upgraded traffic signal, sidewalk) planned at or near this location in the foreseeable future? No Yes <u>ROAD WAS RECENTLY WIDENED</u> If yes, Improvement type <u>POSSIBLE CHIP+SEAL</u> Lead Agency <u>COUNTY</u> Timeline/completion <u>SURFACING WITHIN NEXT TWO YEARS</u>		
Is it the consensus of the Diagnostic Review Team that this is a potential closure project? No <input checked="" type="checkbox"/> Yes Explain reasons: <u>MAJOR ARTERIAL ROAD SERVES DEVELOPING INDUSTRY.</u>		

Type of Development

<input checked="" type="checkbox"/> Open Space Institutional <input type="checkbox"/> Industrial Commercial <input type="checkbox"/> Residential	Location of nearby schools:
--	-----------------------------

Potential Red Flags / Project Challenges

Traffic Signal Preemption (include traffic signal intersection name and LHA with jurisdiction over traffic signal, if known):

NA

Crossing Consolidation or Closure:

NA

Real Estate or ROW:

NA

Culverts / Drainage / Ballast Conditions:

NA

Roadway and/or Sidewalks:

NA

Circuitry (e.g. reaches out to other crossings, specific needs, etc.): SUPERVISOR SUGGESTED:


- SSEC3
- NEW CHARGERS
- NEW BATTERIES
- RECORDER NEEDED
- NO FEAR
- SOLID STATE NEEDED

Environmental:

NA

Other:

Field Sketch

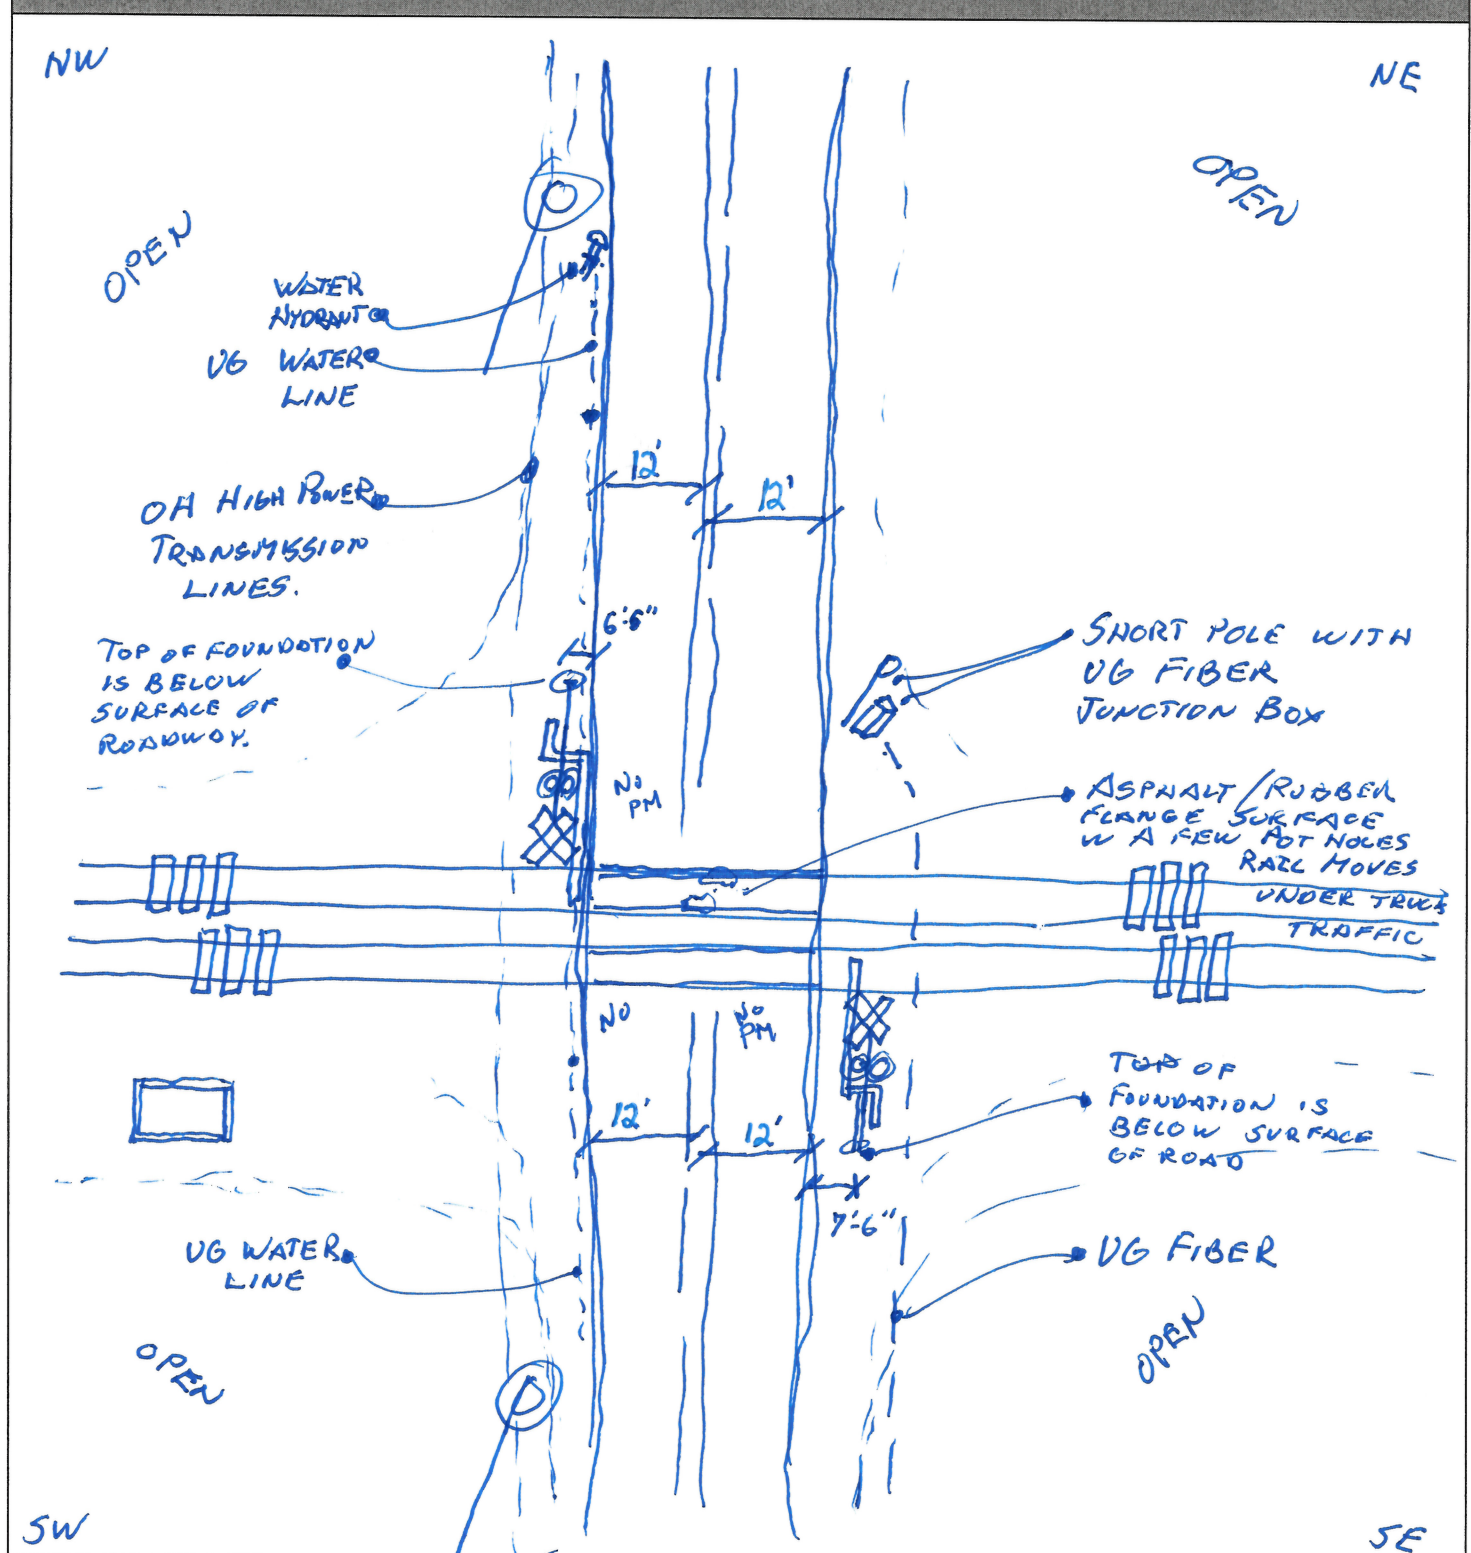

Crossing Angle ☐ 0-29° ☐ 30-59° ☒ 60-90° Measured in SW Quadrant?

Sketch by: JTO

BUFFALO II
"B LINE"
FOOTING DIV.

Clearing Sight Distances

Maximum Authorized Train Speed	Distance (dT) Along Railroad from Crossing (ft)
1 - 10	240
15	360
20	480
25	600
30	720
35	840
40	960
45	1080
50	1200
55	1320
60	1440
65	1560
70	1680
75	1800
80	1920
85	2040
90	2160

Source: R-H Grade Crossing Handbook Table 36 (pp. 132-133)

Notes:

All calculated distances are rounded up to the next higher 5-foot increment.

Distances indicated are for 65-ft double bottom semi-tractor trailers and level single track 90 degree crossings; and may need to be adjusted for multiple tracks, skewed crossings or approaches on grades.

Clearing Sight Distance is to be measured in each vehicle travel direction at non-gated crossings as viewed from a point 25 feet from centerline of nearest track in the center of whichever travel lane is nearest the direction along track being measured.

Stopping Sight Distances

Highway Vehicle Speed	Distance (dH) Along Roadway from Crossing (ft)
0	n/a
5	50
10	70
15	105
20	135
25	180
30	225
35	280
40	340
45	410
50	490
55	570
60	660
65	760
70	865

Source: R-H Grade Crossing Handbook Table 36 (pp. 132-133)

Notes:

All calculated distances are rounded up to the next higher 5-foot increment.

Distances indicated are for 65-ft double bottom semi-tractor trailers on dry level pavements.

Stopping Sight Distance is to be measured on each roadway approach to crossing from stop bar.

Diagnostic Review

(PUT CR 5 DOT # 472496M)

8/10/2017

Please print:

[illegible]

This foregoing document was electronically filed with the Public Utilities

Commission of Ohio Docketing Information System on

8/23/2018 4:17:30 PM

in

Case No(s). 18-1310-RR-FED

Summary: Application In the Matter of a Request for the Installation of New Active Warning Devices at the Norfolk Southern Railway Crossing, CR 5 DOT# 472-496M, in Putnam County, Ohio. electronically filed by Mrs. Jill A Henry on behalf of PUCO/Rail Division