

Memo

To: Docketing Division
From: Jill Henry, Rail Specialist, Rail Division
Cc: PUCO Legal Department
Date: 10/29/18

Re: PUCO Case No. 18-1616-RR-FED- In the Matter of a Request for Upgrades to the Active Warning Devices at the Norfolk Southern Railway Crossing, Union Avenue DOT#503-013S, in Stark County, Ohio.

On February 22, 2018, the Ohio Rail Development Commission (ORDC) authorized funding for Norfolk Southern Railway to upgrade the active warning devices at Union Avenue DOT#503-013S, in Stark County, Ohio. The crossing was surveyed, on August 11, 2017, and found to warrant the upgrades. The electric utility provider for this crossing is First Energy Corp.-Ohio Edison.

The project will be paid for with federal funds and is actual cost. The plans and estimates in the amount of \$183,949.00 have been approved. Construction may commence at once. **Staff requests a Finding & Order with completion of the project in twelve months.** Staff requests that the following language be incorporated in the Finding & Order:

It is expected that all work necessary for FHWA acceptance of the warning devices will be completed by the in-service due date and that the railroad will be responsible for this work. This work includes, but is not limited to:

- Any ancillary work to make the warning devices function as designed and visible to the roadway user, and
- MUTCD compliance, including minor roadway work if necessary.

Please serve the following parties of record:

Norfolk Southern Railway Company
Kurt Young
Public Projects Engineer
1200 Peachtree Street NE
Box 123
Atlanta, GA 30309-3597

Norfolk Southern Railway Company
Cayela Wimberly
Director Grade Crossing Safety
1200 Peachtree Street NE
Atlanta, GA 30309-3597

Eastman & Smith LTD.
Mr. Casey Talbott
Attorney for Norfolk Southern
One SeaGate 24th Floor
P.O. Box 10032
Toledo, OH 43699-0032

Ohio Rail Development Commission
Cathy Stout
Safety Manager
1980 West Broad Street
Mail Stop #3140
Columbus, OH 43223

City of Alliance
Curtis Bungard
City Engineer
504 E Main Street
Alliance, OH 44601

First Energy Corp.-Ohio Edison

**OHIO RAIL DEVELOPMENT COMMISSION
INTER-OFFICE COMMUNICATION**

TO: Randall Schumacher, Supervisor, Rail Division, PUCO
FROM: Cathy Stout, Manager, Safety Section, ORDC
BY: James Tucker, Project Manager, ORDC J.T.
SUBJECT: Stark County, SR 225/Union Ave, Norfolk Southern
DOT#503013S, PID#106855
DATE: August 27, 2018

The Ohio Rail Development Commission (ORDC) established a diagnostic survey at the subject location on August 11, 2017. The Diagnostic Team recommended that the crossing receive LED and equipment upgrades. Copies of the diagnostic review form and the plan and estimate are attached.

PE has already been provided by the railroad. ORDC approves the site plans and estimates as provided. Please issue a construction-only order for the project outlined above for twelve months. This construction authorization is made with the stipulation and understanding that any field work needs prior approval before work begins. This authorization is made with the stipulation and understanding that an approved estimate may contain entries for items or activities that may be cited and found to be ineligible for federal participation during the project audit.

It is expected that all work necessary for FHWA acceptance of the warning devices will be completed by the in-service due date and that the railroad will be responsible for this work. This work includes, but is not limited to:

- Any ancillary work to make warning devices function as designed and visible to the roadway user, and
- MUTCD compliance – including minor roadway work if necessary.

Thank you for your assistance with these matters.

Attachment: Diagnostic Review
Plan & Estimate

c: Jill Henry, PUCO
Susan Arduni, ORDC
ORDC Project Manager (file)



OHIO RAIL DEVELOPMENT COMMISSION

Mail Stop #3140, 1980 West Broad Street, Columbus OH 43223

John R. Kasich, Governor • Mark Policinski, ORDC Chairman

August 27, 2018

Mr. Kurt Young
Public Projects Engineer
1200 Peach Street NE, Box 123
Atlanta, Ga. 30309

RE: Stark County, SR225/Union Ave, DOT #503013S
PID#106855, NS Project 10.3210

Dear Mr. Young:

The plan dated August 1, 2018 and estimate dated August 6, 2018, for the referenced project has been reviewed and is acceptable. **Please note that the railroad must provide ORDC with a plan stamped by a professional engineer licensed in the State of Ohio prior to acceptance and close out of the project.** Norfolk Southern (NS) may proceed with the construction of the proposed LED and equipment upgrades in accordance with the abbreviated plan. This authorization is made with the stipulation and understanding that the approved estimate may contain entries for items or activities that may be cited and found to be ineligible for federal participation during the project audit. Reimbursement of eligible actual cost from ORDC is limited to \$183,949.00. Additional costs must be approved in writing by the Ohio Rail Development Commission (ORDC) prior to being incurred. Emergency verbal authorizations by ORDC may be permitted and will be confirmed by ORDC in writing within ten (10) business days of the verbal approval.

This authorization is contingent upon NS accepting the following instructions:

1. NS's project foreman will furnish written notification five (5) working days prior to the date work will start at the project site to James Tucker, ORDC, email james.tucker@dot.ohio.gov and to the Public Utilities Commission of Ohio at jill.henry@puco.ohio.gov NS's project foreman will also notify the same of any stops and re-starts of the work activity and of the date work was completed for the project.
2. NS will arrange for utilities to be located at the project site by the Ohio Utilities Protection Service (OUPS) prior to any construction activities at the site. Utilities that are not participating members of the service must be contacted directly by NS.
3. NS's project foremen will notify James Tucker at 614-398-6897 (telephone) or james.tucker@dot.ohio.gov (email) of any changes in the scope of work, cost overruns, material changes, etc. which are not included in the approved plan and estimate and secure approval of same before the work is performed.
4. Open cut of roadways is not permitted except in unusual circumstances and must be coordinated with the local highway authority and preapproved by ORDC.



www.rail.ohio.gov


phone: 614.644.0306

IMPROVING RAIL TODAY FOR TOMORROW'S ECONOMY

5. NS will furnish two (2) copies of each partial bill to ORDC. Please find the enclosed ODOT Purchase Order to reference when billing.
6. NS will furnish two (2) copies of the final all-inclusive bill to ORDC stating the exact dates of starting and completing work, the initial and final dates of construction and location where the accounts may be audited.
7. This installation will include any ancillary work to make the warning devices function as designed and meet MUTCD.

Thank you for your assistance with these matters.

Sincerely,

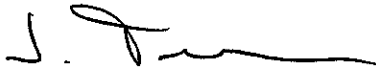A handwritten signature in black ink, appearing to read 'J. Tucker', with a long horizontal flourish extending to the right.

James Tucker
Project Manager

C: Randall Schumacher, Rail Division Supervisor, PUCO
Jill Henry, Grade Crossing Planner, PUCO
Susan Arduini, ORDC
ORDC (file)

**Round Figure Estimate for Grade Crossing Warning Devices**

City/State: ALLIANCE, OH

Road: UNION AVE

MilePost: RD-67.73

DOT/AAR: 503013S

State Proj. No.: PID 106855

County: STARK

S&E Proj. No.: 10.3210

File Number:

Man Days: 120

Purchases - Others		
Meals and Lodging:	\$16,414.27	
Rental of Equipment:	\$22,438.25	
(2 Trucks, 1 Backhoe w/ Trailer and 1 Pipe-Pusher for 20 Days)		
Construction Supervision Vehicle:	\$3,432.30	
Purchases - Other Total:		\$42,284.82
Material And Additives		
Material Cost:	\$42,596.00	
Sales and Use Tax:	\$3,408.00	
Material Handling Freight:	\$4,259.56	
Material Total:		\$50,263.56
Labor And Additives		
Labor Cost:	\$38,640.00	
(6 man crew at \$1,932.00 a day for: 20 days)		
Payroll Tax & Overheads:	\$32,944.46	
Preliminary Engineering:	\$8,529.73	
Construction Supervision:	\$11,286.74	
Labor Total:		\$91,400.93
Project Cost:		\$183,949.31
Scrap / Salvage Credit:		\$0.00
Project Total:		\$183,949.00

Estimated on: 06-Aug-18

Estimated by: ndney

Estimate valid for 1 year from date of estimate



Highway Crossing Signalization Program - Material List

Do not substitute items without permission from S & E Engineering

City:	ALLIANCE
Road:	UNION AVE
Mile Post:	RD-67.73
Drawing Number:	24120677
State ProjectNumber:	PID 106855
County:	STARK
A A R Number:	503013S
Project Number:	10.3210
File Number:	
New File Number:	CX0156410
WBS:	F-05076
Store Number:	
Supervisor:	UNKNOWN
Tax Code:	
Vendor to supply the following copies after pricing: 1 Set - Material Management with original Invoice 2 Sets - with plans shipped in car with material 1 Set - S&E Gen. Supt. Construction w/copy of invoice	

Qty.	Class-Item-CD	UI	Price per Item	Total Price	Item Description	Quantity Shipped	Quantity Installed			Quantity Returned (Credit)	Special Instructions
2	670-503047-4	EA	\$183.15	\$366.30	BELL, CROSSING ELECTRONIC GENERL SIGNAL, EB-3-360-5 CR 02-044350		Date Quan.	Date Quan.	Date Quan.		
4	670-980689-4	EA	\$75.48	\$301.92	BRACKET HIGH WIND, (RIGID 3'), WIG- 191036, WALRUS TUSK TYPE						
500	465-939422-4	LF	\$2.92	\$1,460.00	CABLE, UG 12 CONDUCTOR NO 14 AWG SOLID EACH CONDUCTOR WITH 5/64 IN INSULATION 10 MIL						
800	465-292862-4	LF	\$1.49	\$1,192.00	CABLE, UG 2-6 TWISTED, S-23 OKONITE 113-12-3933 SOLID TINNED CONDUCTOR						
200	465-277674-4	FT	\$3.58	\$716.00	CABLE, UG 3CD NUMBER 6 FOR HIGH CURRENT AC POWER OKONITE 206-11-6 243						
500	465-292929-4	LF	\$4.12	\$2,060.00	CABLE, UG 5 COND. NO. 6 AWG SOLID COPPER CABLE TO MEET NS CORP. SPEC. FOR SIGNAL						
1	670-070249-4	EA	\$3,625.00	\$3,625.00	CANTILEVER, WT/F ARM 24' W/WALKWAY KIT SAFTRAN #071294-24NS2						
12	670-664917-4	EA	\$87.64	\$1,051.68	CONNECTOR KIT, WELDED FAR RAIL, CONSISTING OF RUBBER HOSE PROPERLY DRILLED, BONDSTRAND, 1 SPLICING SLEEVE, 1 REDUCING SLEEVE, 3 CLAMPS, 1 TRACK CLIP, 1 WEB WELDED TRACK CONNECTOR, 1 WELD METAL, SAFETRAIN 111359-2X						
12	670-632520-4	EA	\$79.69	\$956.28	CONNECTOR KIT, WELDED NEAR RAIL, CONSISTING OF, RUBBER HOSE PROPERLY DRILLED, BONDSTRAND, SPLICING SLEEVE, 1 REDUCING SLEEVE, 5 CLAMPS, 1 TRACK CLIP, 1 WEB WELDED TRACK CONNECTOR, 1 WELD METAL, SAFETRAIN 111359-1X						
2	670-794453-4	EA	\$1,253.03	\$2,506.06	COUNTERWEIGHT PKAGE, 25-31'GATE S'TAN S- MECH ONLY, STAINLESS TO INCLUDE HUB, SUPPORT ARMS						
2	670-005378-4	EA	\$387.95	\$775.90	GATE ARM, ALUMINUM, 25-31 FT, ARM ASSEMBLY, INCLUDES GATE GUARD FOR GATE LIGHT CABLE. HIGH INTENSITY VERTICAL STRIPES.						
2	670-092155-4	EA	\$160.00	\$320.00	LAMP ASSY, LED GATE ARM KIT (INCLUDES 3 LAMPS COMPLETE WITH CABLES AND MTG. HARDWARE) REC #: 9298- 1120						
1	670-005054-4	EA	\$921.25	\$921.25	LAMP ASSY, LED, 12" MAST 1 WAY FRONT LIGHTS (IPN: 042003- L489XNS)						
2	670-005057-4	EA	\$952.05	\$1,904.10	LAMP ASSY, LED, 4" CANT JURY ARM MAST (FRONT OR BACK) (IPN: 042003-L001534)						

APPROVED BY STATE	APPROVED BY RAILROAD	CAR NUMBER	SEAL NUMBER
-------------------	----------------------	------------	-------------

Qty.	Class-Item-CD	UI	Price per Item	Total Price	Item Description	Quantity Shipped	Quantity Installed			Quantity Returned (Credit)	Special Instructions
Date	Quan.	Date	Quan.	Date	Quan.						
2	670-005063-4	EA	\$952.05	\$1,904.10	LAMP ASSY, LED, 4" MAST 1 WAY LIGHTS (IPN: 042003-L484XNS)						
1	670-005066-4	EA	\$959.37	\$959.37	LAMP ASSY, LED, 5" MAST 1 WAY BACK LIGHTS (IPN: 042003-L001493)						
1	670-005058-4	EA	\$1,786.08	\$1,786.08	LAMP ASSY, LED, 5" MAST BACK TO BACK LIGHTS (IPN: 042003-L487XNS)						
1	670-201210-4	EA	\$5,686.00	\$5,686.00	MAST, 12" CANTILEVER, FOR 21'-30' WT/F ARMS, INCL. LADDER KIT (IPN: 071271-30NS)						
1	670-146525-4	EA	\$1,599.00	\$1,599.00	MAST, 5" ALUMINUM 22' (0&0) SIDE LIGHT BRACKET HOLE @ 0, W/DBL. JCT. BOX BASE SAFETRAN #070519-X601						
1	670-016194-4	EA	\$2,132.88	\$2,132.88	MAST, 5" ALUMINUM 22' (0&180) FOR SIDE LIGHT BRACKET HOLE AT 180 W/ DBL JCT BOX BASE (P/N 070519-KIT9)						
2	670-000985-4	EA	\$312.09	\$624.18	MAST, SIDELIGHT BRACKET F/5"MT. HARMON @225834-XXX, SAFETRAN 041442-26X,						
2	670-521147-4	EA	\$3,715.27	\$7,430.54	MECHANISM, GATE MODEL S-40, WITH CONTACT HEATER, COMPLETE W/RELAY S'TRAN # 074000-W00090						
2	670-700469-4	EA	\$1,185.41	\$2,370.82	MODULE, MULTI FREQUENCY ISLAND SAFETRAN #80211 FOR 3000GCP						
4	670-001347-4	EA	\$59.67	\$238.68	PACKAGE, HARDWARE SIGN 5 IN. MOUNTING, SERRMI A1250-5, HARMON @200965-000, OR						
1	670-514605-4	EA	\$11.11	\$11.11	PINNACLE, W-C SECT 1-11, 4"& 5" REF K1 110-8 OR SAFETRAN NO. @035045-503X						
2	670-554843-4	EA	\$77.05	\$154.10	SIGN, 2 TRACK SIGN, HIGH INTENSITY, SAFETRAN #035207-2HX						
2	670-016346-4	EA	\$143.23	\$286.46	SIGN, X-BUCK, HI-INTENSIVE REFLECTIVE FRT. & BACK FOR ALL STATES, SAFETRAN# 035200-91X						
2	670-393331-4	EA	\$37.43	\$74.86	SIGN, CROSSING ENS MALFUNCTION ASSEMBLY FOR 4" AND 5" MAST, SAFETRAN #T17215						
20	465-999111-4	LF	\$0.38	\$7.60	WIRE, NO.10, 1 CONDUCTOR, CASE, FLEXIBLE 37 STRAND, 3/64 IN. INSULATION-ORDER EXT.AMT. NEEDED CR 02-620502						

Total Material: \$43,422.27


APPROVED BY STATE	APPROVED BY RAILROAD	CAR NUMBER	SEAL NUMBER
-------------------	----------------------	------------	-------------

SH. NO.	CONTENTS	REVISION NO.						
		1	2	3	4	5	6	7
1	TITLE, NOTES, INDEX AND REVISIONS	✓	✓	✓	✓	✓		
2	LOCATION PLAN	✓	✓	✓		✓		
3	POWER DISTRIBUTION CIRCUITS	✓	✓	✓	✓			
4	POWER DISTRIBUTION AND CABLE CIRCUITS	✓	✓	✓	✓			
5	3000D2 SAFETRAN GRADE CROSSING PREDICTOR CIRCUITS - UNIT 1	✓	✓	✓	✓	✓		
6	3000D2 GCP SET-UP							
6	7 3000D2 SAFETRAN GRADE CROSSING PREDICTOR CIRCUITS - UNIT 2	✓	✓	✓	✓			
	8 3000D2 GCP SET-UP							
7	9 ELECTRO CODE 4 CIRCUITS TRACK 1	✓	✓	✓				
8	10 ELECTRO CODE 4 CIRCUITS TRACK 2	✓	✓	✓				
9	11 LIGHTING CIRCUITS	✓	✓	✓	✓	✓		
10	12 SIGNAL 'A' S40 GATE & FLASHER CIRCUITS GATE CONTROL AND LIGHTING	✓	✓	✓	✓	✓		
	13 SIGNAL 'B' S40 GATE & FLASHER CIRCUITS					✓		
11	14 HOUSE AND RACK LAYOUT	✓	✓	✓	✓	✓		
12	15 WALL LAYOUT		✓	✓	✓	✓		
13	16 TERMINAL BOARD ARRANGEMENT		✓	✓	✓	✓		

RED AND YELLOW CHANGES ARE
PER EXISTING PLANS IN THE
FIELD AND ARE DRAFTING CHANGES ONLY

RED = IN
YELLOW = OUT

DATE: 10-20-2015
NS PROJ.#
NS/WDM

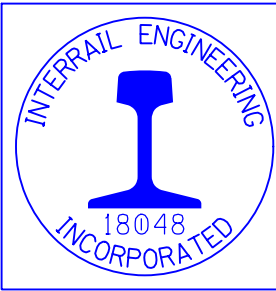GREEN = IN
ORANGE = OUT

DATE: 05-22-2018
NS PROJ.#10.3210
IRE/JWB/DBS

REVISIONS

1	04-03-98			
NEW PLAN DRAWN ACCOUNT INSTALL TCS ON THE CLEVELAND LINE.				
WO/AFE NO: GG917 PFC NO. 3 IN SERVICE: 05-14-01 PER: J.J.BENTZ				
2	09-11-00	SWS	SWS	SWS
REPEATER 67.7 ADDED AT UNION AVENUE ACCOUNT POOR BALLAST CONDITIONS. PLAN CHANGED TO REFLECT INSTALLATION OF 8' X 8' HOUSE.				
WO/AFE NO: 998091 IN SERVICE: 05-14-01 PER: J.J.BENTZ				
3	09-04-13	DAM	XRL	PEH
PLAN REVISED ACCOUNT NEW GCP 4000 INSTALLED AT PARK AVE.				
PROJECT NO: 10.2059 IN SERVICE: 09-05-14 PER: RMM				
4	10-20-15	WDM	NS	
PLAN REVISED ACCOUNT OF INSTALLTION OF S-40 GATE MECHS AND POK CIRCUITS				
PROJ. NO: **,**** IN SERVICE: 10-20-15 PER: WDMC				
5	05-22-18	JWB	IRE	DBS
PLAN REVISED ACCOUNT OF INSTALLION OF NEW WARNING DEVICES AT UNION AVE.				
PROJ. NO: IN SERVICE: PER:				
AAR/DOT #503013S				




PITTSBURGH DIVISION CLEVELAND LINE

ALLIANCE, OHIO
UNION AVENUE / REPEATER 67.7
TITLE, NOTES, INDEX AND REVISIONS

PHILADELPHIA, PA. APPROVED:  PE CAD
CHIEF ENGINEER - C&S

ISSUE DATE: APRIL 3, 1998 2412-0677

REV. 543 09-04-13 SHEET 1

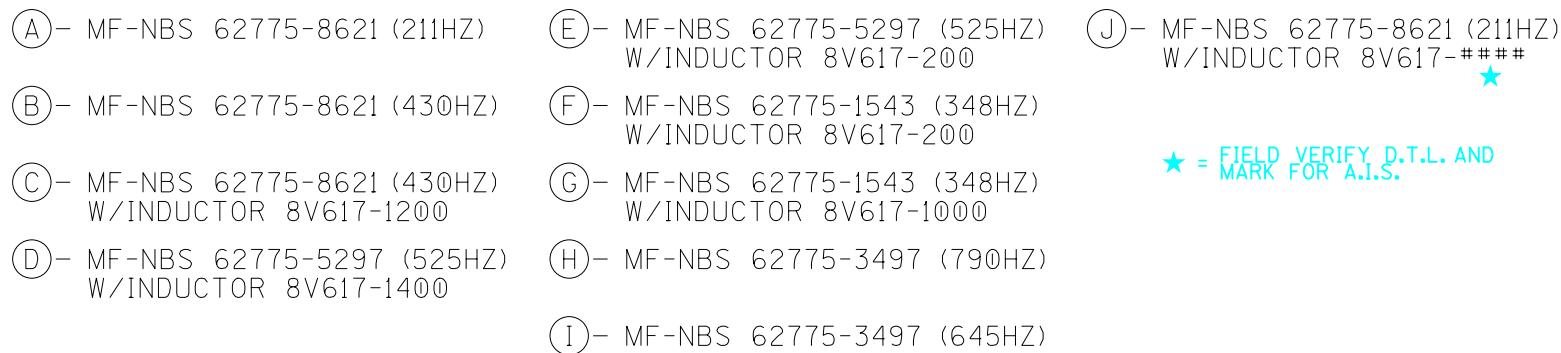


ALL SHUNTS AND DUMMY LOADS HAVE BEEN RELOCATED FROM THE TRACKS AND PLACED INTO ADJACENT BUNGALOWS.

PROFILE




DESIGNED BY:		 NORFOLK SOUTHERN	
JWB	08-01-18		
DRAWN BY:		OFFICE OF ASS'T. VICE PRESIDENT COMM. & SIGNAL, ATLANTA, GA.	M.P.: RD-067.73
IRE	08-01-18	ALLIANCE, OH CFLGS AT UNION AVE.	
CHECKED BY:			
DBS	08-01-18		
IN SERVICE:		CLEVELAND LINE	FILE NO. R-
	- -	CADD or DWG. No. 24120677.02	SHEET NO. 2 of 3

[illegible]

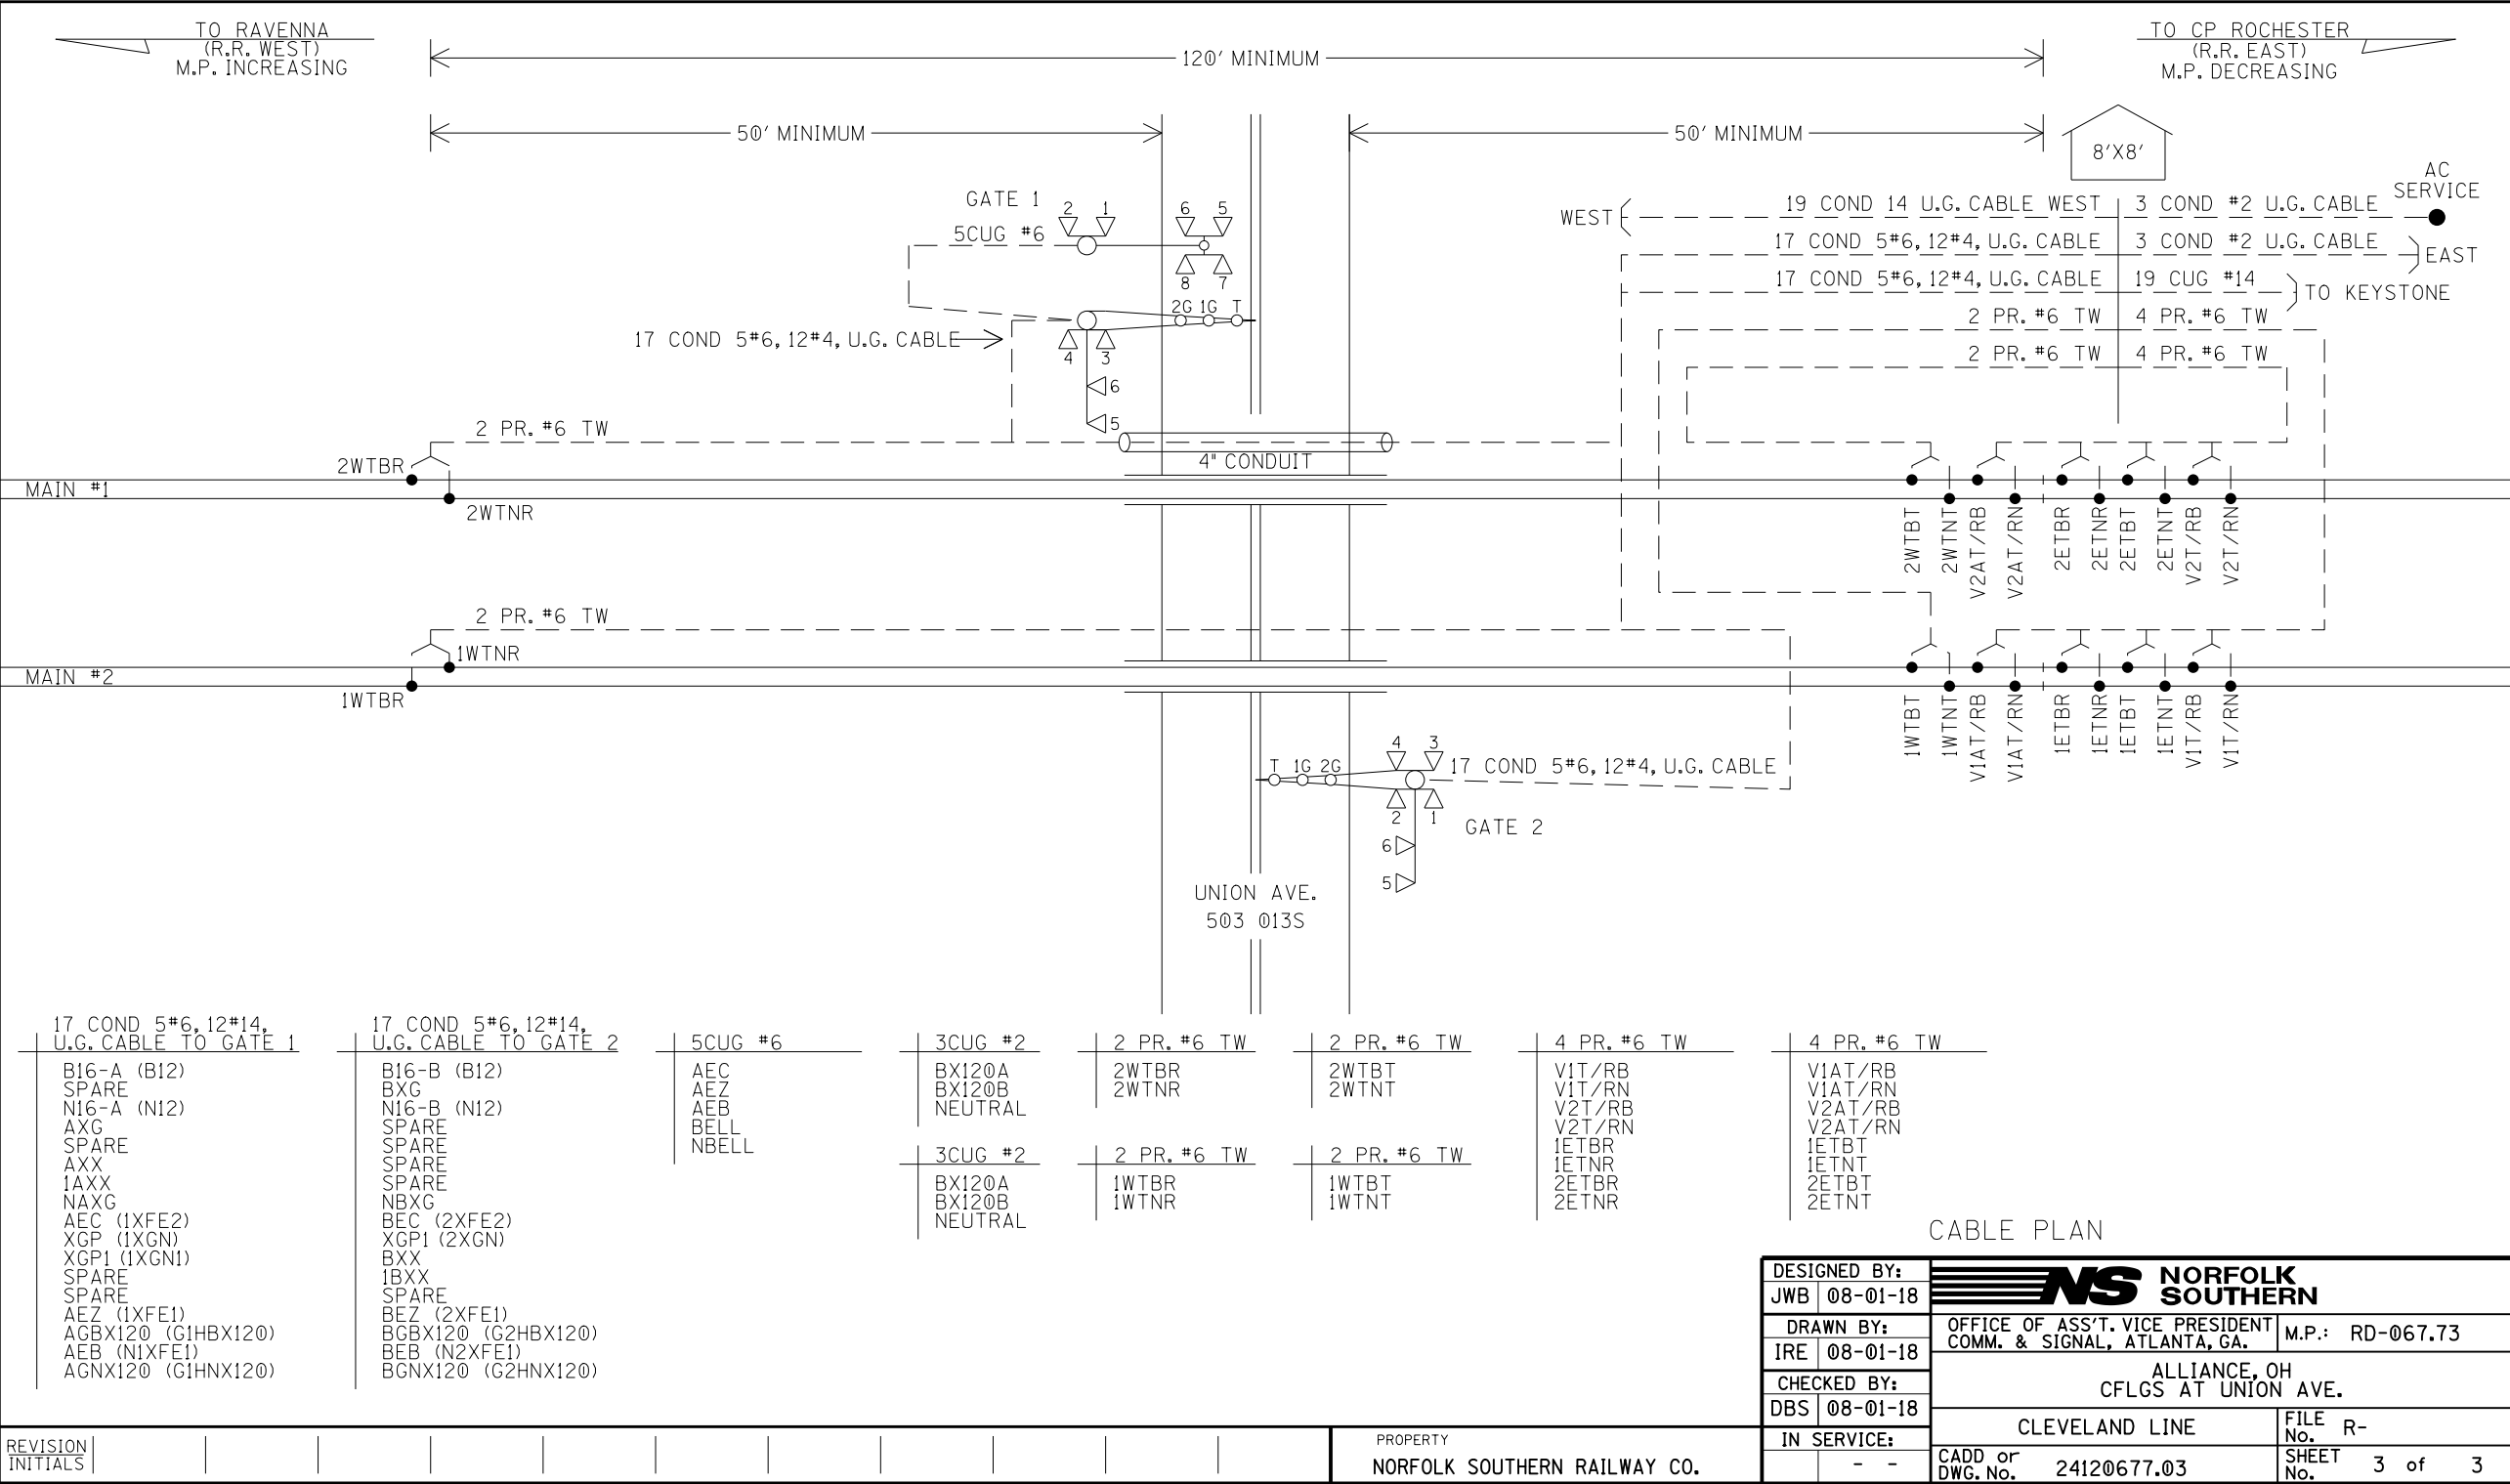

19C-#14
U.G. CABLE
WEST

UG-10 - 19 CUG #14
TO KEYSTONE
24120676

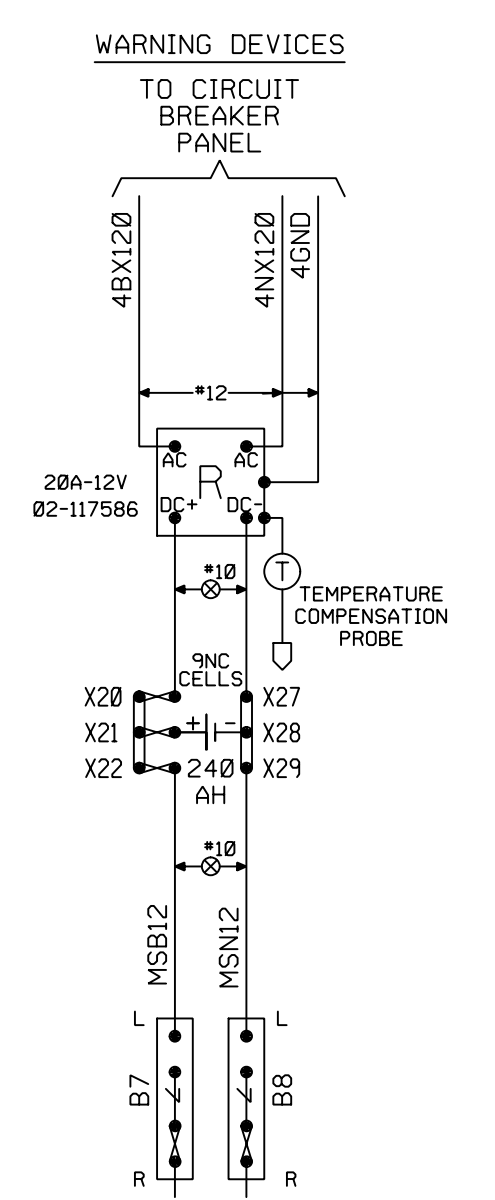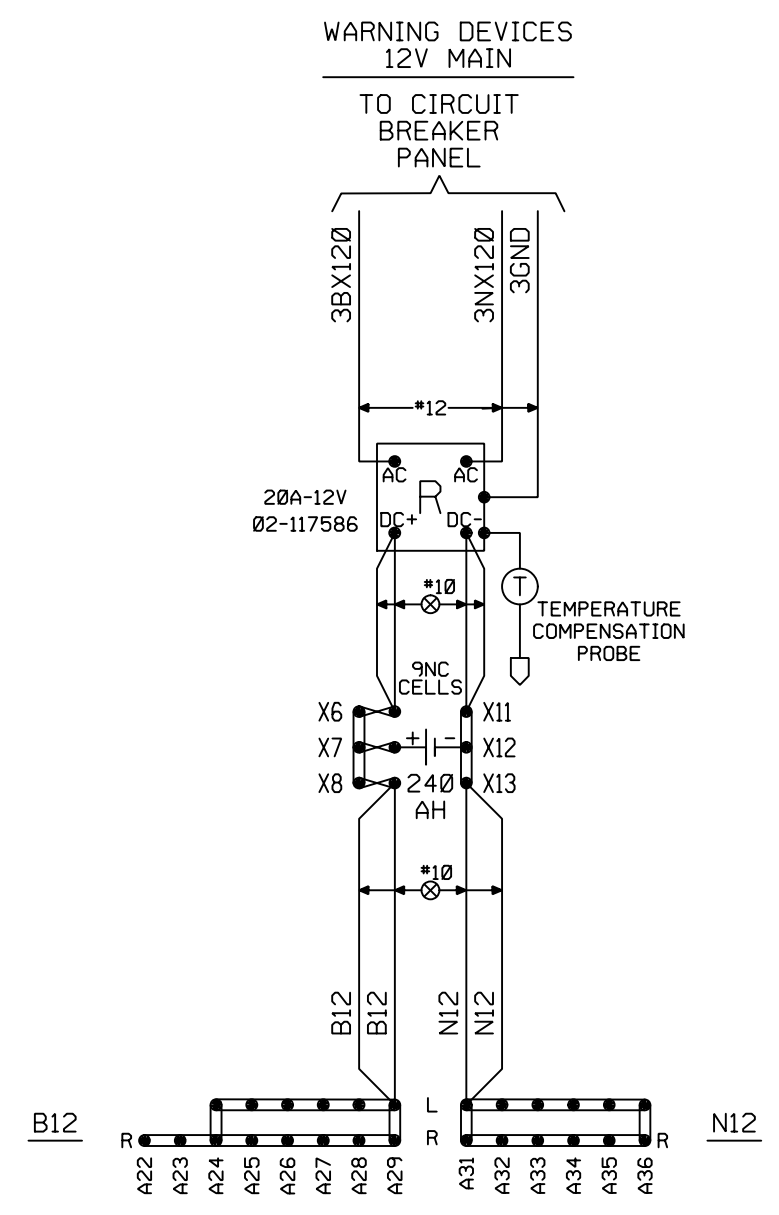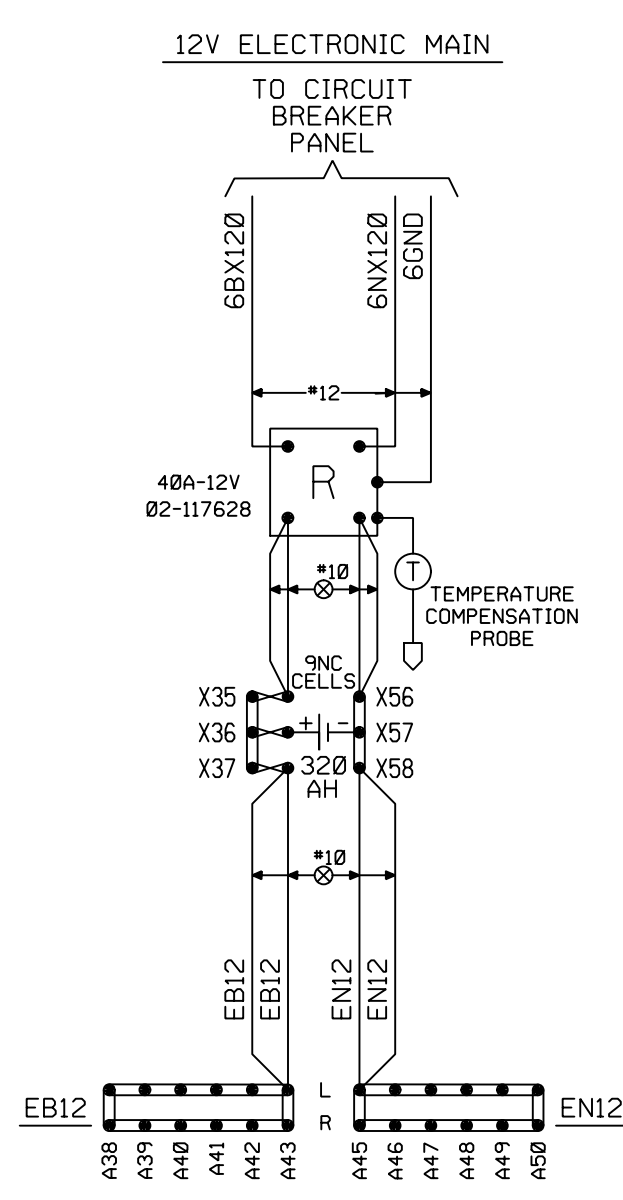

PER EXISTING PLANS IN FIELD
CHANGES WHERE MADE TO CIRCUITS
CHANGES WHERE NOT SHOWN
FIELD VERIFY CIRCUITS
AND MARK CHANGES FOR A.I.S.

RED = IN
YELLOW = OUT

DATE: 10-20-2015
NS PROJ.#
NS/WDM

REV	DATE	CKD BY

C&S CAD


**NORFOLK SOUTHERN**

UNION AVENUE / REPEATER 67.7ALLIANCE, OHIO

HIGHWAY CROSSING - REPEATER
POWER DISTRIBUTION
AND CABLE CIRCUITS

ISSUE DATE: APRIL 3, 1998		2412-0677	
REV. 43	09-04-13	SHEET 4	

24120677.04

 The Norfolk Southern logo, featuring a stylized 'NS' monogram with horizontal lines to the left, followed by the words 'NORFOLK SOUTHERN' in a bold, sans-serif font.

ALLIANCE, OHIO

HIGHWAY CROSSING - REPEATER
DUAL BIDIRECTIONAL GCP
MODEL 3000D2 02-806766
UNIT 1 (WEST)

2412-0677

SHEET 5

FIELD VERIFY
PROGRAM LEVEL
AND MARK FOR
A.I.S.

3000D2 PROGRAMMING CHART (LEVEL: J)	
NUMBER OF TRACK TRANSCEIVERS	2
T1: FREQUENCY	211Hz
T2: FREQUENCY	211Hz
T1: UNIDIRECTIONAL/BIDIRECTIONAL	BI
T2: UNIDIRECTIONAL/BIDIRECTIONAL	BI
T1: XMIT LEVEL (MAX/MED)	MAX
T2: XMIT LEVEL (MAX/MED)	MAX
T1: PREDICTOR/MOTION SENSOR	PRED
T2: PREDICTOR/MOTION SENSOR	PRED
T1: WARNING TIME	34 Sec
T2: WARNING TIME	34 Sec
T1: APPROACH DISTANCE	1970 Ft
T2: APPROACH DISTANCE	1970 Ft
UAX1 PICKUP DELAY (UAX) (0 = OFF)	25 Sec
ENA/UAX2 DELAY (0 = ENA)	25 Sec
T1: ISLAND DISTANCE	140 Ft
T2: ISLAND DISTANCE	140 Ft
NUMBER OF DAX'S	4 Ea
DAX A TRACK ASSIGNMENT (T1/T2)	1
DAX A DISTANCE (0 = PREEMPT)	540 Ft
DAX A WARNING TIME	30 Sec
DAX B TRACK ASSIGNMENT (T1/T2)	1
DAX B DISTANCE (0 = PREEMPT)	1120 Ft
DAX B WARNING TIME	34 Sec
DAX C TRACK ASSIGNMENT (T1/T2)	2
DAX C DISTANCE (0 = PREEMPT)	540 Ft
DAX C WARNING TIME	30 Sec
DAX D TRACK ASSIGNMENT (T1/T2)	2
DAX D DISTANCE (0 = PREEMPT)	1120 Ft
DAX D WARNING TIME	34 Sec
SLAVING (MASTER/SLAVE)	MASTER
PASSWORD ENABLED	NO
RECORDER INSTALLED	NO

EXPANDED PROGRAMMING

T1: SWITCH TO MS (ENTER EZ VALUE)	10 %
T2: SWITCH TO MS (ENTER EZ VALUE)	10 %
T1: TRANSFER DELAY MS TO GCP (0 = OFF)	0 Sec
T2: TRANSFER DELAY MS TO GCP (0 = OFF)	0 Sec
T1: TRANSFER MS TO GCP PRIME (ON/OFF)	---
T2: TRANSFER MS TO GCP PRIME (ON/OFF)	---
T1: TRANSFER MS TO GCP DAX A (ON/OFF)	---
T2: TRANSFER MS TO GCP DAX A (ON/OFF)	---
T1: TRANSFER MS TO GCP DAX B (ON/OFF)	---
T2: TRANSFER MS TO GCP DAX B (ON/OFF)	---
T1: TRANSFER MS TO GCP DAX C (ON/OFF)	---
T2: TRANSFER MS TO GCP DAX C (ON/OFF)	---
T1: TRANSFER MS TO GCP DAX D (ON/OFF)	---
T2: TRANSFER MS TO GCP DAX D (ON/OFF)	---
T1: PRIME PREDICTION OFFSET (0 = OFF)	0 Ft
T2: PRIME PREDICTION OFFSET (0 = OFF)	0 Ft
PICKUP DELAY PRIME	15 Sec
PICKUP DELAY DAX A	15 Sec
PICKUP DELAY DAX B	15 Sec
PICKUP DELAY DAX C	15 Sec
PICKUP DELAY DAX D	15 Sec
T1: ENHANCED DETECTION (ON/OFF)	OFF
T2: ENHANCED DETECTION (ON/OFF)	OFF
BACK-TO-BACK T1 AND T2 (NO/YES)	YES
T1: STATION STOP TIMER	10 Sec
T2: STATION STOP TIMER	10 Sec
T1: NUMBER OF TRACK WIRES (4/6)	4
T2: NUMBER OF TRACK WIRES (4/6)	4
T1: LOW EX ADJUSTMENT	0
T2: LOW EX ADJUSTMENT	0
T1: LOW EZ DETECTION	OFF
T2: LOW EZ DETECTION	OFF
T1: LOW EZ DETECTION TIMER (ON/OFF)	10 Min
T2: LOW EZ DETECTION TIMER (ON/OFF)	10 Min
T1: POSITIVE START (EZ LEVEL) (0 = OFF)	0
T2: POSITIVE START (EZ LEVEL) (0 = OFF)	0
T1: POSITIVE START TIMEOUT (0 = NONE)	0 Min
T2: POSITIVE START TIMEOUT (0 = NONE)	0 Min
SET AT OPERATION (NORMAL/DIAGNOSTIC)	NORMAL
DIAGNOSTIC MESSAGES (ON/OFF)	ON
DAX MESSAGES (ON/OFF)	ON
ADVANCE PREEMPT TIMER (0 = OFF)	0
T1: MOTION SENSING LEVEL (0 = NORMAL)	0 %
T2: MOTION SENSING LEVEL (0 = NORMAL)	0 %

* = 1ST SLOT AT LEFT END OF BAY

MODEL 3000D2 GCP MODULE ASSEMBLIES																						
UPPER BAY												LOWER BAY										
MODULES POSITION	M1	M2	M3	M4	M5	M6	M7	M8	M9	M10	M11	M12	M13	M14	M15	M16	M17	M18	M19	M20	M21	
MODULE NUMBERS	80211-f(1) * ISL	80211-f(2) ISL	80012 T/R 1	80012 T/R 2	80013 RLY DRV	80214 PROCS	80015 REC-INTF	80016 (1) DAX	80016 (2) DAX	80020 +80017	80211-f(1) * ISL	80211-f(2) ISL	80012 T/R 1	80012 T/R 2	80013 RLY DRV	80214 PROCS	80015 REC-INTF	80016 (1) DAX	80016 (2) DAX	80020 +80017	80028 XFRTMR	
MODULES USED	X	X	X	X	X	X	X	X	X	X	X	X	X	X	X	X	X	X	X	X	X	

NOTES:

1 - SEE IPI INSTRUCTION AND
INSTALLATION MANUAL FOR
80211 ISLAND CALIBRATION
PROCEDURE.

2 - TOGGLE SWITCH ON
MOTHER BOARD:
UP = DUAL FREQ.
DOWN = SINGLE FREQ.

** = 80214 & 80255 (WITH JUMPER)
CARDS AND E-LEVEL OR LATER
SOFTWARE NEEDED FOR SEAR II /
ECHELON CAPABILITIES.

THIS SHEET IS
DRAFTING CORRECTION
PER FIELD SURVEY
FIELD VERIFY PROGRAMMED
AS SHOWN AND MARK
FOR A.I.S.

3000D2 PROGRAMMING NOTES:

- 1) AVAILALBE WHEN "TRANSFER DELAY MS TO GCP" AND "PRIME PREDICTION OFFSET" IS ON
- 2) AVAILABLE WHEN "TRANSFER DELAY MS TO GCP" AND DAX DISTANCE IS GREATER THAN ZERO
- 3) AVAILABLE WHEN "ENHANCED DETECTION" IS ON
- 4) AVAILABLE WHEN "LOW EZ DETECTION" IS ON
- 5) AVAILABLE WHEN "POSITIVE START" IS ON



NORFOLK
SOUTHERN


UNION AVENUE / REPEATER 67.7ALLIANCE, OHIO

HIGHWAY CROSSING - REPEATER
DUAL BIDIRECTIONAL GCP
MODEL 3000D2 02-806766
UNIT 1 (WEST)

ISSUE DATE: APRIL 3, 19982412-0677

JS
JEM
JEM

REV. 509-04-13SHEET 6

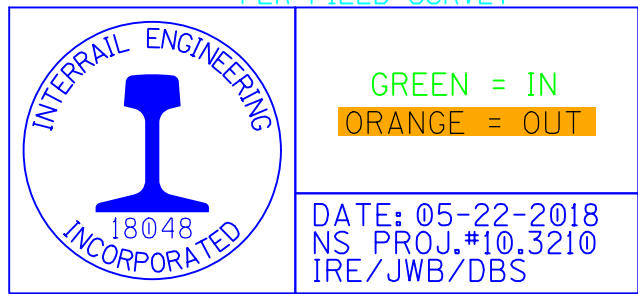

PER EXISTING PLANS IN FIELD
CHANGES WHERE MADE TO CIRCUITS
CHANGES WHERE NOT SHOWN
FIELD VERIFY CIRCUITS
AND MARK CHANGES FOR A.I.S.


RED = IN
YELLOW = OUT

DATE: 10-20-2015
NS PROJ.#
NS/WDM

REQUIRED MODULES

PART NUMBER AND MODULE NAME	UPPER BAY	LOWER BAY
80011-F (HZ) ISLAND MODULE	NONE	NONE
80012 TRANSCIVER MODULE	M3-M4	M13-M14
80013 RELAY DRIVE MODULE	M5	M15
80014 PROCESSOR MODULE	M6	M16
80015 DATA RECORDER MODULE	M7	M17
80016-1,2 DAX MODULE	M8	M18
80020 CONTROL MODULE INCLUDES 80017 KEYBOARD DISPLAY INTERFACE	M10	M20
80028 TRANSFER MODULE		M21

REDRAWN ON
NEW SHEET 8

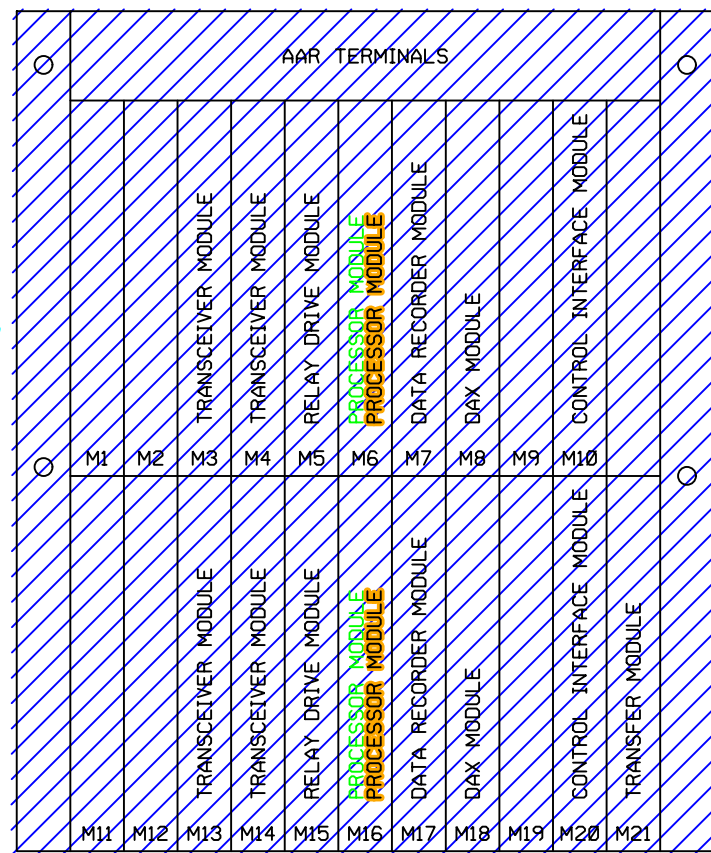

★ = FIELD TO INSERT
INFORMATION
DAY OF CUT-OVER.
N/A = INFORMATION
NOT APPLICABLE

ISLAND FREQUENCY:
TRACK 2: N/A
TRACK 1: N/A

★ THIS UNIT TO BE EQUIPPED
WITH "F" LEVEL SOFTWARE
ON PROCESSOR MODULE
(80014) AND DATA
RECORDER MODULE (80015)

★ NOTES:
1 - SEE IPI INSTRUCTION AND
INSTALLATION MANUAL FOR
80211 ISLAND CALIBRATION
PROCEDURE.
2 - TOGGLE SWITCH ON
MOTHER BOARD:
UP = DUAL FREQ.
DOWN = SINGLE FREQ.

PROGRAM
REDRAWN
ON NEW
SHEET 6

★ SYSTEM PROGRAMMING PARAMETERS		
PROMPT		RESPONSE
NUMBER OF TRACKS		2 TRACK
FREQUENCY (MS/GCP)		211 Hz
UNI/BIDIRECTIONAL	T1	BIDIRECTIONAL
UNI/BIDIRECTIONAL	T2	BIDIRECTIONAL
XMIT LEVEL	T1	MAX
XMIT LEVEL	T2	MAX
PREDICTOR/MOTION SENSOR	T1	PREDICTOR
PREDICTOR/MOTION SENSOR	T2	PREDICTOR
WARNING TIME SELECTED	T1	34 SEC.
WARNING TIME SELECTED	T2	34 SEC.
APPROACH DIST. SELECTED	T1	2450 FT.
APPROACH DIST. SELECTED	T2	2450 FT.
APPROACH DIST. COMPUTED	T1	N/A FT.
APPROACH DIST. COMPUTED	T2	N/A FT.
UAX PICKUP DELAY(0=OFF)		0-SEC.
ENA/UAX2 PICKUP DELAY(0=ENA)		25-SEC.
NUMBER OF DAX'S		2
ISLAND DISTANCE	T1	0 FT.
ISLAND DISTANCE	T2	0 FT.
DAX A TRACK ASSIGNMENT		1
DAX A DISTANCE (0=PREEMPT)		312 FT.
DAX A WARNING TIME		30 SEC.
DAX B TRACK ASSIGNMENT		N/A
DAX B DISTANCE (0=PREEMPT)		N/A FT.
DAX B WARNING TIME		N/A SEC.
DAX C TRACK ASSIGNMENT		2
DAX C DISTANCE (0=PREEMPT)		312 FT.
DAX C WARNING TIME		30 SEC.
DAX D TRACK ASSIGNMENT		N/A
DAX D DISTANCE (0=PREEMPT)		N/A FT.
DAX D WARNING TIME		N/A SEC.
SLAVING MASTER/SLAVE		SLAVE
PASSWORD ENABLED		DISABLED
RECORDER INSTALLED		INSTALLED
RS-232-C BAUD RATE		
RS-232-C DATA BITS		
RS-232-C STOP BITS		
RS-232-C PARITY		
DATE (E.G.,MON 8 JUNE 1987)		*
TIME (E.G., 11:25:43 AM)		*
DAYLIGHT SAVINGS		ON/OFF
EXPANDED PROGRAMMING HISTORY		
SWITCH TO MS	T1	10-EZ
SWITCH TO MS	T2	10-EZ
TRANSFER DELAY MS TO GCP	T1	0-SEC.
TRANSFER DELAY MS TO GCP	T2	0-SEC.
PRIME PREDICTION OFFSET	T1	0-FT.
PRIME PREDICTION OFFSET	T2	0-FT.
PICKUP DELAY PRIME		15-SEC.
PICKUP DELAY DAX A		15-SEC.
PICKUP DELAY DAX B		15-SEC.
PICKUP DELAY DAX C		15-SEC.
PICKUP DELAY DAX D		15-SEC.
COMPENSATION VALUE	T1	SET BY SYSTEM
COMPENSATION VALUE	T2	SET BY SYSTEM
NUMBER OF TRACK WIRES	T1	4 WIRES
NUMBER OF TRACK WIRES	T2	4 WIRES

**NORFOLK
SOUTHERN**

UNION AVENUE / REPEATER 67.7

ALLIANCE, OHIO

HIGHWAY CROSSING - REPEATER
DUAL BIDIRECTIONAL GCP
MODEL 3000D2 02-806766
UNIT 2 (EAST)

ISSUE DATE: APRIL 3, 1998

2412-0677

REV. 43

09-04-13

SHEET 76

24120677.07
24120677.06

FIELD VERIFY
PROGRAM LEVEL
AND MARK FOR
A.I.S.

3000D2 PROGRAMMING CHART (LEVEL: J)	
NUMBER OF TRACK TRANSCEIVERS	2
T1: FREQUENCY	211Hz
T2: FREQUENCY	211Hz
T1: UNIDIRECTIONAL/BIDIRECTIONAL	BI
T2: UNIDIRECTIONAL/BIDIRECTIONAL	BI
T1: XMIT LEVEL (MAX/MED)	MAX
T2: XMIT LEVEL (MAX/MED)	MAX
T1: PREDICTOR/MOTION SENSOR	PRED
T2: PREDICTOR/MOTION SENSOR	PRED
T1: WARNING TIME	34 Sec
T2: WARNING TIME	34 Sec
T1: APPROACH DISTANCE	1970 Ft
T2: APPROACH DISTANCE	1970 Ft
UAX1 PICKUP DELAY (UAX) (0 = OFF)	25 Sec
ENA/UAX2 DELAY (0 = ENA)	25 Sec
T1: ISLAND DISTANCE	140 Ft
T2: ISLAND DISTANCE	140 Ft
NUMBER OF DAX'S	4 Ea
DAX A TRACK ASSIGNMENT (T1/T2)	1
DAX A DISTANCE (0 = PREEMPT)	540 Ft
DAX A WARNING TIME	30 Sec
DAX B TRACK ASSIGNMENT (T1/T2)	1
DAX B DISTANCE (0 = PREEMPT)	1120 Ft
DAX B WARNING TIME	34 Sec
DAX C TRACK ASSIGNMENT (T1/T2)	2
DAX C DISTANCE (0 = PREEMPT)	540 Ft
DAX C WARNING TIME	30 Sec
DAX D TRACK ASSIGNMENT (T1/T2)	2
DAX D DISTANCE (0 = PREEMPT)	1120 Ft
DAX D WARNING TIME	34 Sec
SLAVING (MASTER/SLAVE)	MASTER
PASSWORD ENABLED	NO
RECORDER INSTALLED	NO

EXPANDED PROGRAMMING

T1: SWITCH TO MS (ENTER EZ VALUE)	10 %
T2: SWITCH TO MS (ENTER EZ VALUE)	10 %
T1: TRANSFER DELAY MS TO GCP (0 = OFF)	0 Sec
T2: TRANSFER DELAY MS TO GCP (0 = OFF)	0 Sec
T1: TRANSFER MS TO GCP PRIME (ON/OFF)	---
T2: TRANSFER MS TO GCP PRIME (ON/OFF)	---
T1: TRANSFER MS TO GCP DAX A (ON/OFF)	---
T2: TRANSFER MS TO GCP DAX A (ON/OFF)	---
T1: TRANSFER MS TO GCP DAX B (ON/OFF)	---
T2: TRANSFER MS TO GCP DAX B (ON/OFF)	---
T1: TRANSFER MS TO GCP DAX C (ON/OFF)	---
T2: TRANSFER MS TO GCP DAX C (ON/OFF)	---
T1: TRANSFER MS TO GCP DAX D (ON/OFF)	---
T2: TRANSFER MS TO GCP DAX D (ON/OFF)	---
T1: PRIME PREDICTION OFFSET (0 = OFF)	0 Ft
T2: PRIME PREDICTION OFFSET (0 = OFF)	0 Ft
PICKUP DELAY PRIME	15 Sec
PICKUP DELAY DAX A	15 Sec
PICKUP DELAY DAX B	15 Sec
PICKUP DELAY DAX C	15 Sec
PICKUP DELAY DAX D	15 Sec
T1: ENHANCED DETECTION (ON/OFF)	OFF
T2: ENHANCED DETECTION (ON/OFF)	OFF
BACK-TO-BACK T1 AND T2 (NO/YES)	YES
T1: STATION STOP TIMER	10 Sec
T2: STATION STOP TIMER	10 Sec
T1: NUMBER OF TRACK WIRES (4/6)	4
T2: NUMBER OF TRACK WIRES (4/6)	4
T1: LOW EX ADJUSTMENT	0
T2: LOW EX ADJUSTMENT	0
T1: LOW EZ DETECTION	OFF
T2: LOW EZ DETECTION	OFF
T1: LOW EZ DETECTION TIMER (ON/OFF)	10 Min
T2: LOW EZ DETECTION TIMER (ON/OFF)	10 Min
T1: POSITIVE START (EZ LEVEL) (0 = OFF)	0
T2: POSITIVE START (EZ LEVEL) (0 = OFF)	0
T1: POSITIVE START TIMEOUT (0 = NONE)	0 Min
T2: POSITIVE START TIMEOUT (0 = NONE)	0 Min
SET AT OPERATION (NORMAL/DIAGNOSTIC)	NORMAL
DIAGNOSTIC MESSAGES (ON/OFF)	ON
DAX MESSAGES (ON/OFF)	ON
ADVANCE PREEMPT TIMER (0 = OFF)	0
T1: MOTION SENSING LEVEL (0 = NORMAL)	0 %
T2: MOTION SENSING LEVEL (0 = NORMAL)	0 %

(1)
(1)
(2)
(2)
(2)
(2)
(2)
(2)
(2)
(2)

(3)
(3)
(3)

(4)
(4)
(5)
(5)

THIS SHEET IS
DRAFTING CORRECTION
PER FIELD SURVEY
FIELD VERIFY PROGRAMMED
AS SHOWN AND MARK
FOR A.I.S.

* = 1ST SLOT AT LEFT END OF BAY

MODEL 3000D2 GCP MODULE ASSEMBLIES																						
UPPER BAY												LOWER BAY										
MODULES POSITION	M1	M2	M3	M4	M5	M6	M7	M8	M9	M10	M11	M12	M13	M14	M15	M16	M17	M18	M19	M20	M21	
MODULE NUMBERS	80211-f(1) * ISL	80211-f(2) ISL	80012 T/R 1	80012 T/R 2	80013 RLY DRV	80214 PROCS	80015 REC-INTF	80016 (1) DAX	80016 (2) DAX	80020 +80017	80211-f(1) * ISL	80211-f(2) ISL	80012 T/R 1	80012 T/R 2	80013 RLY DRV	80214 PROCS	80015 REC-INTF	80016 (1) DAX	80016 (2) DAX	80020 +80017	80028 XFRTMR	
			x	x	x	x	x	x		x			x	x	x	x	x	x		x	x	
MODULES USED			x	x	x	x	x	x		x			x	x	x	x	x	x		x	x	

**

NOTES:

- 1 - SEE IPI INSTRUCTION AND
INSTALLATION MANUAL FOR
80211 ISLAND CALIBRATION
PROCEDURE.
- 2 - TOGGLE SWITCH ON
MOTHER BOARD:
UP = DUAL FREQ.
DOWN = SINGLE FREQ.

** = 80214 & 80255 (WITH JUMPER)
CARDS AND E-LEVEL OR LATER
SOFTWARE NEEDED FOR SEAR II /
ECHELON CAPABILITIES.

3000D2 PROGRAMMING NOTES:

- 1) AVAILALBE WHEN "TRANSFER DELAY MS TO GCP" AND
"PRIME PREDICTION OFFSET" IS ON
- 2) AVAILABLE WHEN "TRANSFER DELAY MS TO GCP" AND
DAX DISTANCE IS GREATER THAN ZERO
- 3) AVAILABLE WHEN "ENHANCED DETECTION" IS ON
- 4) AVAILABLE WHEN "LOW EZ DETECTION" IS ON
- 5) AVAILABLE WHEN "POSITIVE START" IS ON



NORFOLK
SOUTHERN

UNION AVENUE / REPEATER 67.7ALLIANCE, OHIO

HIGHWAY CROSSING - REPEATER
DUAL BIDIRECTIONAL GCP
MODEL 3000D2 02-806766
UNIT 1 (WEST)


ISSUE DATE: APRIL 3, 19982412-0677

JS
JEM
JEM

REV. 509-04-13SHEET 8

REV	DATE	CKD BY

C&S CAD

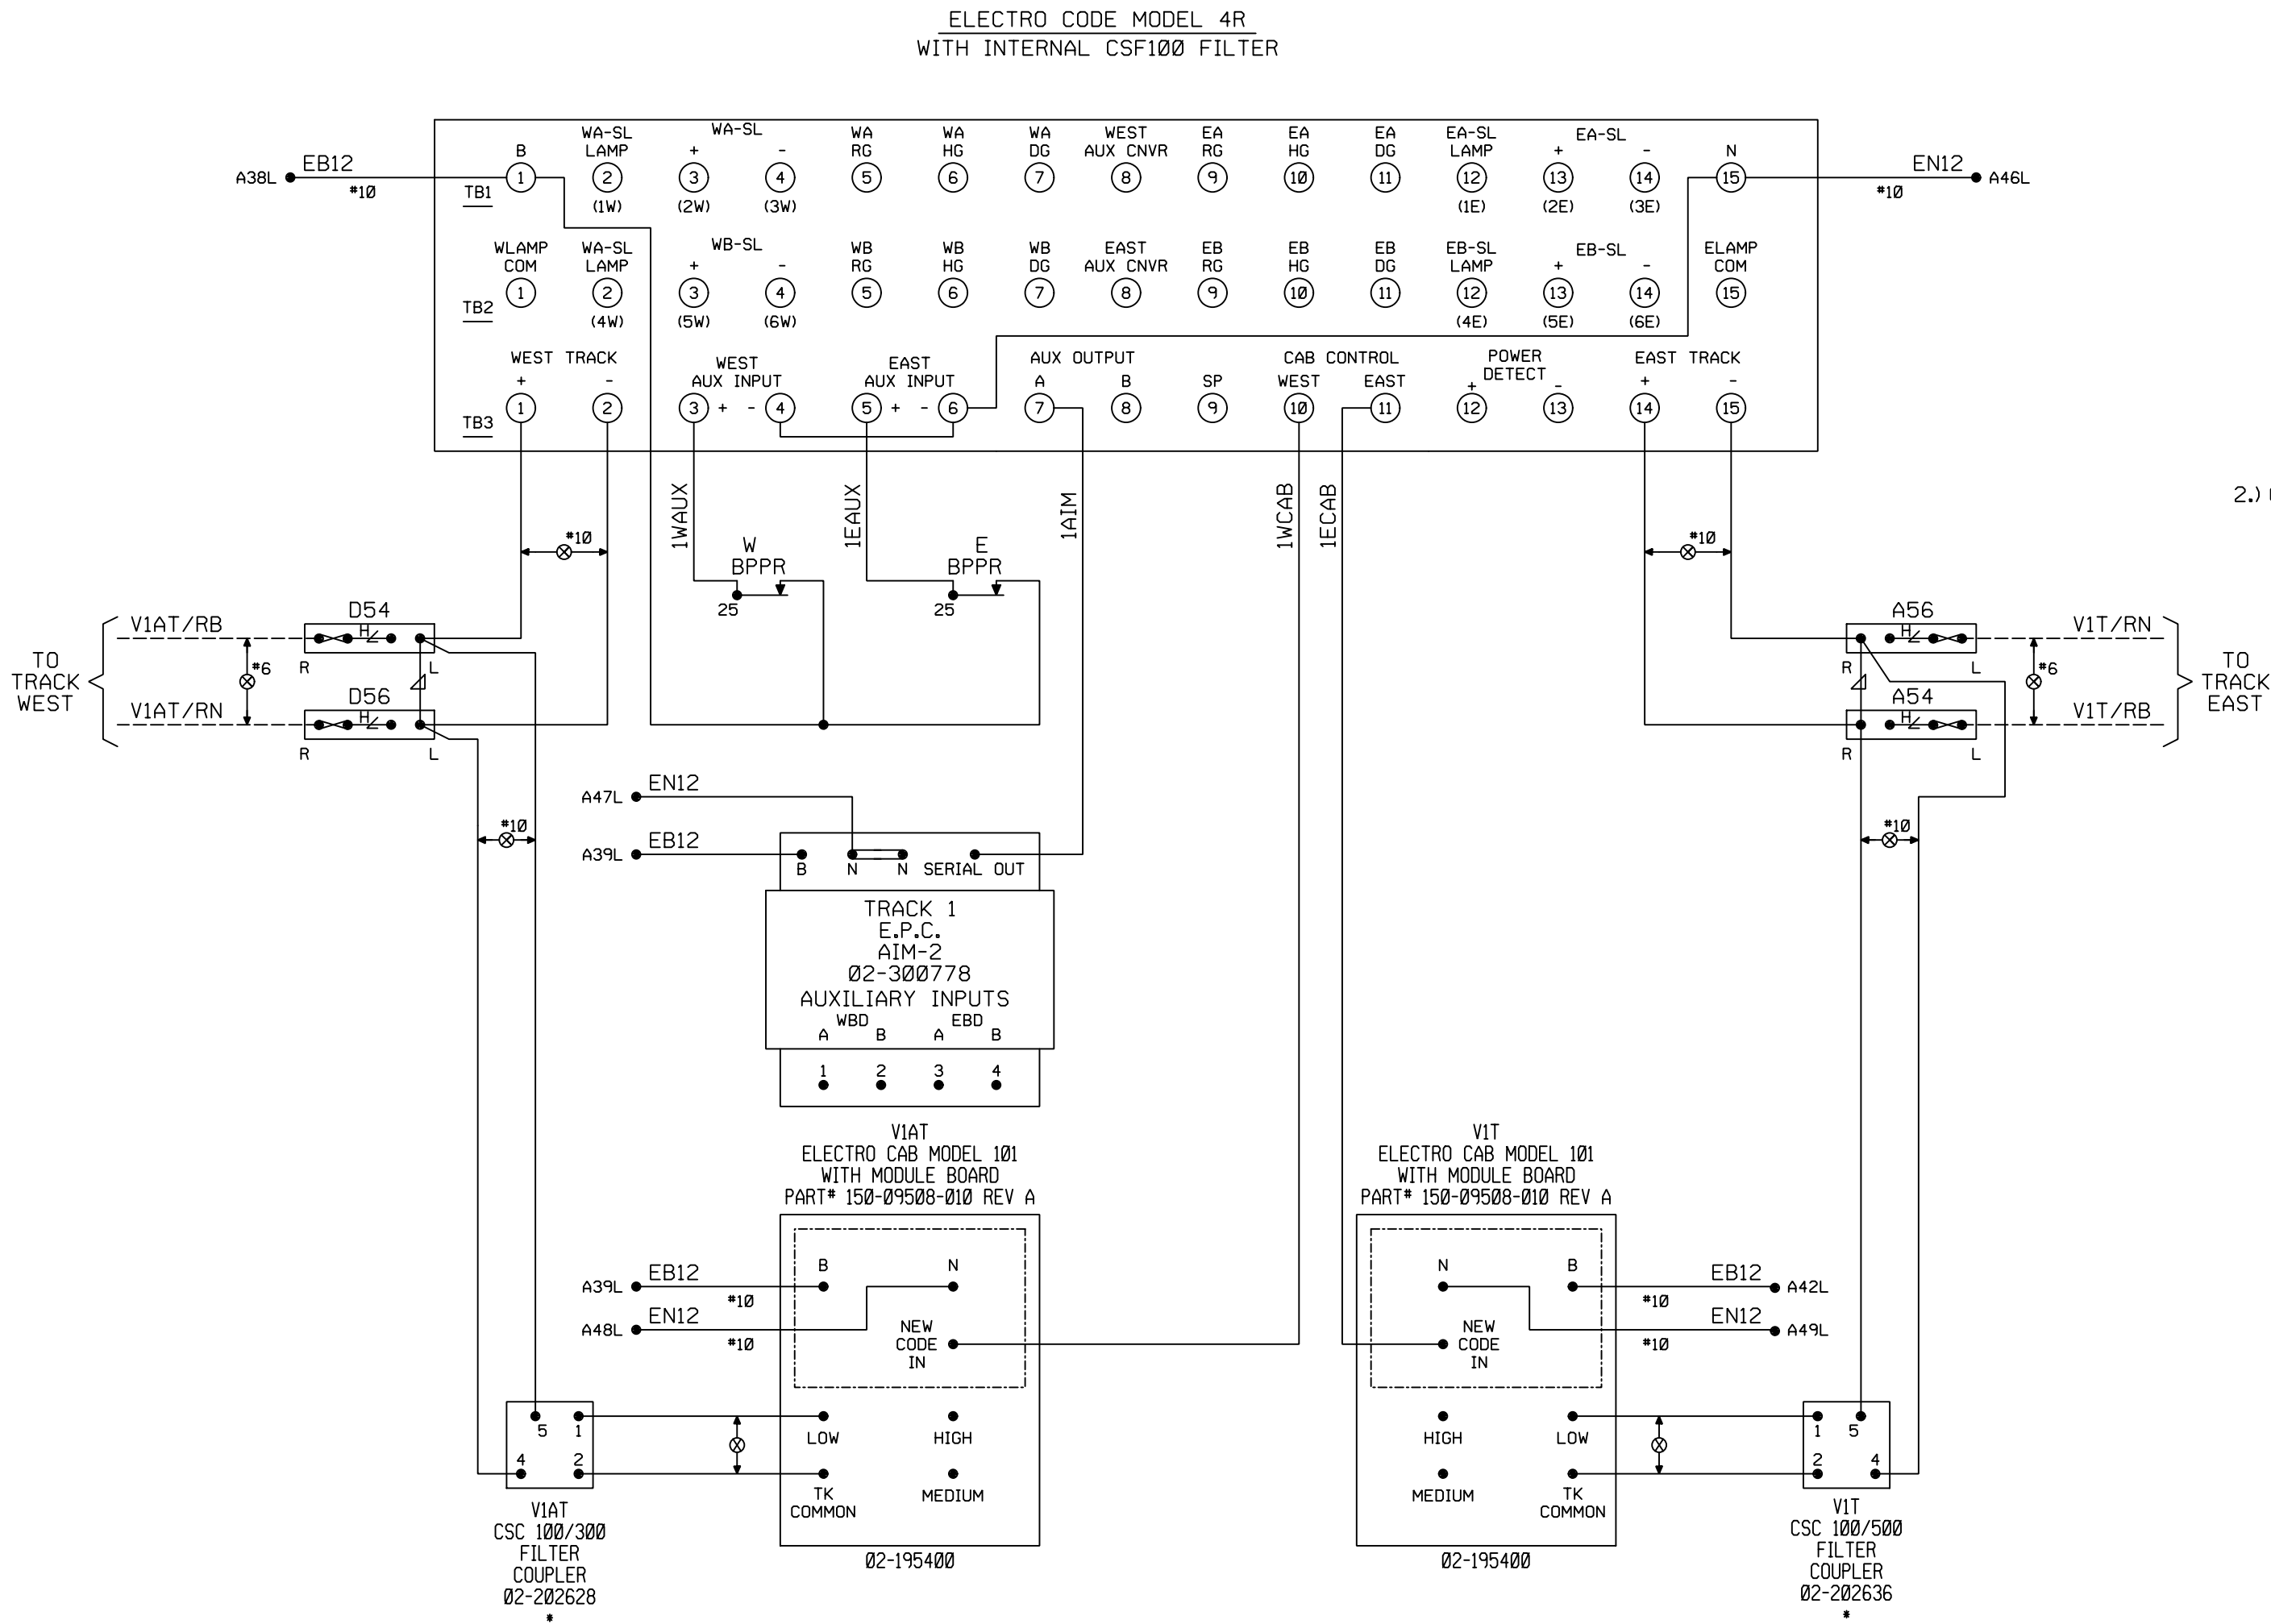


7.) AIM-2 JUMPERS (TIED TO B12 WHEN HIGH)

(A,B)	STICK	CODE UPGRADES
(0,0)	NO	0 → 0 75 → 75 120 → 120 180 → 180
(0,1)	YES	0 → 0 75 → 75 120 → 120 180 → 180
(1,0)	YES	0 → 0 75 → 75 120 → 180 180 → 180
(1,1)	YES	0 → 75 75 → 180 120 → 180 180 → 180

NOTE:
ELECTRO CODE 4 UNIT HAS INTERNAL STICKS
WITH CAB UPGRADE CAPABILITY.

- NOTES:
1.) BOARD LAYOUT (WITH INTERNAL CSF100 FILTER)

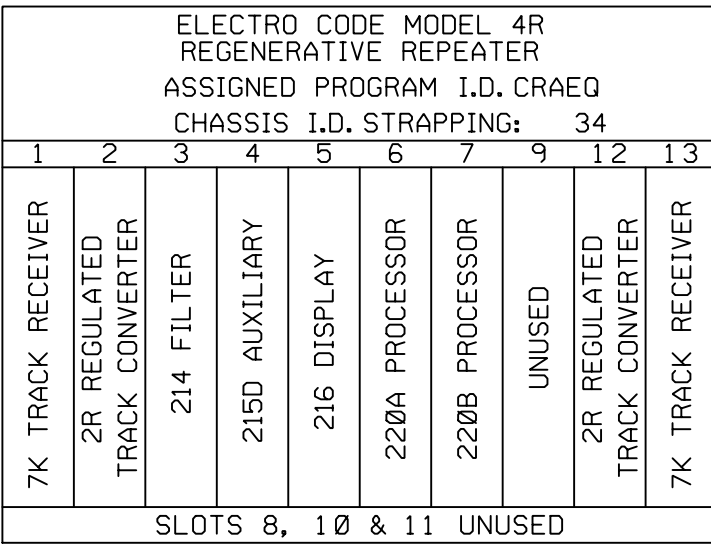

2.) CODES

ELECTRO CODE 4 CODES EASTBOUND

VIAT		TRACK 1		VIT	
CAB OUT	CODE OUT	USAGE	TYPE	TRK CAB	CODE IN
0	1	TRACK	SEMI-VTL	0	1
0	2	BLOCK CLEAR	VITAL	0	2
75	3	APPROACH WITH CAB	VITAL	75	3
120	4	APPROACH MEDIUM	VITAL	120	4
0	5	BLOCK INDICATION	NONVITAL	0	5
0	6	TUMBLEDOWN	NONVITAL	0	6
180	7	CLEAR	VITAL	180	7
0	1	CAB TURN ON	VITAL	0	8
0	9	APPROACH W/O CAB	VITAL	0	9

(NO STICK CAPABILITY)

ELECTRO CODE 4 CODES WESTBOUND

VIAT		TRACK 1		VIT	
CODE IN	TRK CAB	TYPE	USAGE	CODE OUT	CAB OUT
1	0	SEMI-VTL	TRACK	1	0
2	75	VITAL	BLOCK CLEAR	2	75
3	75	VITAL	APPROACH WITH CAB	4	120
4	120	VITAL	APPROACH MEDIUM	4	120
5	0	NONVITAL	BLOCK INDICATION	5	0
6	0	NONVITAL	TUMBLEDOWN	6	0
7	180	VITAL	CLEAR	7	180
8	0	VITAL	CAB TURN ON	1	0
9	0	VITAL	APPROACH W/O CAB	9	0

(NO STICK CAPABILITY)

3.) CODE 5 SELECT SWITCHES S1

EAST	C1	4 OPEN	LOCATED ON 215 MODULE (REPEATS CODE 5)
	C5	3 CLOSED	
WEST	C1	2 OPEN	
	C5	1 OPEN	

- 4.) * = MOUNT FILTER COUPLER ADJACENT TO
ELECTRO CAB 101.
5.) () = COLORLIGHT NOMENCLATURE.
6.) 215D MODULE (WIRED AS OLD 215B CARD)
JUMPER B REMOVED A,C&D LEFT ON.




UNION AVENUE / REPEATER 67.7 ALLIANCE, OHIO

HIGHWAY CROSSING - REPEATER
ELECTROCODE 4 CIRCUITS
TRACK 1


ISSUE DATE:	APRIL 3, 1998	2412-0677
REV.	3	09-04-13
SHEET	97	

24120677.09
24120677.07

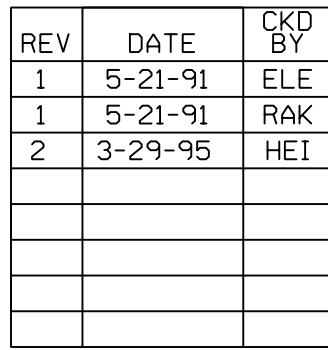

REV	DATE	CKD BY


C&S CAD

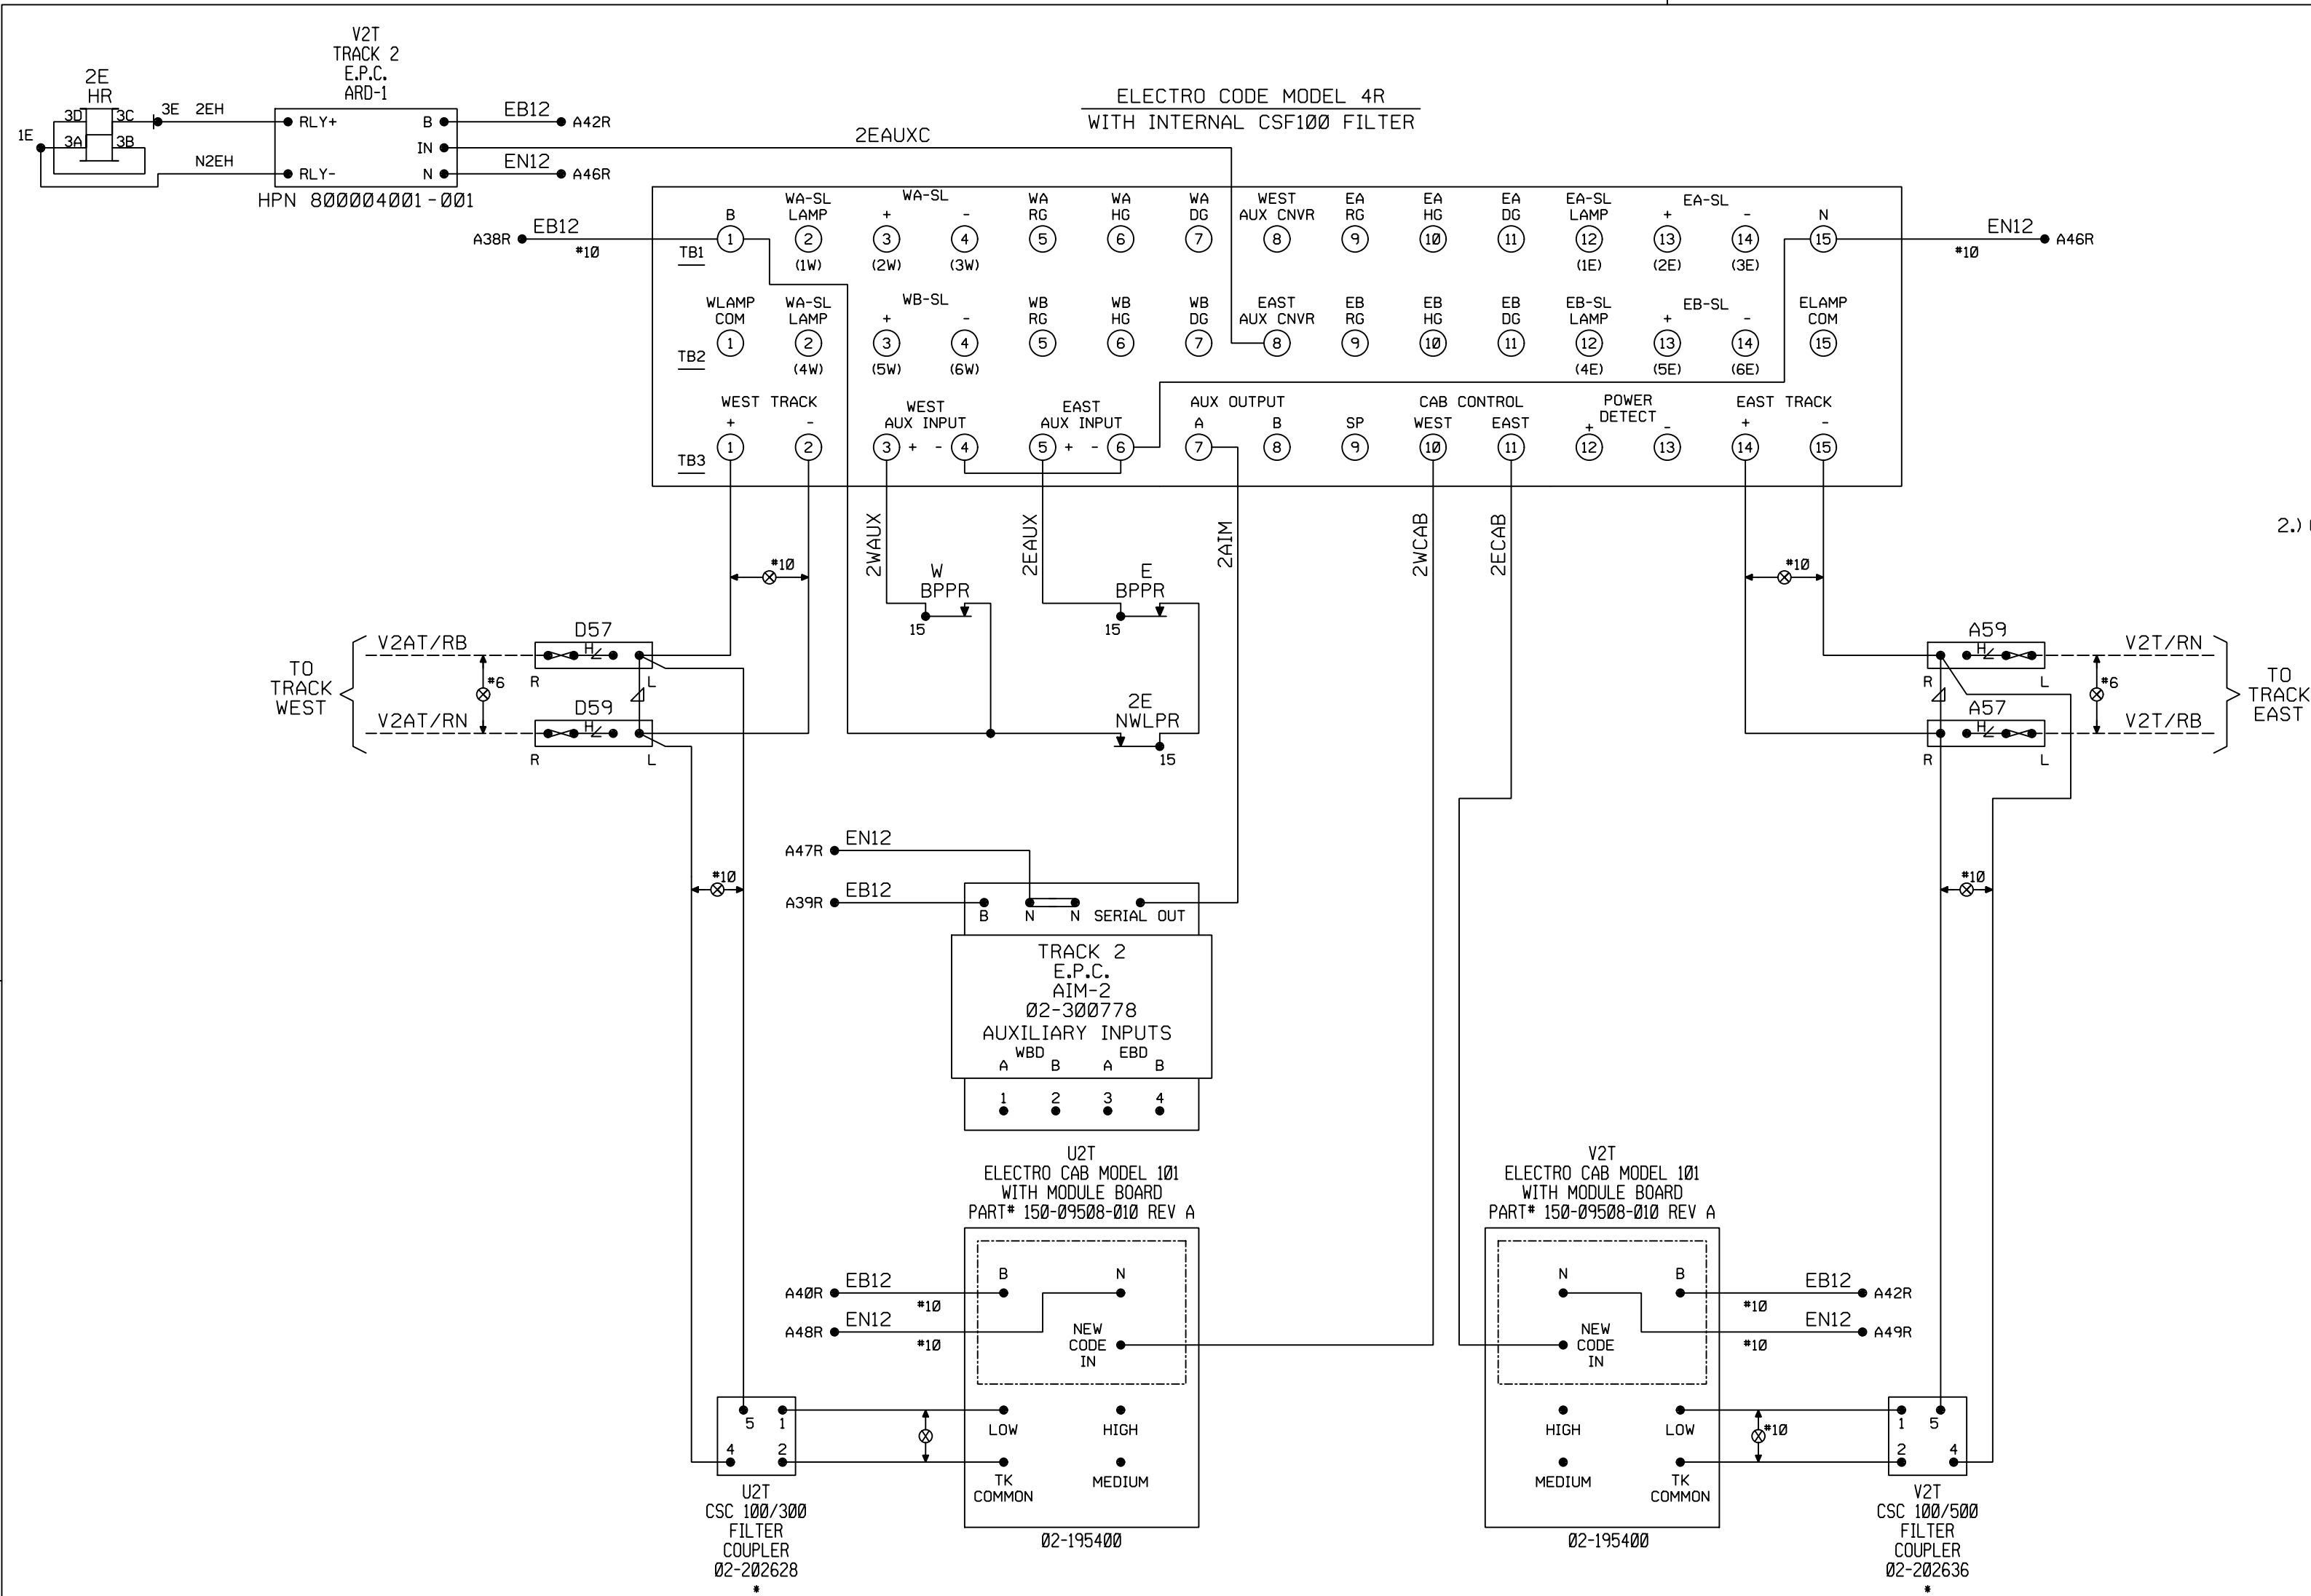

7.) AIM-2 JUMPERS (TIED TO B12 WHEN HIGH)		CODE UPGRADES			
(A,B)	STICK				
(0,0)	NO	0 → 0	75 → 75	120 → 120	180 → 180
(0,1)	YES	0 → 0	75 → 75	120 → 120	180 → 180
(1,0)	YES	0 → 0	75 → 75	120 → 180	180 → 180
(1,1)	YES	0 → 75	75 → 180	120 → 180	180 → 180

NOTE:
ELECTRO CODE 4 UNIT HAS INTERNAL STICKS
WITH CAB UPGRADE CAPABILITY.

- NOTES:
1.) BOARD LAYOUT (WITH INTERNAL CSF100 FILTER)

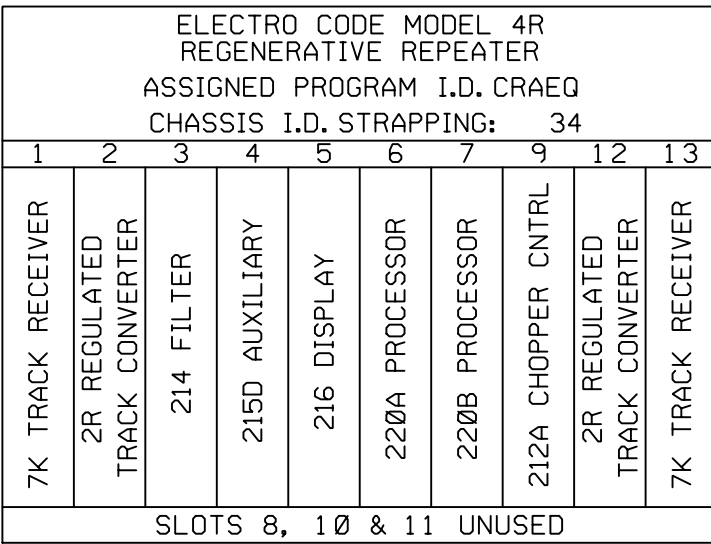

2.) CODES

U2T		TRACK 2		V2T	
CAB OUT	CODE OUT	USAGE	TYPE	TRK CAB	CODE IN
0	1	TRACK	SEMI-VTL	0	1
0	2	BLOCK CLEAR	VITAL	0	2
75	3	APPROACH WITH CAB	VITAL	75	3
120	4	APPROACH MEDIUM	VITAL	120	4
0	5	BLOCK INDICATION	NONVITAL	0	5
0	6	TUMBLEDOWN	NONVITAL	0	6
180	7	CLEAR	VITAL	180	7
0	1	CAB TURN ON	VITAL	0	8
0	9	APPROACH W/O CAB	VITAL	0	9
(NO STICK CAPABILITY)					

U2T		TRACK 2		V2T	
CODE IN	TRK CAB	TYPE	USAGE	CODE OUT	CAB OUT
1	0	SEMI-VTL	TRACK	1	0
2	180	VITAL	BLOCK CLEAR	2	180
3	75	VITAL	APPROACH WITH CAB	3	75
4	120	VITAL	APPROACH MEDIUM	4	120
5	0	NONVITAL	BLOCK INDICATION	5	0
6	0	NONVITAL	TUMBLEDOWN	6	0
7	180	VITAL	CLEAR	7	180
8	0	VITAL	CAB TURN ON	1	0
9	0	VITAL	APPROACH W/O CAB	9	0
(NO STICK CAPABILITY)					

3.) CODE 5 SELECT SWITCHES S1

EAST	C1	4 OPEN	LOCATED ON 215 MODULE (REPEATS CODE 5)
	C5	3 CLOSED	
WEST	C1	2 OPEN	
	C5	1 OPEN	

- 4.) * = MOUNT FILTER COUPLER ADJACENT TO ELECTRO CAB 101.
5.) () = COLORLIGHT NOMENCLATURE.
6.) 215D MODULE (WIRED AS OLD 215B CARD) JUMPER B REMOVED A,C,D LEFT ON.





UNION AVENUE / REPEATER 67.7 ALLIANCE, OHIO

HIGHWAY CROSSING - REPEATER
ELECTROCODE 4 CIRCUITS
TRACK 2


ISSUE DATE: APRIL 3, 1998			2412-0677	
REV. 3	09-04-13	SHEET	10 8	

24120677.10
24120677.08

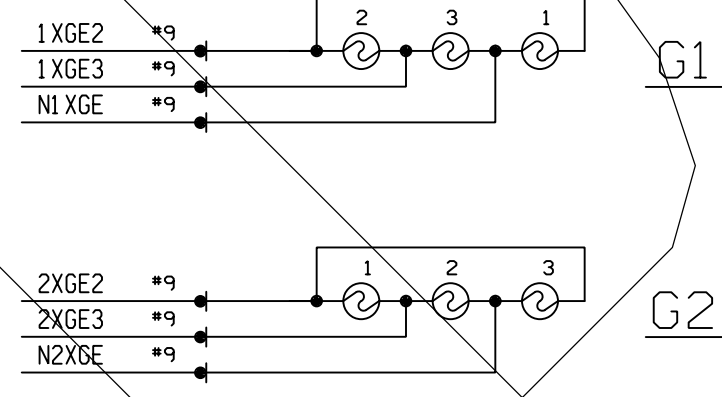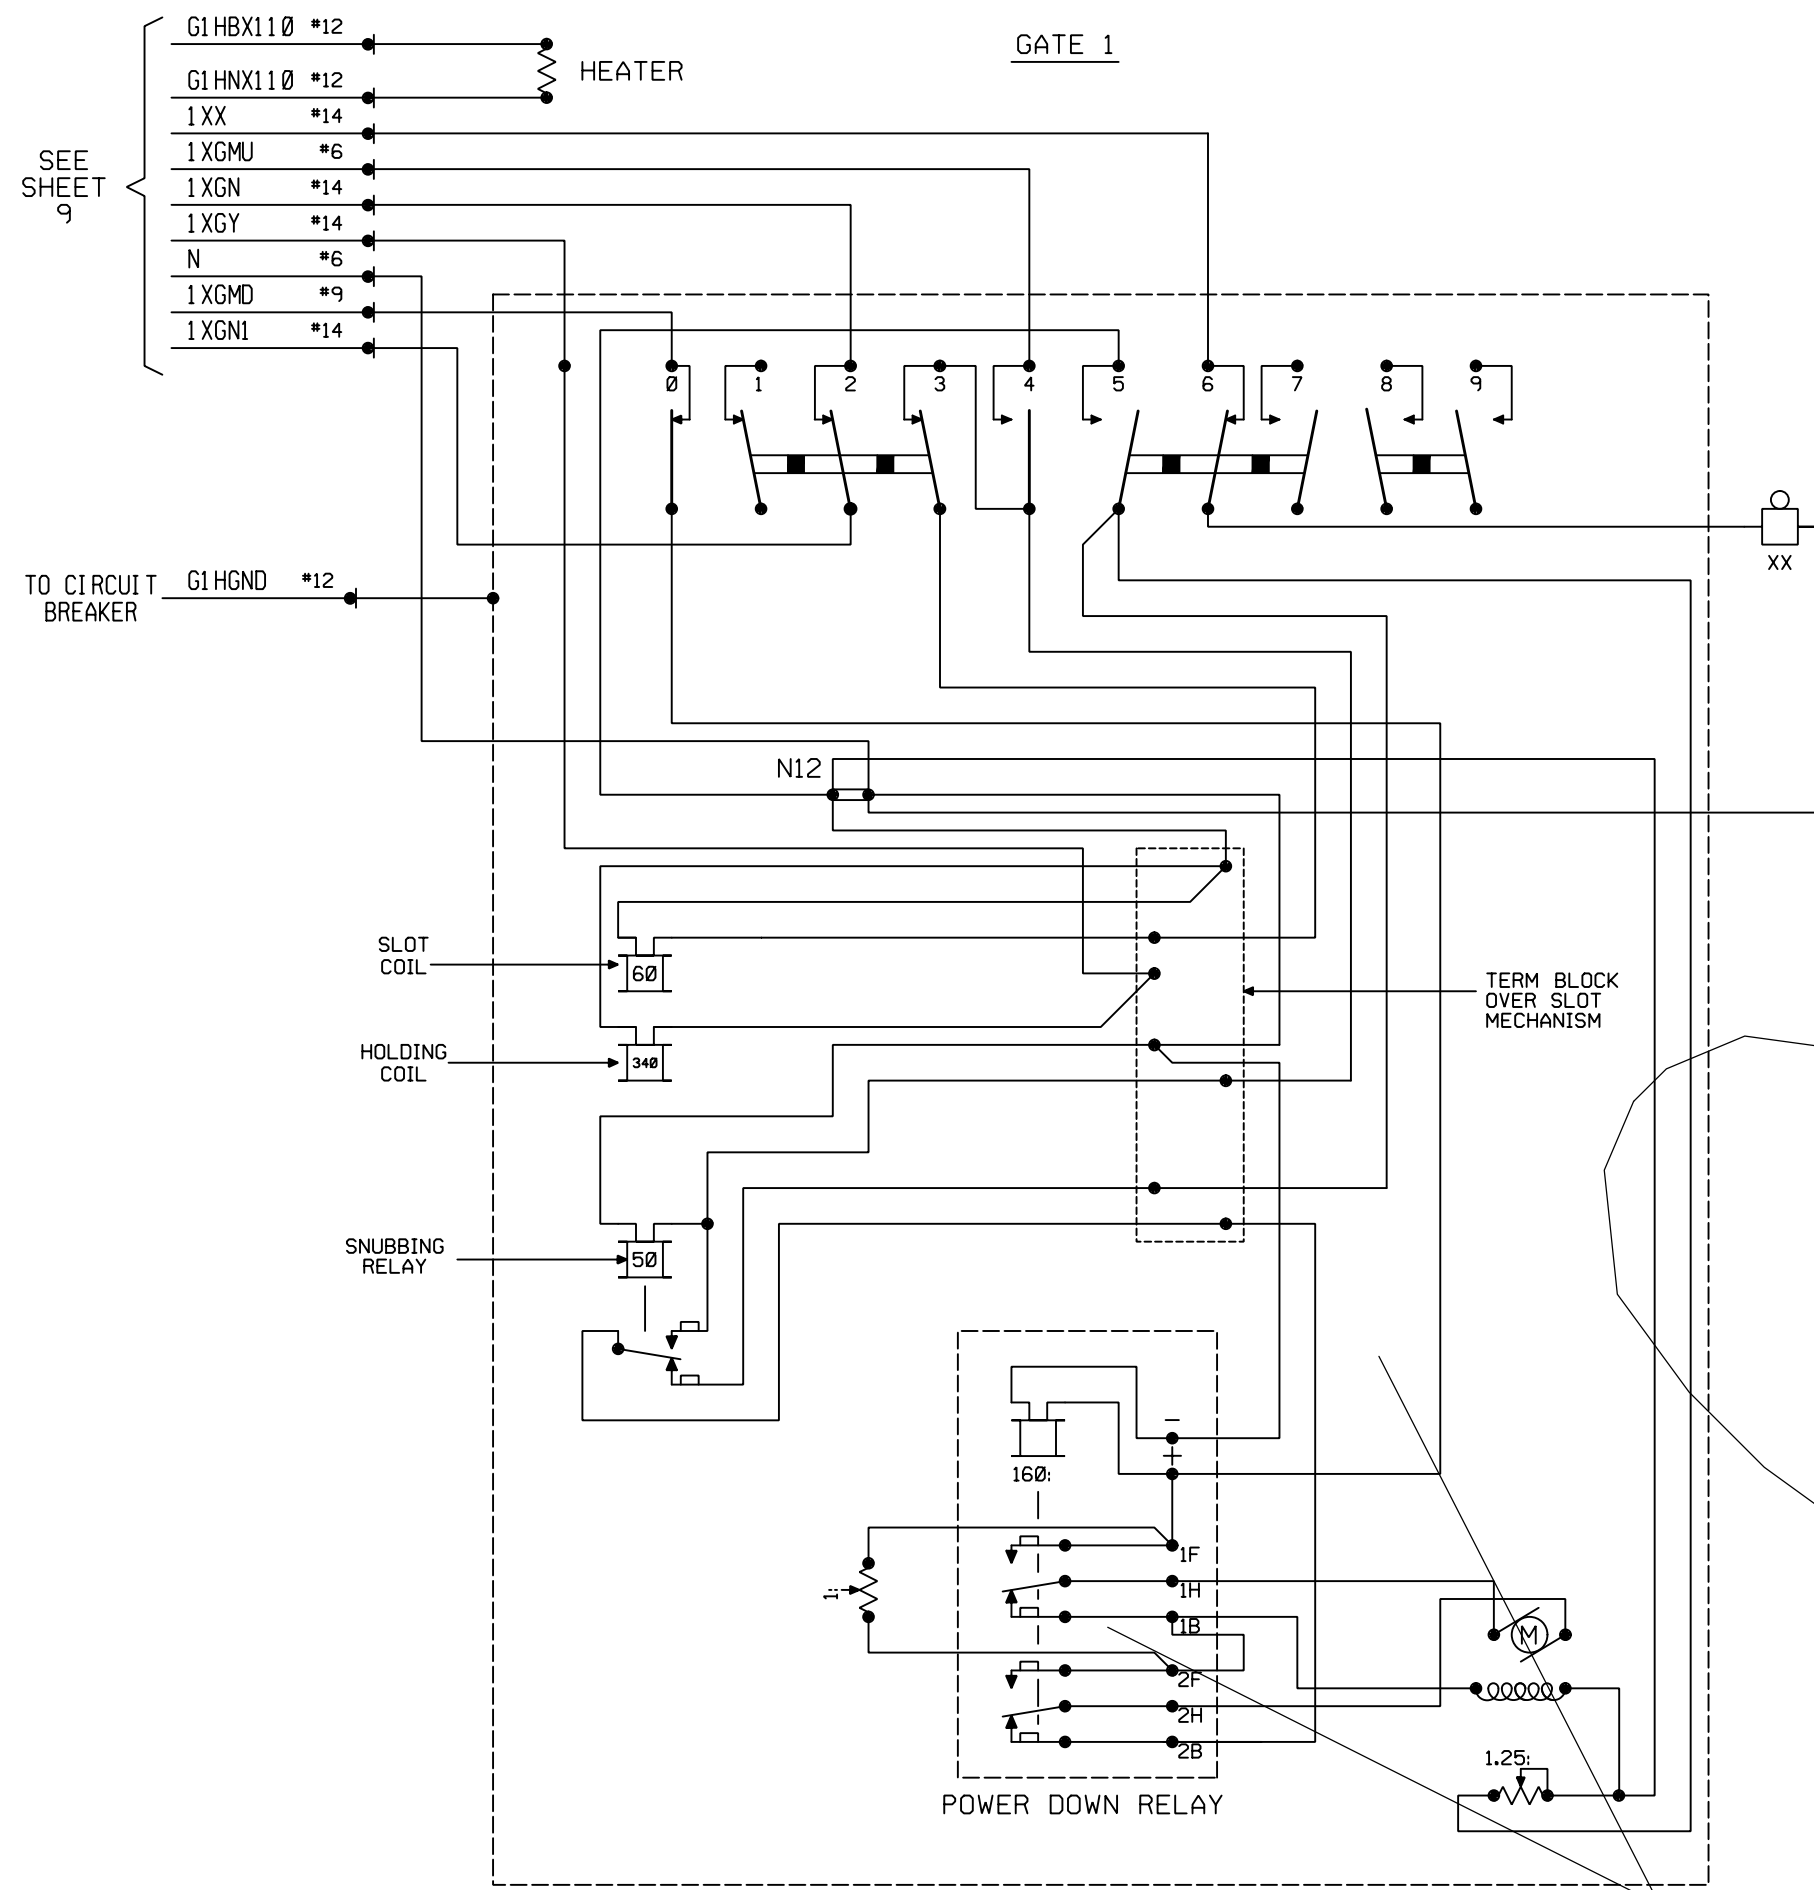

WESTERN RAILROAD
SUPPLY CO.
MODEL 10
TYPE 3564
GATE MECHANISM

MODEL 10 GATES NO
LONGER INSTALLED PER
FEILD SURVEY THIS SHEET
IS VOID FOR FILE MANAGEMENT
ONLY

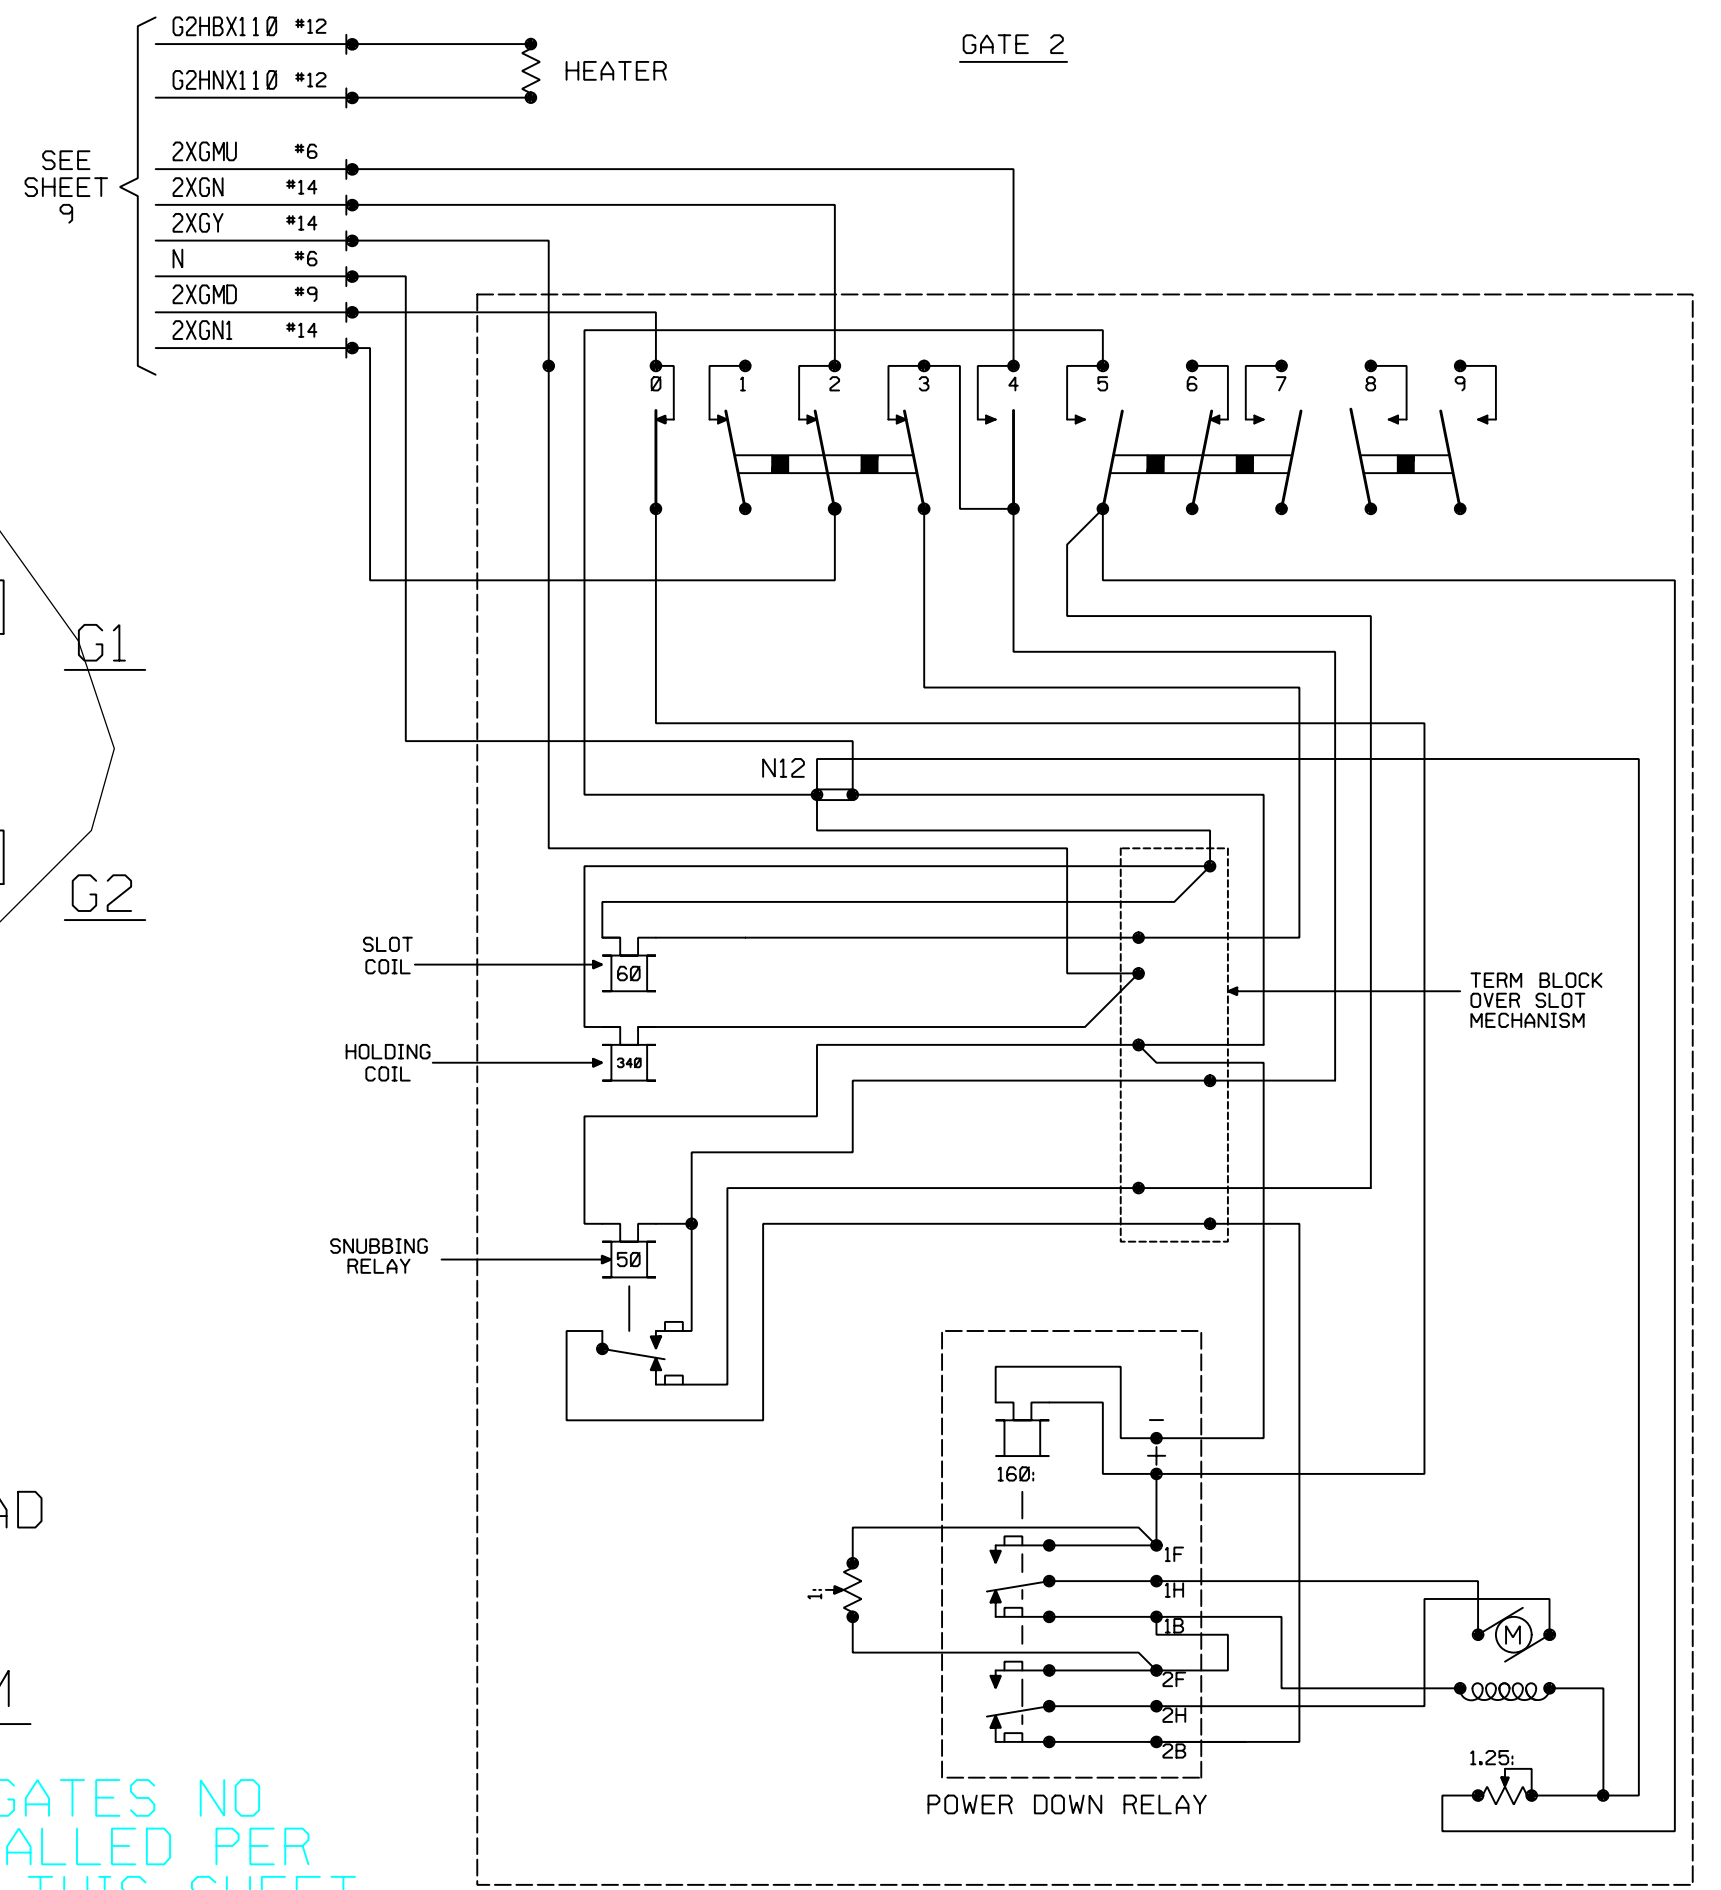

(SEE NOTE FOR G2)

CIRCUIT CONTROLLER FUNCTIONS			
SPACE NUMBER	USE OF CONTROLLER	CONTACT OPERATION	
		CONTACT CLOSED	CAM DRIVES CONTACT
0	TO OPEN MOTOR CIRCUIT DOWN	46° TO 93°	OPEN
1	SPARE	86° TO 93°	CLOSED
2	TO CONTROL OF RELAY XGNR	86° TO 93°	CLOSED
3	TO PULL SLOT MAGNET	86° TO 93°	CLOSED
4	TO CUT OFF MOTOR AFTER GATE HAS CLEARED	0° TO 89° 83° TO 0°	CLOSED
5	TO CLOSE HEAVY SNUB CIRCUIT AS GATE ARM APPROACHES HORIZONTAL	0° TO 10°	CLOSED
6	TO OPEN BELL CIRCUIT WHEN GATE IS HORIZONTAL	5° TO 93°	OPEN
7	SPARE	0° TO 5°	CLOSED
8	SPARE	0° TO 89°	OPEN
9	SPARE	0° TO 89°	OPEN

NOTES:

WIRES BETWEEN BATTERY AND GATE MOTOR SHALL NOT BE SMALLER THAN NO. 6 A.W.G. WHERE TOTAL LENGTH OF WIRE IN CIRCUIT, BATTERY, AND COMMON SIDE, EXCEEDS 120' USE NO. 6 A.W.G. OR EQUIVALENT UP TO 240'.

THE FOLLOWING NUMBER OF CELLS ARE RECOMMENDED:

GATE ARM LENGTH IN FEET	NO. OF LEAD TYPE CELLS	NO. OF NICKEL-IRON TYPE CELLS
UP TO 24	6	10
25 TO 34	7	11

MECHANISMS SHOWN FOR GATE ARMS IN VERTICAL POSITION. EACH HIGHWAY GATE TO BE WIRED SAME AS SHOWN, EXCEPT FOR LIGHTS (SEE DIAGRAM G2). SIDEWALK ARMS ON HIGHWAY GATES TO HAVE STEADY-LIT LIGHT. 2XGNI IN G2 WILL BECOME B12.

THIS SHEET
VOID ON PROJECT
COMPLETION
DATE: 10-20-2015
NS PROJ.#
NS/WDM

REV	DATE	CKD BY

C&S CAD


**NORFOLK SOUTHERN**

UNION AVENUE / REPEATER 67.7ALLIANCE, OHIO


HIGHWAY CROSSING - REPEATER
WRRS MODEL 10 TYPE 3564 GATE CIRCUITS

ISSUE DATE: APRIL 3, 1998	2412-0677
REV. 3	09-04-13
SHEET 10	


24120677.10AV

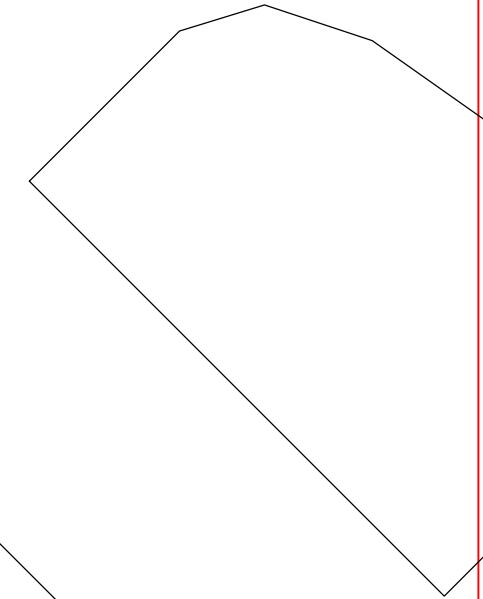

DATE: 10-20-2015
NS PROJ.#
NS/WDM

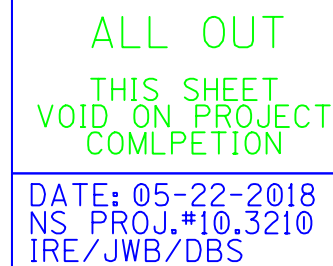


"A" FLASHER AND GATE LIGHTS WITH MODEL "S40" GATE MECHANISM

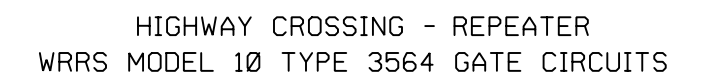


24120677.10V

C&S CAD

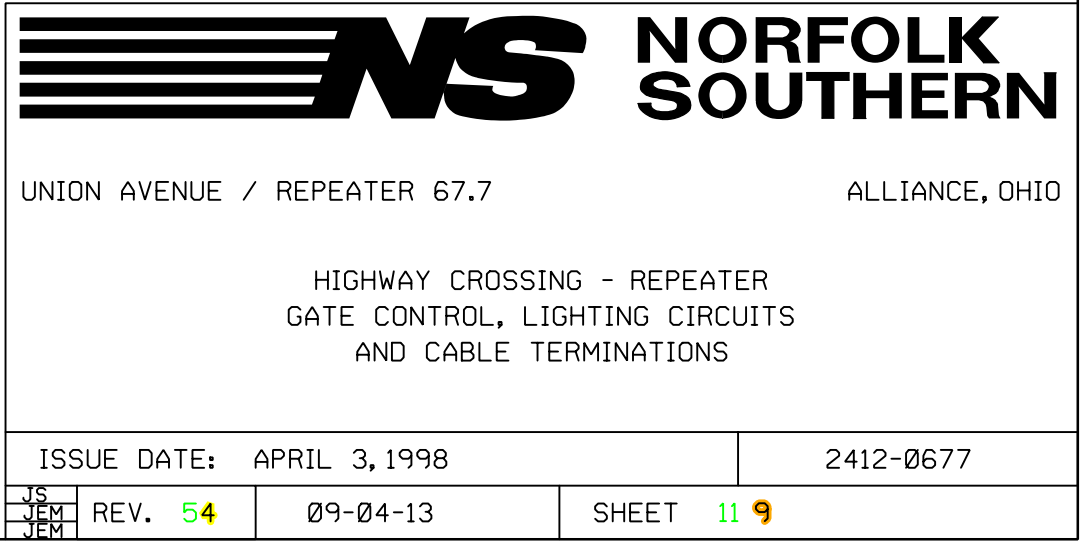


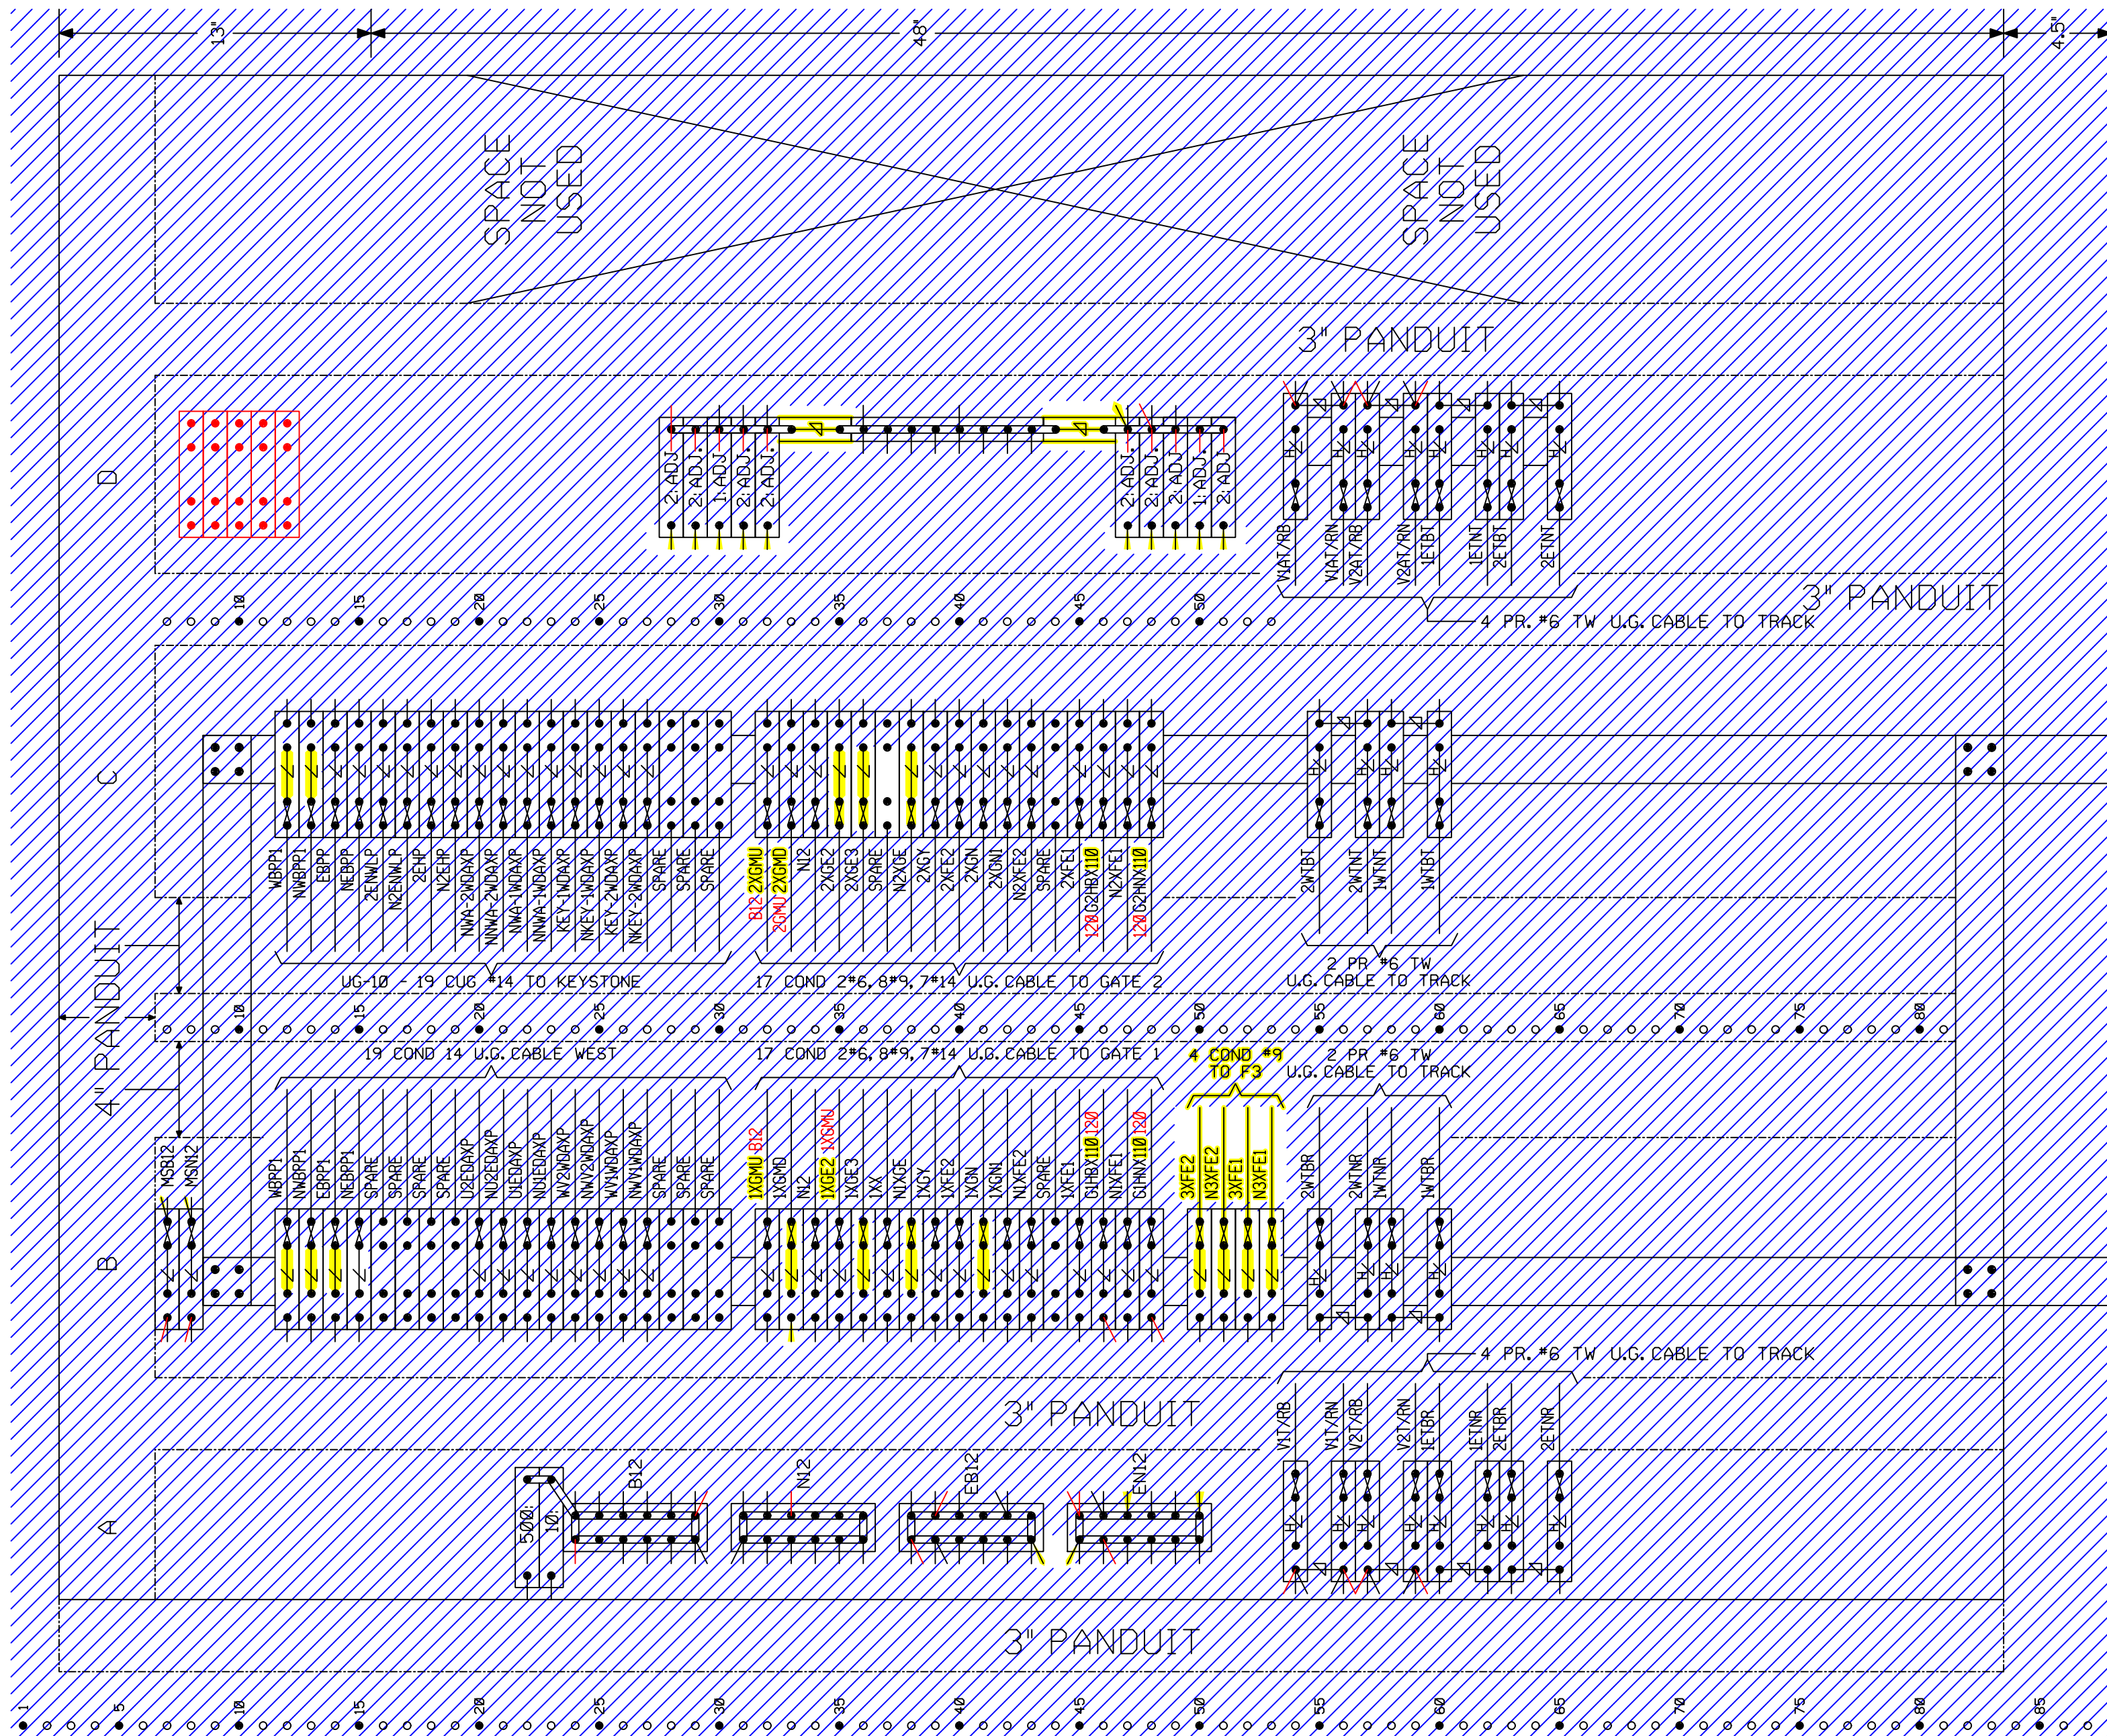

NOTES:

- | | |
|-----------|--|
| 1.FIXED | 02-423547 - RESISTOR |
| 1.ADJ. | 02-425799 - RESISTOR |
| 2.ADJ. | 02-425807 - RESISTOR |
| 5.ADJ. | 02-422754 - RESISTOR |
| 10.FIXED | SAFETRAN 029245-3X - RESISTOR |
| 22.FIXED | 02-425849 - RESISTOR |
| 100.FIXED | 02-423646 - RESISTOR |
| 500.FIXED | 02-423711 - RESISTOR |
| | 02-036133- 4 POST PORCELAIN BASE |
| | 02-037057 - 3 POST PORCELAIN BASE |
| | 02-050753 - TERMINAL BLOCK FOR EQUALIZER |
| | 02-048757 - TERMINAL STRIP |
| | 02-150009 - BUSS LINK |
| | 02-286662 - TEST LINK ASSEMBLY |
| | 02-025920 - ARRESTER, HEAVY DUTY, WITH BASE |
| | 02-026613 - ARRESTER, HEAVY DUTY, WITHOUT BASE |
| | 02-025565 - ARRESTER |
| | 02-197950 - EQUALIZER |
| | GROUND CONNECTION TO BE IN ACCORDANCE WITH STANDARD PLAN CS-9001-A |

ALL RED AND YELLOW
CHANGES ARE DRAFTING
CORRECTION ONLY PER
FIELD SURVEY
ALL REDRAWN
ON NEW SHEET 14

/// = SHOWN
ELSEWHERE
RED = IN
YELLOW = OUT
THIS SHEET
VOID ON PROJECT
COMPLETION
DATE: 10-20-2015
NS PROJ.#
NS/WDM



UNION AVENUE / REPEATER 67.7

ALLIANCE, OHIO

HIGHWAY CROSSING - REPEATER
TERMINAL BOARD ARRANGEMENT

ISSUE DATE: APRIL 3, 1998			2412-0677
REV. 43	09-04-13	SHEET 13	

24120677.13V



POR 1● 2● 3● 4● 5● 6● ✱	EOR	XPR	XGNR	XGNPR	1-2 GCPR	BPR	XGMR
	A62 195	A62 262	A62 205	A62 353	A62 262	A62 262	A62 406
	02- 411526	02- 411583	02- 411682	02- 411609	02- 411583	02- 411583	02- 395489
W BPPR	E BPPR	NWA-1W DAXR	NWA-2W DAXR	KEY-1W DAXR	KEY-2W DAXR	UZE DAXPR	UIE DAXPR
A62 262	A62 262	A62 262	A62 262	A62 262	A62 262	A62 262	A62 262
02- 411583	02- 411583	02- 411583	02- 411583	02- 411583	02- 411583	02- 411583	02- 411583
WV2W DAXR	WV1W DAXR	2E HR	2E NWLPR	3-4 GCPR			
A62 262	A62 262	A62 262	A62 262	A62 262			
02- 411583	02- 411583	02- 411583	02- 411583	02- 411583			

POR HD12- EBX HD15- ENX HD22- EBX HD25- ENX HD32- EBX HD35- ENX	EOR HD12- EX HD15- EX HD32- EX HD35- EX	XPR 12- 15- XGN 22- XGM 25- 32- 35- B12 1XX DRAFTING CORRECTION	XGNR 13-HD-EBX 15-HD-EBX 32-E0 35-XGNP
XGNPR 22-XGM 25-	BPR 12- WBPP 15- NWBPP 22- EBPP1 25-NEBPP1 32- 35-	XGMR HD12- B12 HD15- N12 B12 HD22- B12 HD25- N12 B12 HD32- HD35-	1-2 GCPR 12- XP 15- 22- 25- 32- 35-
KEY-2W DAXR 12- KEY-2WDAXP 15- NKEY-2WDAXP 22- 25- 32- 35-	KEY-1W DAXR 12- KEY-1WDAXP 15- NKEY-1WDAXP 22- 25- 32- 35-	U2E DAXPR 12- UAX2 15- 22- 25- 32- 35-	U1E DAXPR 12- UAX1 15- 22- 25- 32- 35-
2E NWLPR 12- 15- 2EAUX 22- 2EHP 25- N2EHP 32- 35-	2E HR 12- 2EHP 15- N2EHP 25- 32- 35-	WV2W DAXR 12- WV2WDAP 15- NWV2WDAP 22- 25- 32- 35-	WV1W DAXR 12- WV1WDAP 15- NWV1WDAP 22- 25- 32- 35-
NWA-2W DAXR 12- NWA-2WDAXP 15- NNWA-2WDAXP 22- 25- 32- 35-	NWA-1W DAXR 12- NWA-1WDAXP 15- NNWA-1WDAXP 22- 25- 32- 35-	3-4 GCPR 12- XP 15- 22- 25- 32- 35-	W BPPR 12- 15- 2WUAX 22- 25-1WUAX 32- 35-



		NORFOLK SOUTHERN
ISSUE DATE: APRIL 3, 1998		2412-0677
JVS JEM	REV. 43	09-04-13
		SHEET 1411


!! WALLS VIEW FROM (INSIDE) REAR OF APPARATUS ENCLOSURE !!

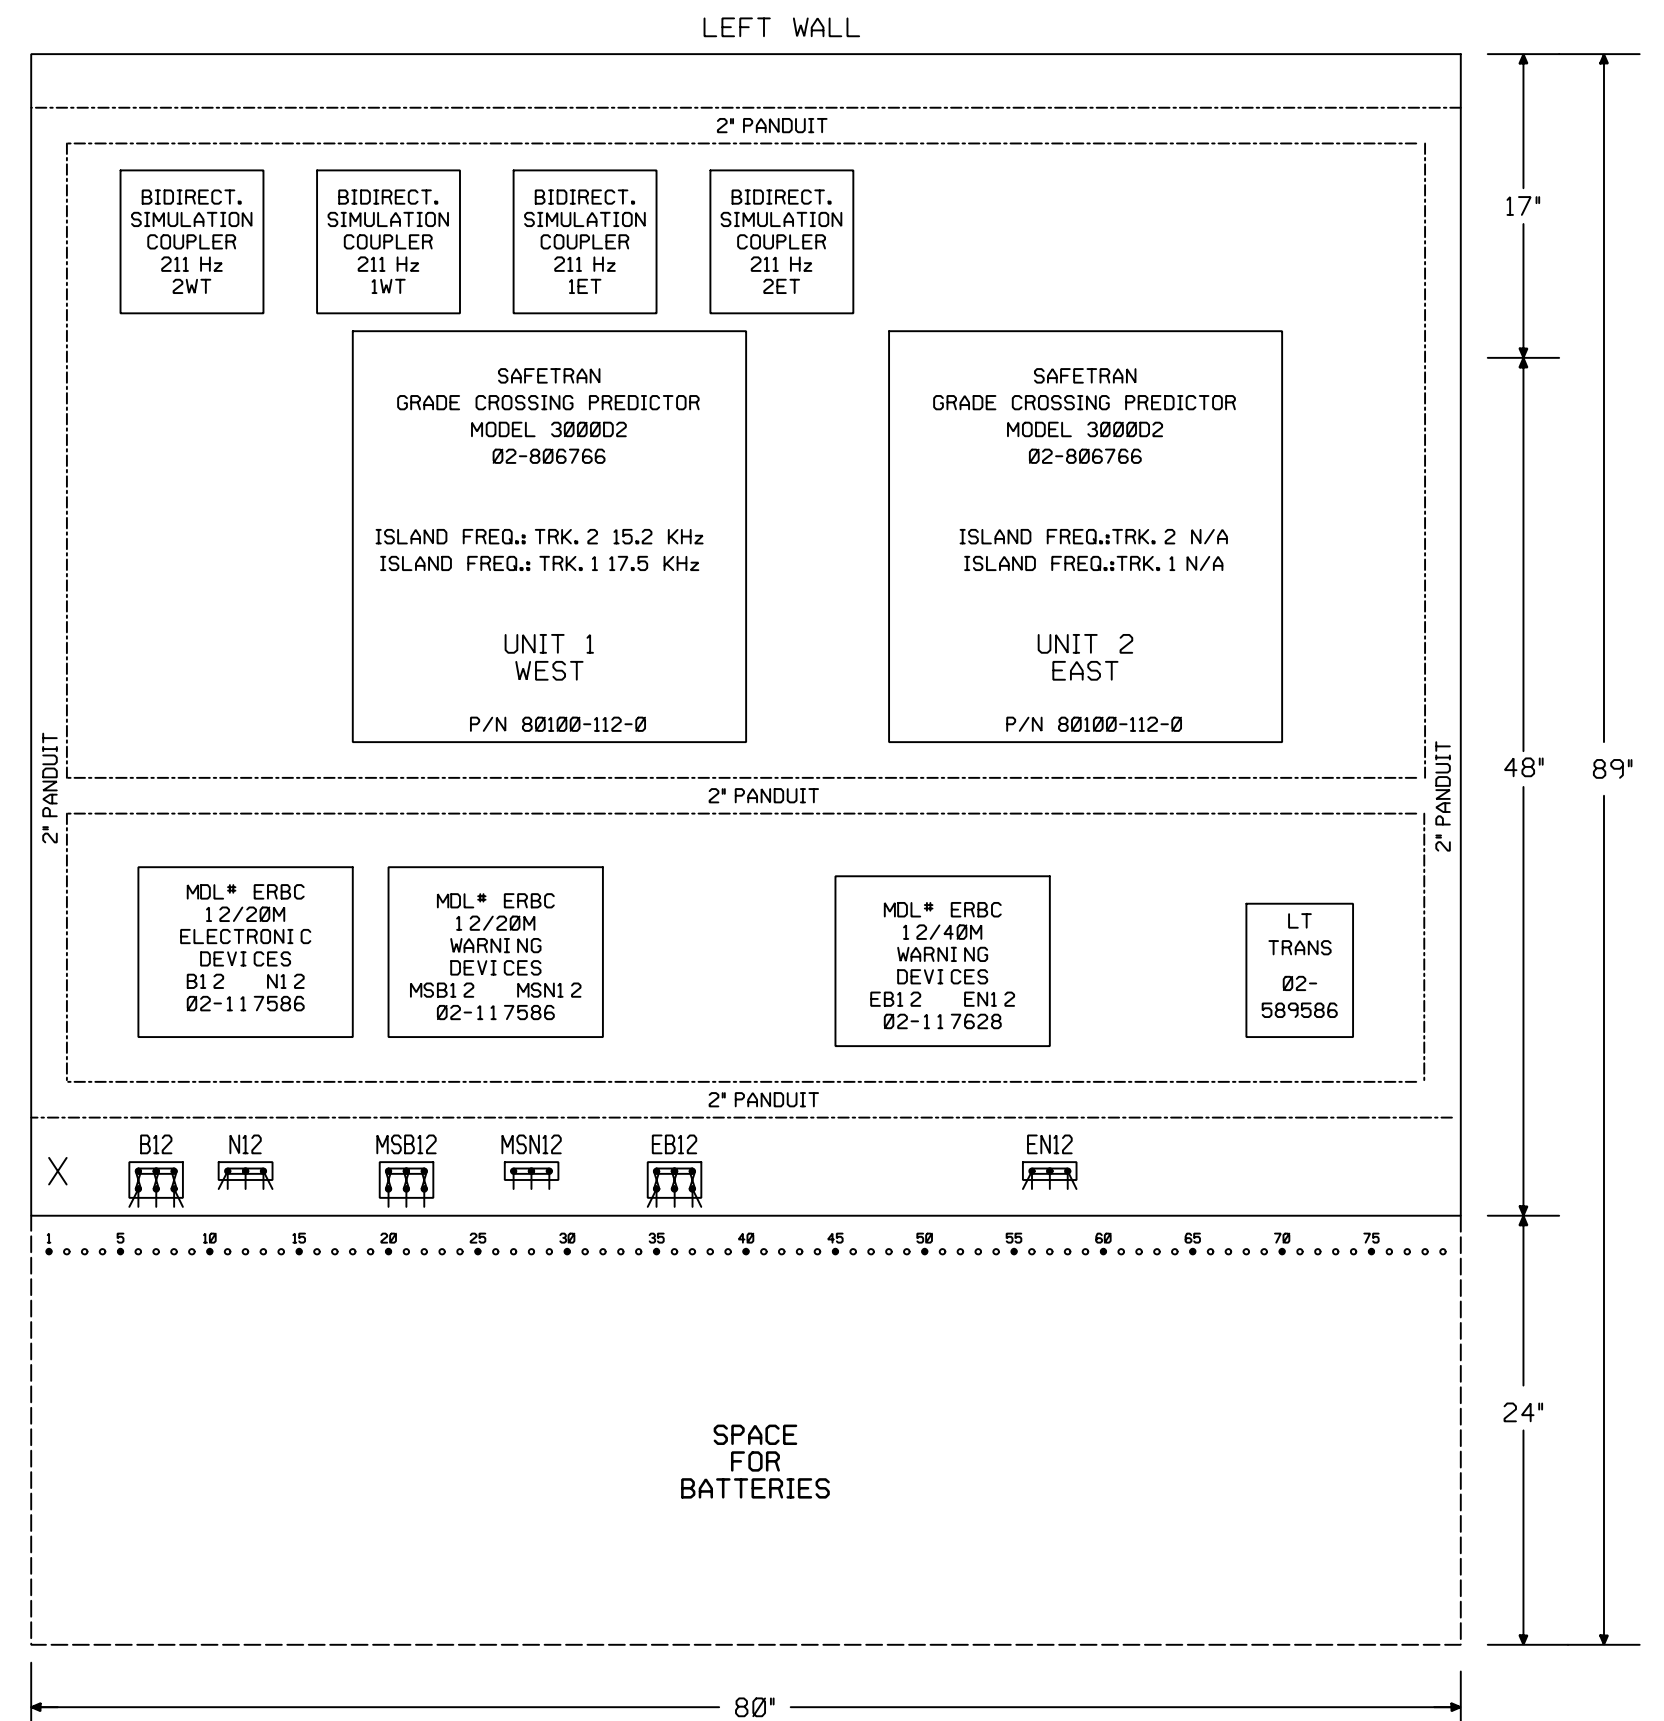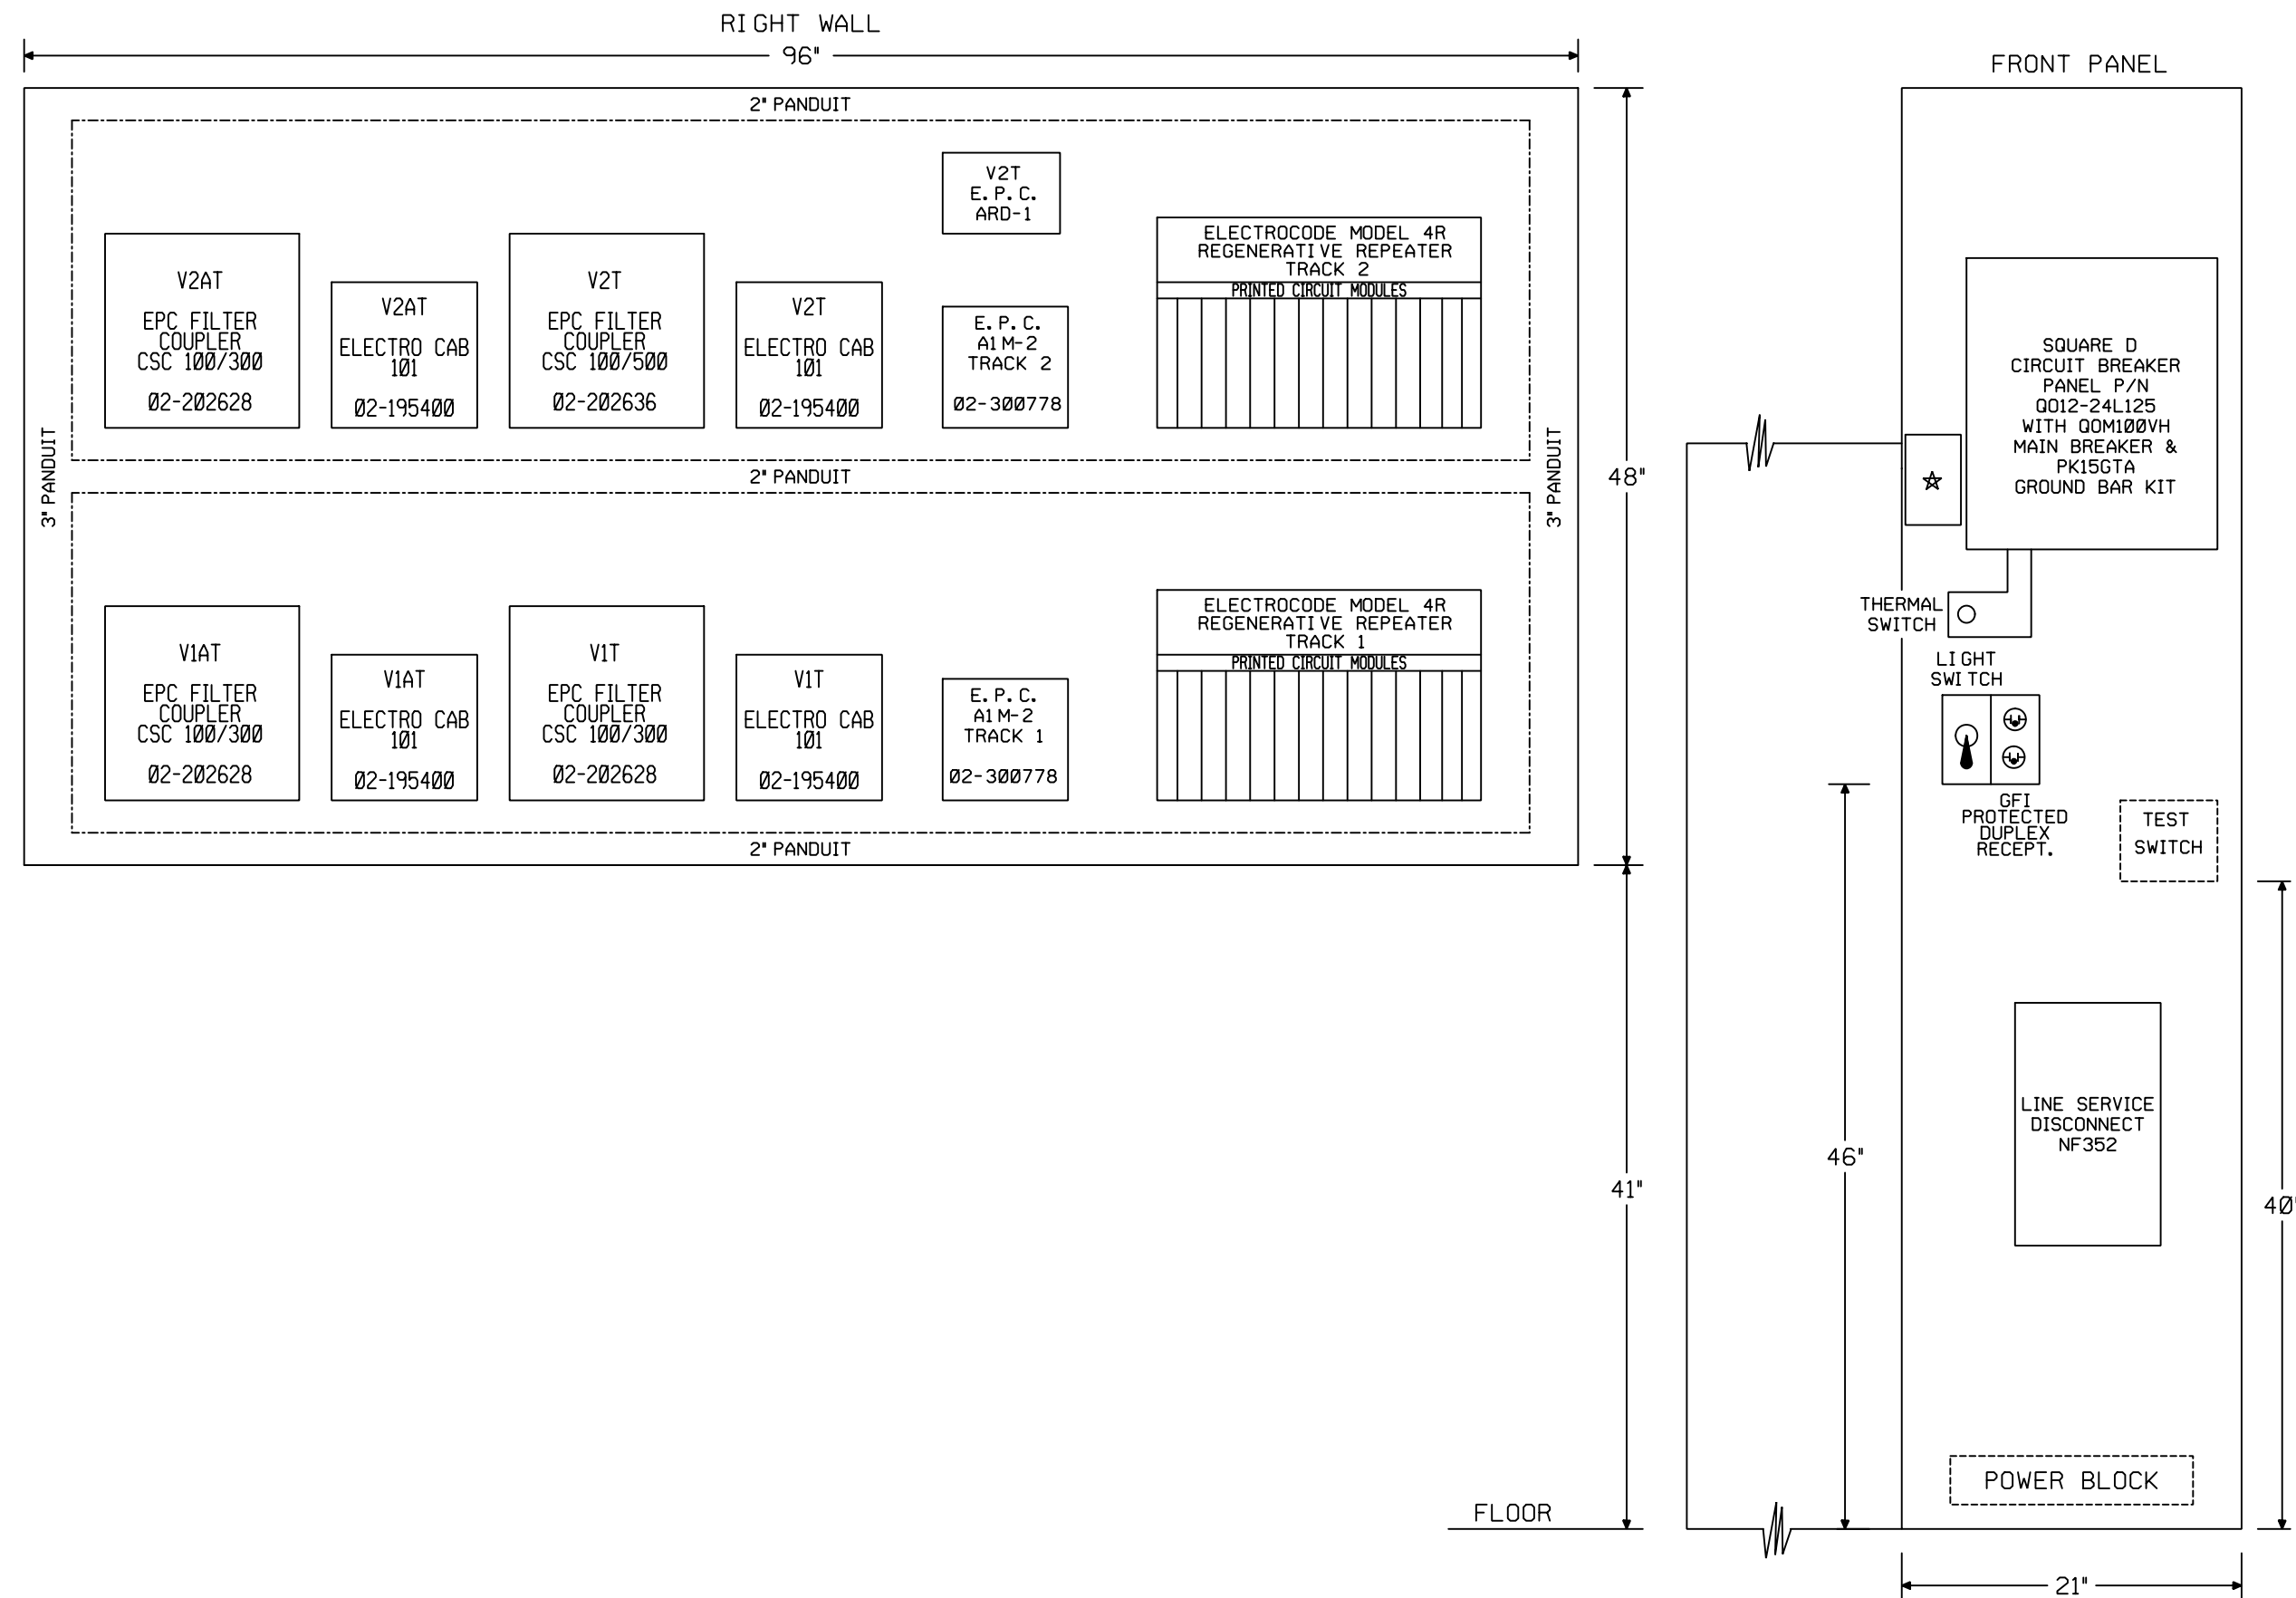


PER EXISTING PLANS IN FIELD
CHANGES WHERE MADE TO CIRCUITS
CHANGES WHERE NOT SHOWN
FIELD VERIFY CIRCUITS
AND MARK CHANGES FOR A.I.S.

RED = IN
YELLOW = OUT


DATE: 10-20-2015
NS PROJ.#
NS/WDM

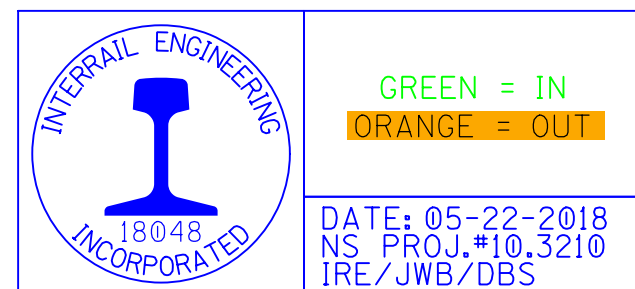

☆
JOSLYN
SURGE
SUPPRESSOR
#1265-41
OR
ERICO
EPD 120/240
02-375705
SUPPRESSOR TO BE LOCATED
AS CLOSE AS POSSIBLE TO
BREAKER BOX. LEADS TO BE
TWISTED WHENEVER POSSIBLE.

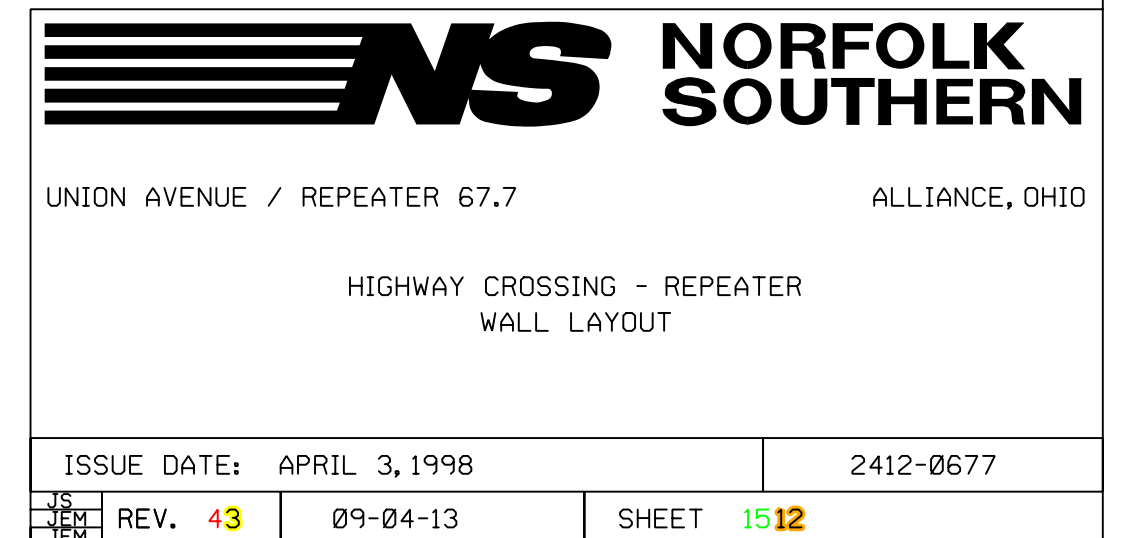

4120677.15
4120677.12

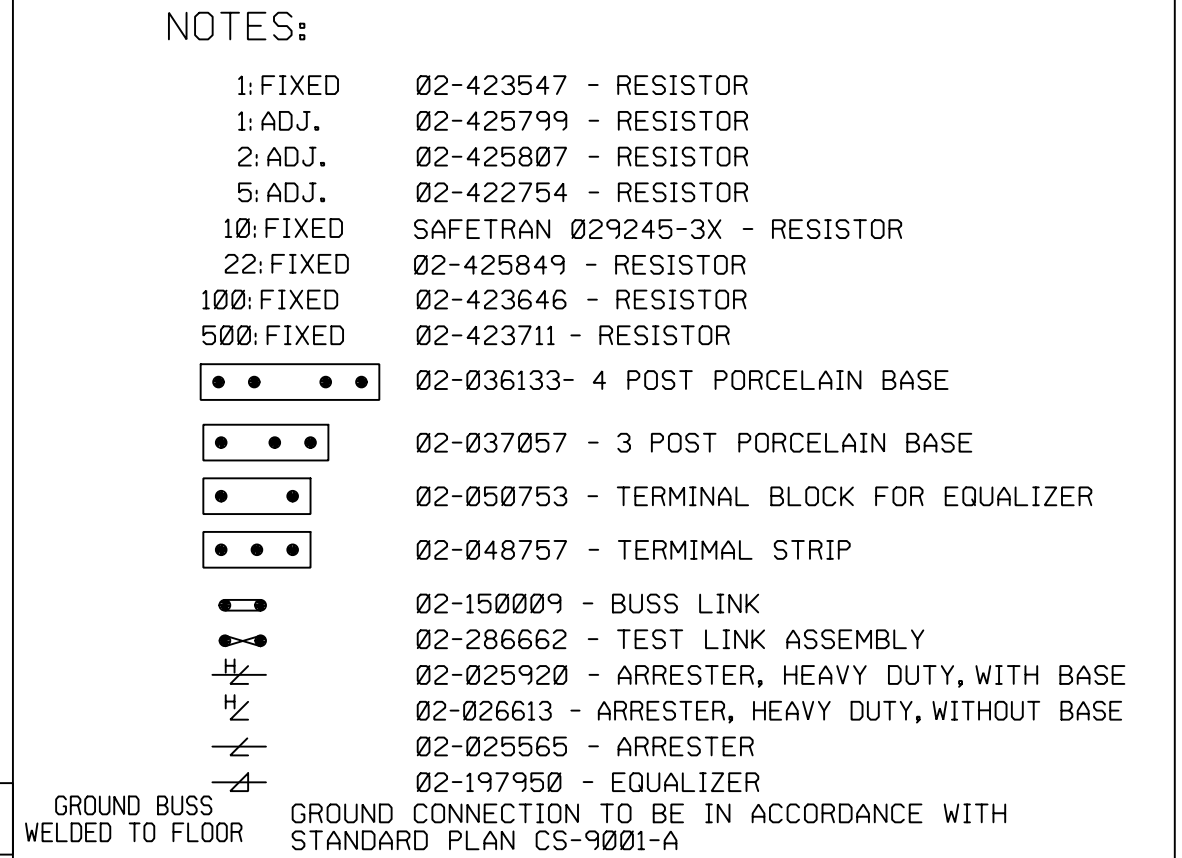

GROUND BUSS
WELDED TO FLOOR



UNION AVENUE / REPEATER 67.7

ALLIANCE, OHIO

HIGHWAY CROSSING - REPEATER
TERMINAL BOARD ARRANGEMENT

ISSUE DATE: APRIL 3, 1998

2412-0677

JS	REV. 54
JEM	
JEM	

09-04-13

SHEET 1613

24120677.16
24120677.13



OHIO RAIL DEVELOPMENT COMMISSION

Mail Stop #3140, 1980 West Broad Street, Columbus OH 43223

John R. Kasich, Governor • Mark Policinski, ORDC Chairman

February 22, 2018

Mr. Stephen J. Klinger
Norfolk Southern
Administrator Grade Crossing Program
1200 Peachtree Street NE, Box 123
Atlanta, Ga. 30324

RE: Stark County-SR225/Union Ave. DOT# 503-013S,
PID# 106855. Warning Device Improvements

Dear Mr. Klinger:

A diagnostic review was held at the above grade crossing on August 11, 2017. The crossing has been recommended for L.E.D and equipment upgrades. Norfolk Southern (NS) is authorized to proceed with the site plans and cost estimates (PE) or bid package for this project. This authorization is made with the stipulation and understanding that any field work needs prior approval before work begins. This authorization is made with the stipulation and understanding that an approved estimate may contain entries for items or activities that may be cited and found to be ineligible for federal participation during the project audit.

The diagnostic review form is attached. Please note any recommendations (page 1), if any, made by the team with regard to requirements for this location. Any minor roadway work necessary for MUTCD compliance should be incorporated into the PE and such costs will flow through the railroad reimbursement process.

The Project Manager for this project is James Tucker. James can be reached at (614) 398-6897, or james.tucker@dot.ohio.gov, if you have any questions.

Sincerely,

Project Manager

C: Randall Schumacher, Supervisor, Rail Division, PUCO
Jill Henry, Grade Crossing Planner, PUCO
Susan Arduini, ORDC
ORDC (file)

Attachment: 1 (diagnostic review form)




www.rail.ohio.gov

phone: 614.644.0306

IMPROVING RAIL TODAY FOR TOMORROW'S ECONOMY

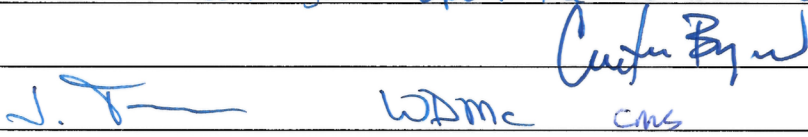

High Hazard Crossing With Active Warning Devices			
Street Name: SR 225-0.19 Union		County: STA	
LHA: City of Alliance		USDOT#: 503013S	
Nearest City: Salem		Hazard Rank: 3	
Roadway Information			
ADT: 10900 (2006)		Posted Speed Limit:	
Railroad: Norfolk Southern		Number of Tracks: 2	
Train Count: 26 ⁺ 62-65		Speed Over Crossing: 40	
Storage Distance (Ft.): Not Listed		Train Detection Type: CD/AFO GCP-3000 Predictor	
Accidents			
Accident Factors		4 # of Accidents in Last 5 Years:	
		0 # of Fatalities in Last 5 Years:	
Accident Date	2/27/17	1/17/17	11/12/15
Position of Accident	Stalled on crossing	Stalled on crossing	Stalled on crossing
Circumstance			
Visibility/Time of Day	Dark	Dawn	Dark
Weather Conditions	Clear	Rain	Rain
Crossing Interconnect.	Yes	Yes	Yes
Crossing Illuminated	Yes	Yes	Yes
Drove Around Train			
Highway User Action	Stopped on crossing	Stopped on crossing	Stopped on crossing
Alcohol/Drug Related?			
Driver Speeding?			
Other Notes: 2/27/17: NS train struck a hwy user. 1/17/17: NS train struck a hwy user. 11/12/15: NS train struck a hwy user.			
Recommendations: full LED upgrade to both Quads. Also replace the existing gate mech's with new. There ^{will} be sidewalk work included contingent upon the Norfolk Southern design.			
			
City would like to be sure that the sidelights for Perry Street are aimed correctly.			

Existing Traffic Control Devices

Type of Warning Devices	Installed?		Quantity/Comments
Advance Warning Signs (condition?)	☒ Yes	☐ No	
'Stop' Signs	☐ Yes	☒ No	at crossing no, but SR 193 has one along with Perry St.
'Stop Ahead' Signs	☐ Yes	☒ No	
Pavement Markings (condition?)	☒ Yes	☐ No	faded
Crossbucks	☒ Yes	☐ No	3
Number of Tracks Signs	☒ Yes	☐ No	
Inventory Tags	☒ Yes	☐ No	
Interconnected Highway Traffic Signal	☐ Yes	☒ No	
Mast-Mounted Flashing Lights	☒ Yes	☐ No	
Cantilever Flashing Lights	☒ Yes	☐ No	Number: Length:
Side Lights	☒ Yes	☐ No	
Automatic Gates	☒ Yes	☐ No	Number: 2 Length:
Bells	☒ Yes	☐ No	Number: 1
Sidewalk Gate Arms	☐ Yes	☒ No	
'No Turn' Signs	☐ Yes	☒ No	
Illumination	☒ Yes	☐ No	
Is crossing flagged by train crew?	☐ Yes	☒ No	
Other	☐ Yes	☐ No	

Railroad Data

Railroad Characteristics	Initial Information (from database)	Revised
Total trains per day	26	62-65
< 1 per day		
Day thru trains	9	31
Night thru trains	9	31
Daytime switching movements	4	0
Nighttime switching movements	4	0
Total number of tracks	2	
Number of main tracks	2	
Number of other tracks		
Maximum train speed	40	
Typical train speed	40	
Amtrak	40	
If multiple tracks, can two trains occupy crossing at the same time? ☒ Yes ☐ No Can one train block the motorists' view of another train at crossing? ☒ Yes (Explain below) ☐ No Can one or more tracks be eliminated through the crossing? Yes ☒ No		
Are there other track(s) crossing this same roadway within 100 ft of this crossing? Yes ☒ No If yes, Crossing DOT #(if different) _____ If yes, distance _____ (take measurement between track centerlines at closest point along roadway)		

Roadway Data

Local Highway Authority: City of Alliance

Roadway Characteristics	Initial Information (from database)	Revised
Average daily traffic 10900	(2006)	
Highway paved	Yes X No	Yes No
Roadway Surface: <u>Blacktop</u> Gravel Concrete Other _____		
Roadway width: ____ft.		
Number of highway lanes	2	
Urban or Rural	Urban	
Vehicle Speed: ____ MPH	25 mph	
School Bus Operation: No Yes Amount _____		LHA will get the #
Hazardous Materials Trucks: No X Yes Amount _____.06% _____		
Shoulders: <u>No</u> Yes <u>Corbed</u>		
Is the shoulder surfaced? <u>No</u> Yes		
Is there existing guardrail along roadway in crossing vicinity? <u>No</u> Yes		
Is stopping site distance adequate? (See Table 2) <u>Yes</u> No If no, deficient approach(es) _____		
Quadrant _____ Curb and Gutter: <u>Functional (Curb height = 4" or more)</u> Non-functional (Curb height = Less than 4") None	Quadrant _____ Curb and Gutter: <u>Functional (Curb height = 4" or more)</u> Non-functional (Curb height = Less than 4") None	
Pedestrians: No <u>Yes</u>		
Is sidewalk present? No <u>Yes</u>		
Is there a nearby intersection that could cause queuing over the crossing? <u>No</u> Yes If yes, Street Name _____ Distance _____ Is this intersection signalized? <u>No</u> Yes Are the signals currently interconnected with the existing crossing warning devices? <u>No</u> Yes Is there a 'Do not Stop on Track' sign? <u>No</u> Yes		
Is a roadway improvement project (e.g. widening, turn lanes, nearby new or upgraded traffic signal, sidewalk) planned at or near this location in the foreseeable future? No <u>Yes</u> If yes, Improvement type <u>mill + fill</u> Timeline/completion <u>2020</u> Lead Agency <u>LHA = Alliance</u>		
Is it the consensus of the Diagnostic Review Team that this is a potential closure project? <u>No</u> Yes Explain reasons:		

Type of Development
 Open Space Institutional
 Industrial Commercial
Residential

Location of nearby schools:

3 miles south

County: STA Route: SR 225-0.19, Union Ave.

DOT#: 503013S

Date: 8/11/2017

Potential Red Flags / Project Challenges

Traffic Signal Preemption (include traffic signal intersection name and LHA with jurisdiction over traffic signal, if known):

N/A

Crossing Consolidation or Closure:

N/A

Real Estate or ROW:

N/A

Culverts / Drainage / Ballast Conditions:

N/A

Roadway and/or Sidewalks:

Existing gate mech in SE Quad is located in the sidewalk

Circuitry (e.g. reaches out to other crossings, specific needs, etc.):

N/A


Environmental:

N/A

Other:

S03013S

Field Sketch

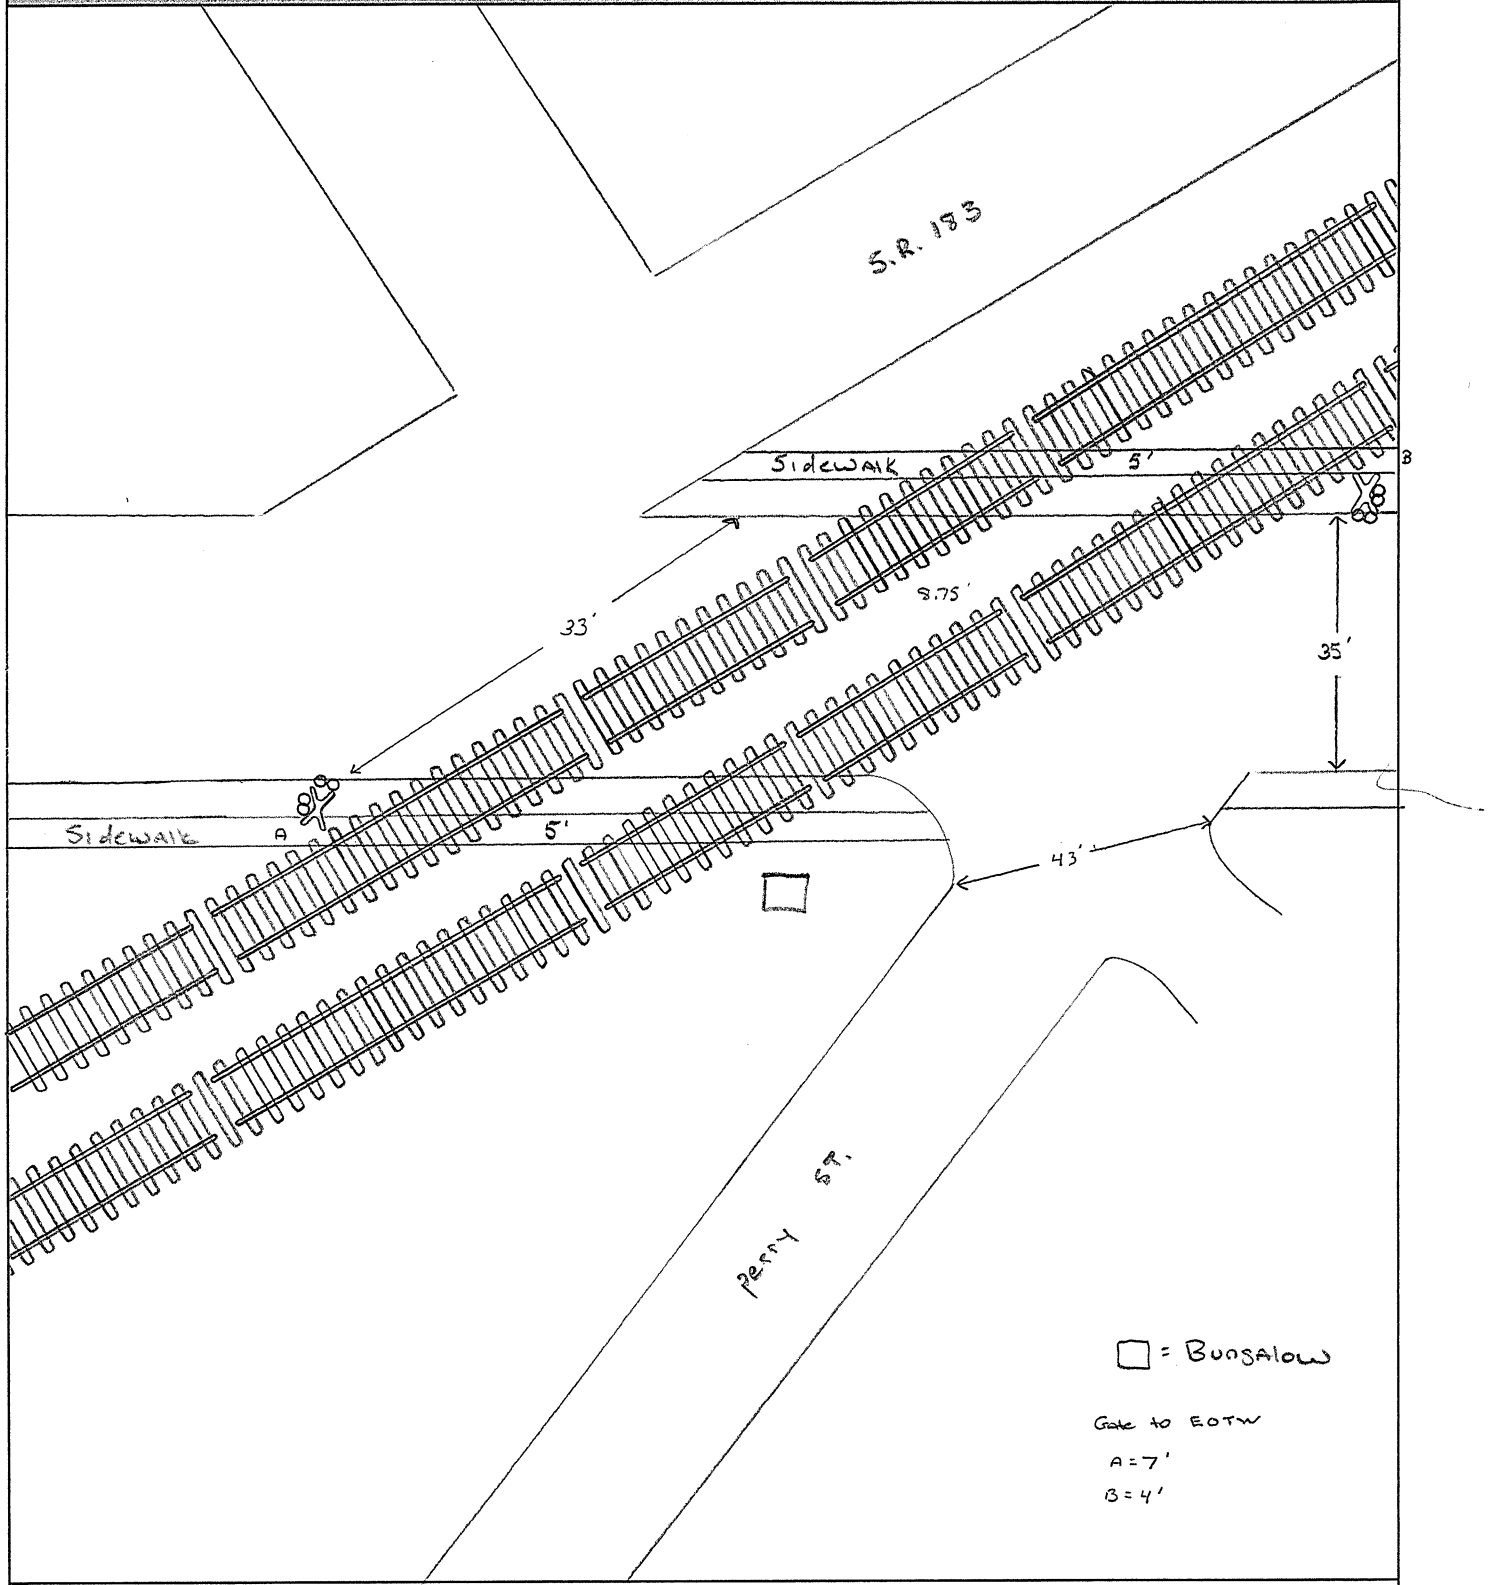

Crossing Angle ☐ 0-29° ☐ 30-59° ☐ 60-90° Measured in _____ Quadrant?

Sketch by: _____

Clearing Sight Distances

Maximum Authorized Train Speed	Distance (dT) Along Railroad from Crossing (ft)
1 - 10	240
15	360
20	480
25	600
30	720
35	840
40	960
45	1080
50	1200
55	1320
60	1440
65	1560
70	1680
75	1800
80	1920
85	2040
90	2160

Source: R-H Grade Crossing Handbook Table 36 (pp. 132-133)

Notes:

All calculated distances are rounded up to the next higher 5-foot increment.

Distances indicated are for 65-ft double bottom semi-tractor trailers and level single track 90 degree crossings; and may need to be adjusted for multiple tracks, skewed crossings or approaches on grades.

Clearing Sight Distance is to be measured in each vehicle travel direction at non-gated crossings as viewed from a point 25 feet from centerline of nearest track in the center of whichever travel lane is nearest the direction along track being measured.

Stopping Sight Distances

Highway Vehicle Speed	Distance (dH) Along Roadway from Crossing (ft)
0	n/a
5	50
10	70
15	105
20	135
25	180
30	225
35	280
40	340
45	410
50	490
55	570
60	660
65	760
70	865

Source: R-H Grade Crossing Handbook Table 36 (pp. 132-133)

Notes:

All calculated distances are rounded up to the next higher 5-foot increment.

Distances indicated are for 65-ft double bottom semi-tractor trailers on dry level pavements.

Stopping Sight Distance is to be measured on each roadway approach to crossing from stop bar.

Diagnostic Review

(COL – CR 444A, S. Lincoln Ave. DOT # 502876E)

8/11/2017

Please print:

[illegible]

This foregoing document was electronically filed with the Public Utilities

Commission of Ohio Docketing Information System on

10/29/2018 3:37:06 PM

in

Case No(s). 18-1616-RR-FED

Summary: Application In the Matter of a Request for Upgrades to the Active Warning Devices at the Norfolk Southern Railway Crossing, Union Avenue DOT#503-013S, in Stark County, Ohio. electronically filed by Mrs. Jill A Henry on behalf of PUCO/Rail Division